

RECEIVED

MAY 05 2010

WATER RESOURCES DEPT
SALEM, OREGON

T. 23 S.


DOUGLAS COUNTY

R. 5 W.

Scale 1" = 500'

R. 1 W.

Northeast Quarter

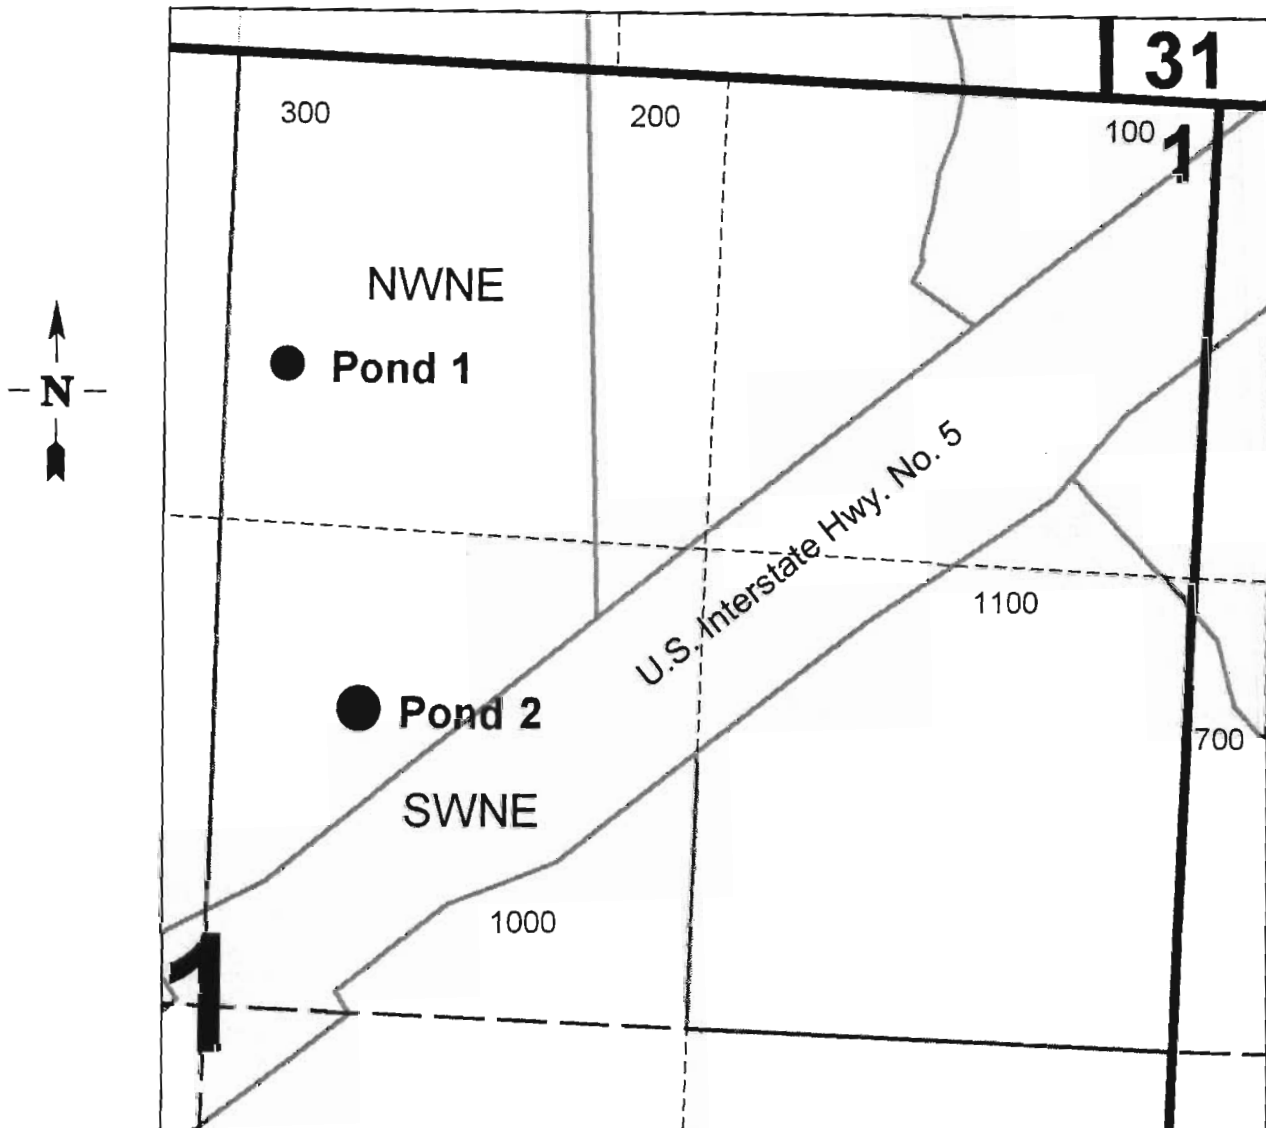

Pond 1 is located 1750 ft. N. and 150 ft. E. of the Center corner of Section 1.
Pond 2 is located 800 ft. N. and 400 ft. E. of the Center corner of Section 1.