

2 1/2" BRASS
1/4 SEC.
CORNER



LANE CO.
SURVEY
1978

1321.22

T R S TL
21S-3W 6 601

SCALE 1" = 400'



TAX LOT 601

2647.43'


1/4-1/4 SECTION LINE

2899.94'

2 1/2" BRASS
SECTION
CORNER



LANE CO.
SURVEY
1978

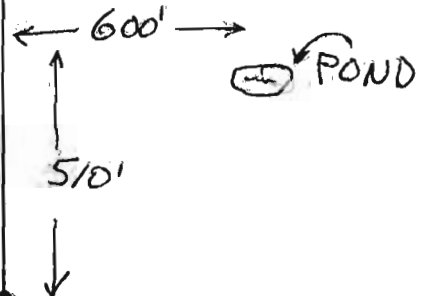

635.44'

407.22'

422.40'

298.8'

431.6'

1068.67'

370.65'

60'

KENADY LANE

RECEIVED

MAY 14 2010

WATER RESOURCES DEPT
SALEM, OREGON

VINCENT J. FOX
31255 KENADY LN.
COTTAGE GROVE, OR.
541-942-8700

R-87612