
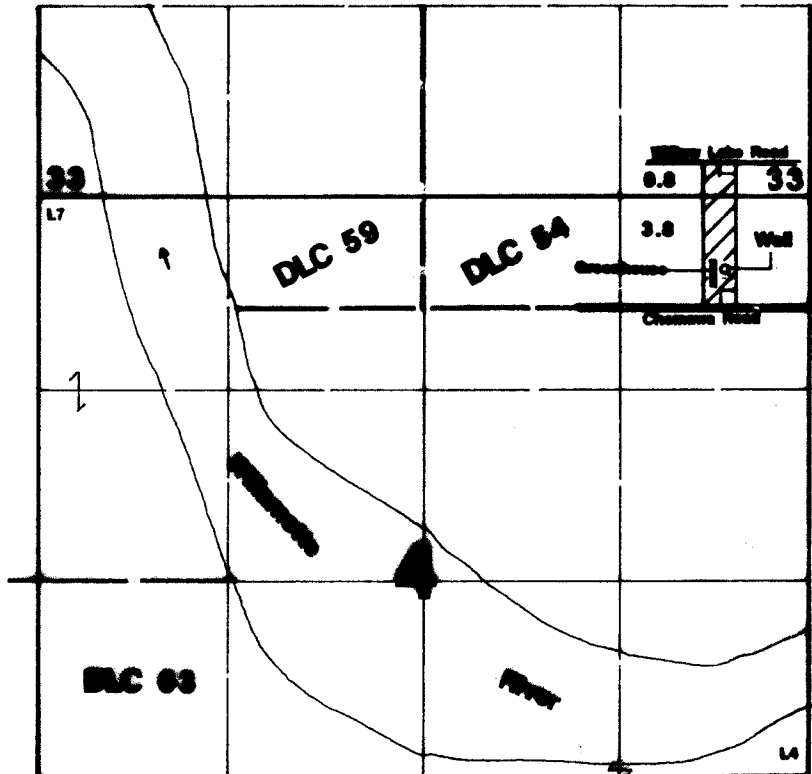


T.7S., R.3W., W.M

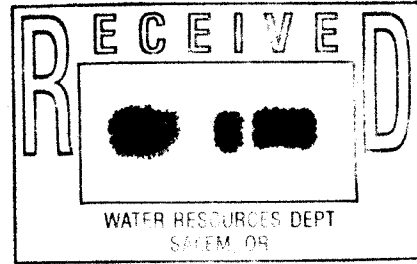

Well is located 305'S & 525'W from the NE corner of Section 4.

**Final Proof Survey**

Application: G-14764      Permit #: G-13612

In Name Of

**Larry & Dawn Monagon**

Surveyed on July 7, 2003 by JM Schutte

This Map Was Prepared For The Purpose Of Identifying The Location Of A Water Right Only And Is Not Intended To Provide Legal Dimensions Or Location Of Property Ownership Lines.

