


647581



REC'D
MAY 19 2010
SOURCES DEPT
SALEM, OREGON

Gr-17381

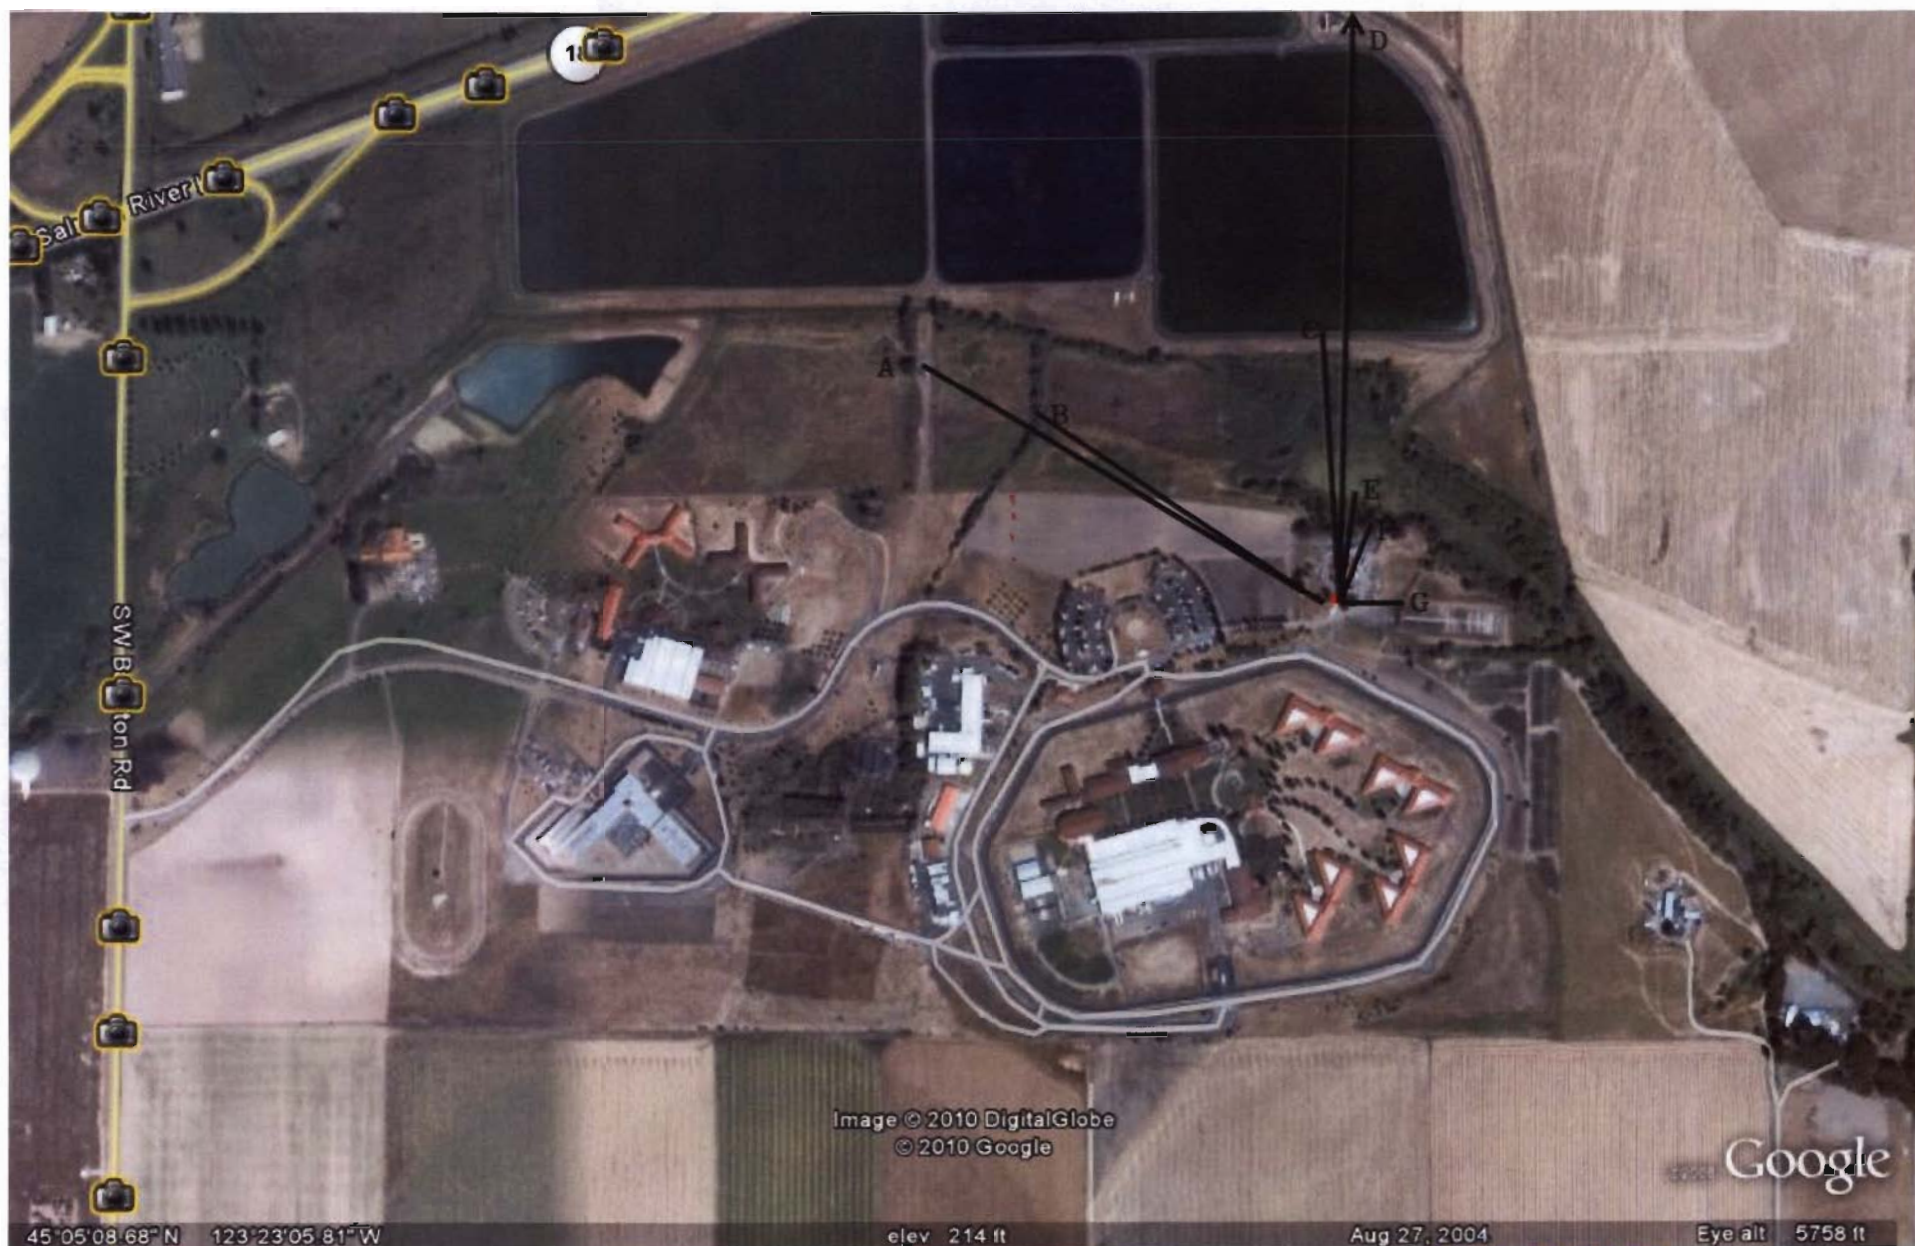

SEE LEGEND ON ATTACHED PAGE

RECEIVED

MAY 19 2010
WATER RESOURCES DEPT
SALEM, OREGON

CANCELLED
601

