


SEC.10 T.26S. 4R.W. W.M.
DOUGLAS COUNTY
Scale 1" = 1000'

RECEIVED

MAY 28 2010

WATER RESOURCES DEPT
SALEM, OREGON

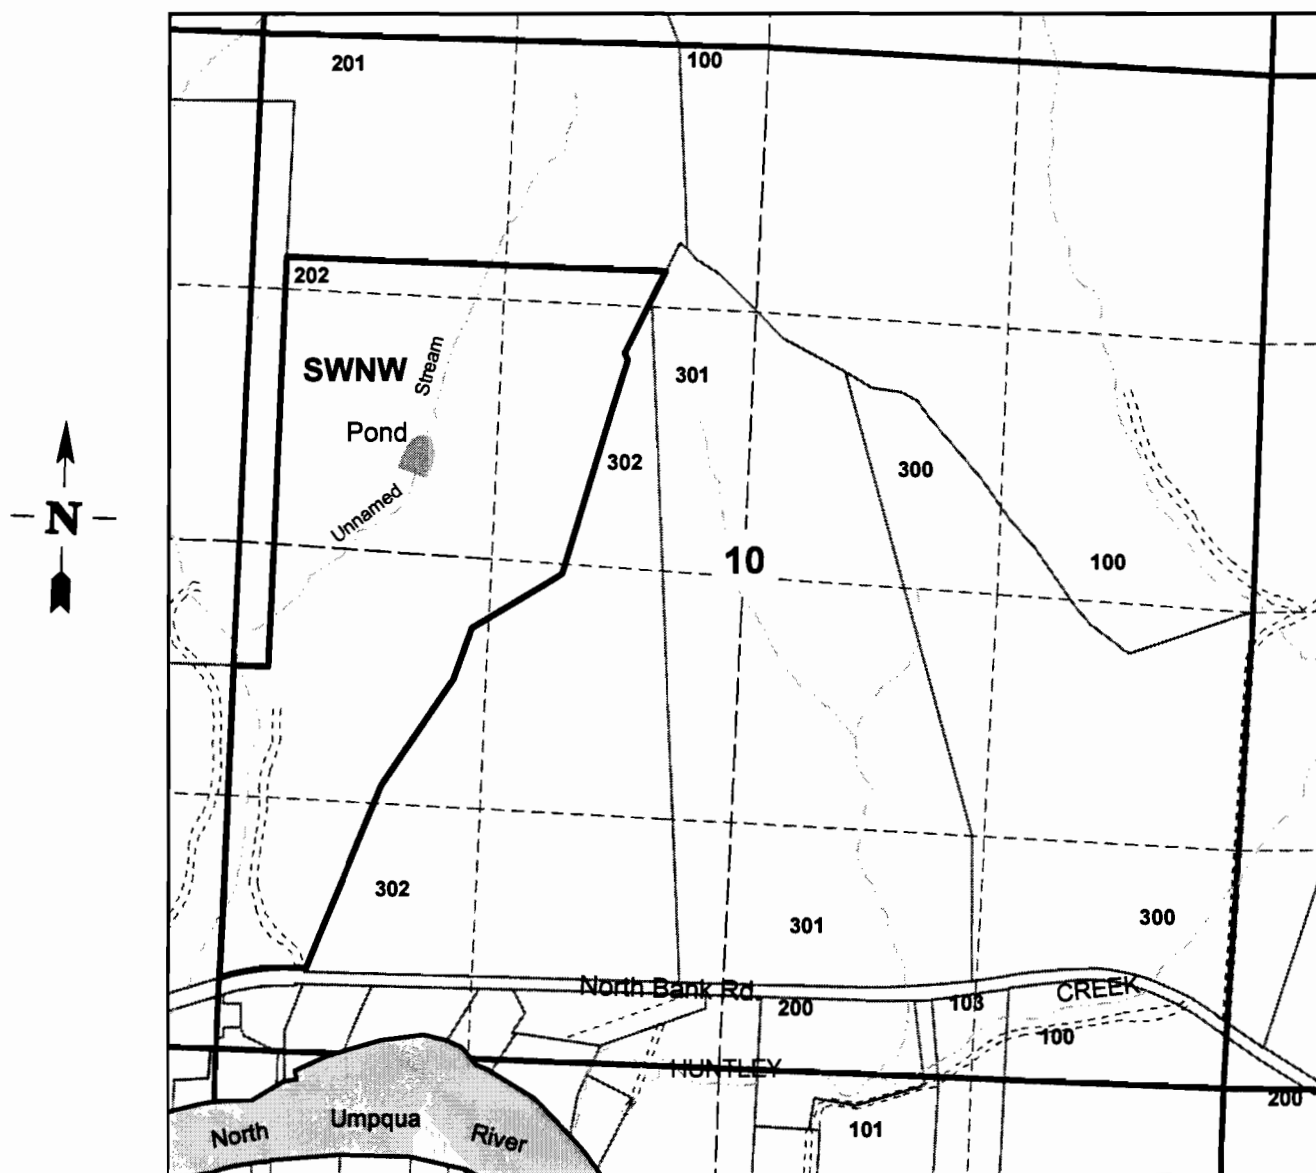

Pond is located 2,150 ft. South and 860 ft. East of
Northwest corner of Section 10.

R-87627