


T.7S. R.3W.W.M.

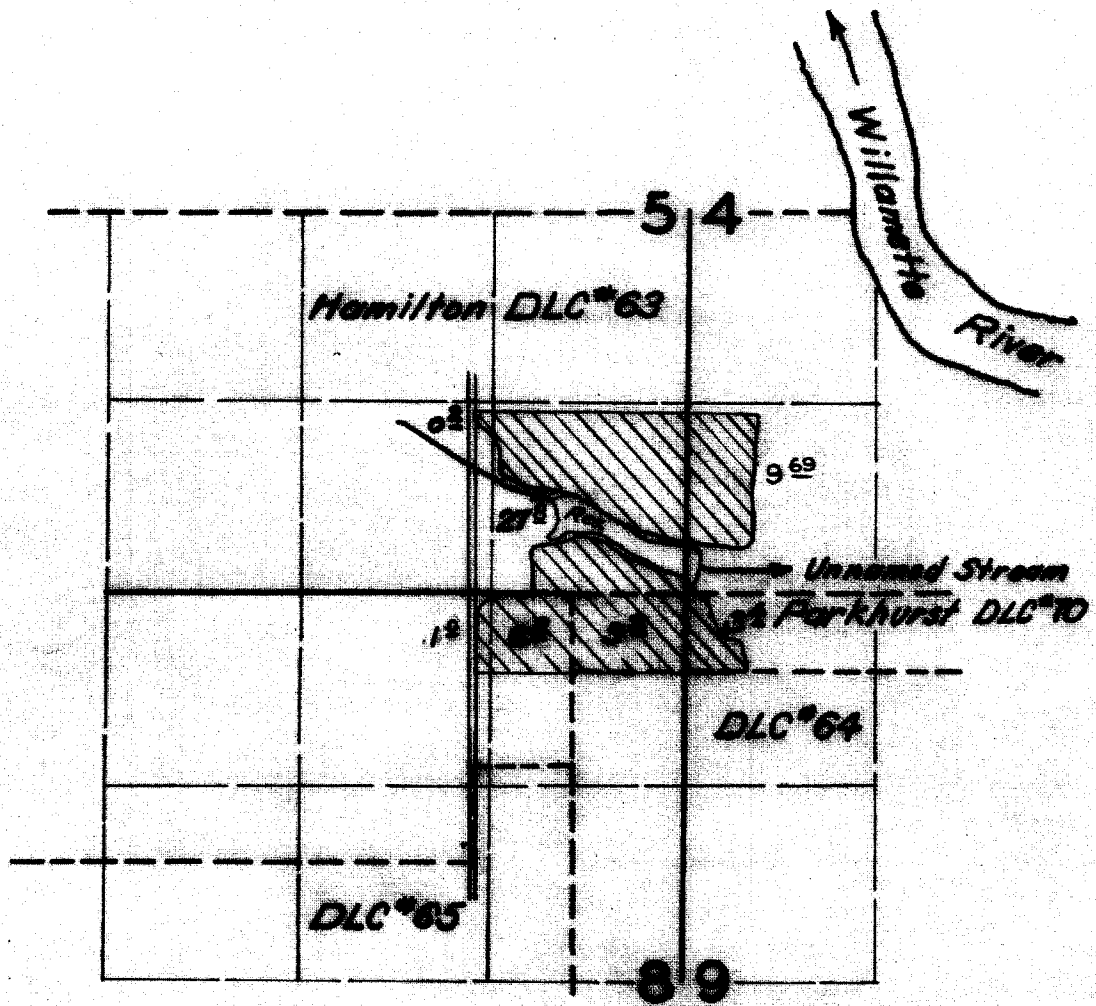

Dam Location: 160' N $\frac{1}{2}$ 100' E from SW CORNER SECTION 4

FINAL PROOF SURVEY
UNDER

Application No. R-31073 31074 Permit No. R-2002 24780
IN NAME OF

MARK GEHRING

Surveyed 25 July 1962, by Carl R. Baker