


T.23S. R.39E. W.M.
Malheur County

1 Inch = 2,000 feet

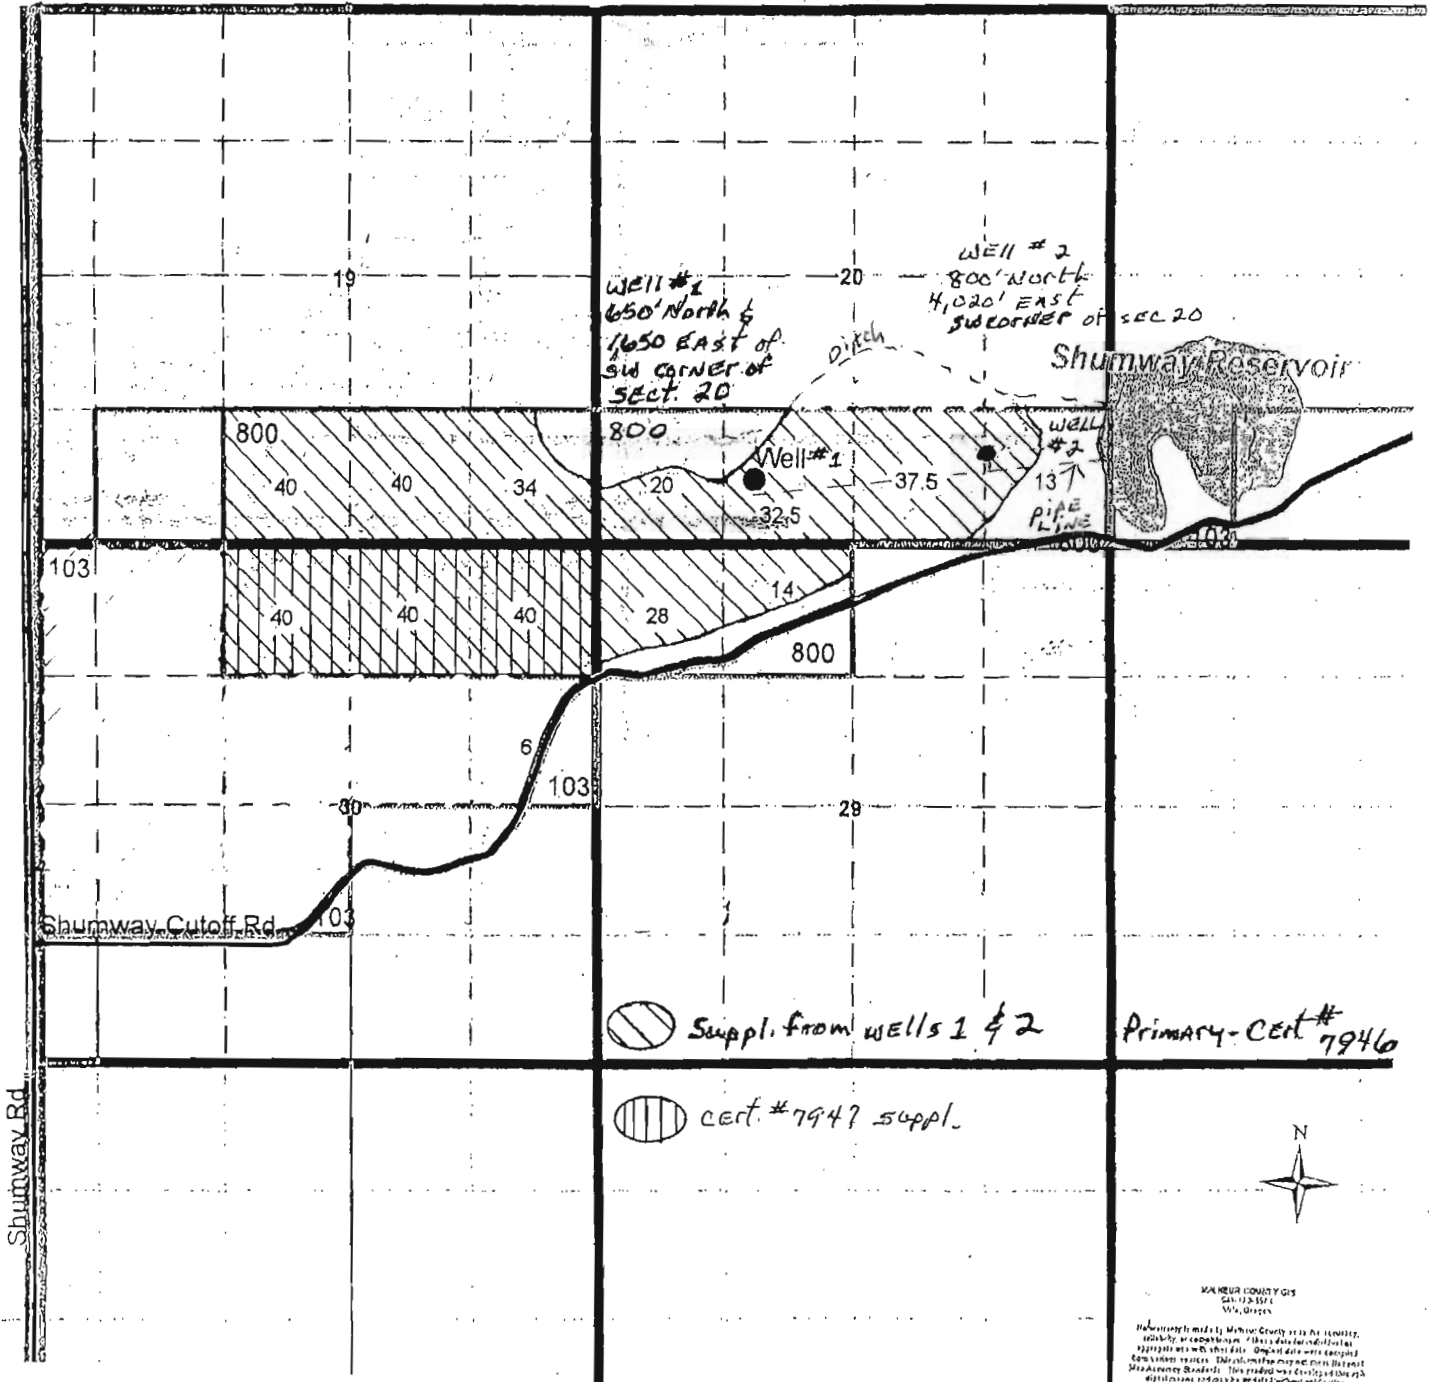

Primary - Cert # 7946



MALHEUR COUNTY GIS
 201-773-1571
 W.A. GIBSON
 This map was made by Malheur County GIS as a service to the public. It is not a legal document. It is not intended to be used as a legal document.
 Date: 10/20/09

RECEIVED

JUN 21 2010

WATER RESOURCES DEPT
 SALEM, OREGON

C-7401