


Copy

T. 7S. R. 3W.W.M.

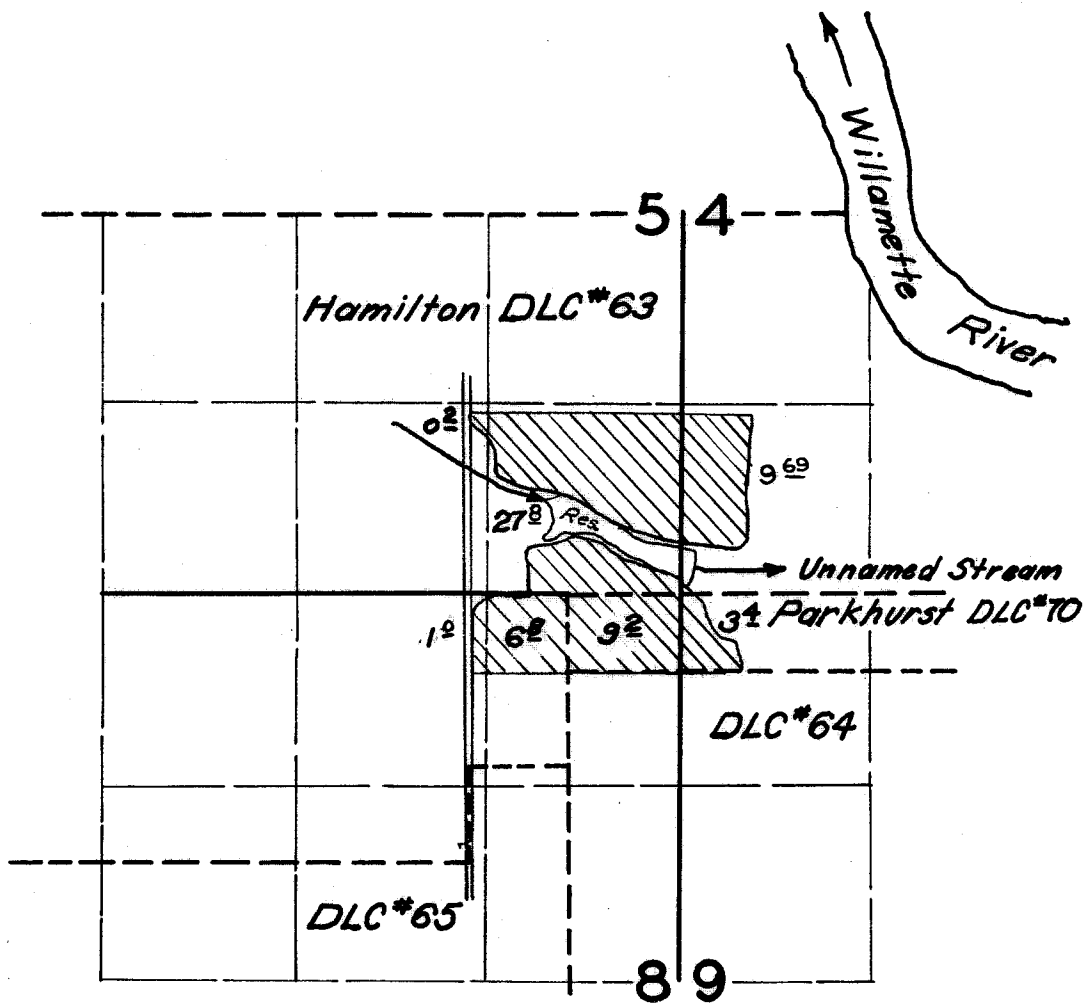

Dam Location: 160' N 100' E from SW CORNER SECTION 4

FINAL PROOF SURVEY
UNDER

Application No. *R-31073* / *31074* Permit No. *R-2002* / *24780*
IN NAME OF

MARK GEHRING

Surveyed *25 July* 1962, by *Carl R. Baker*