


APP No R 86385
 Point No R 14249

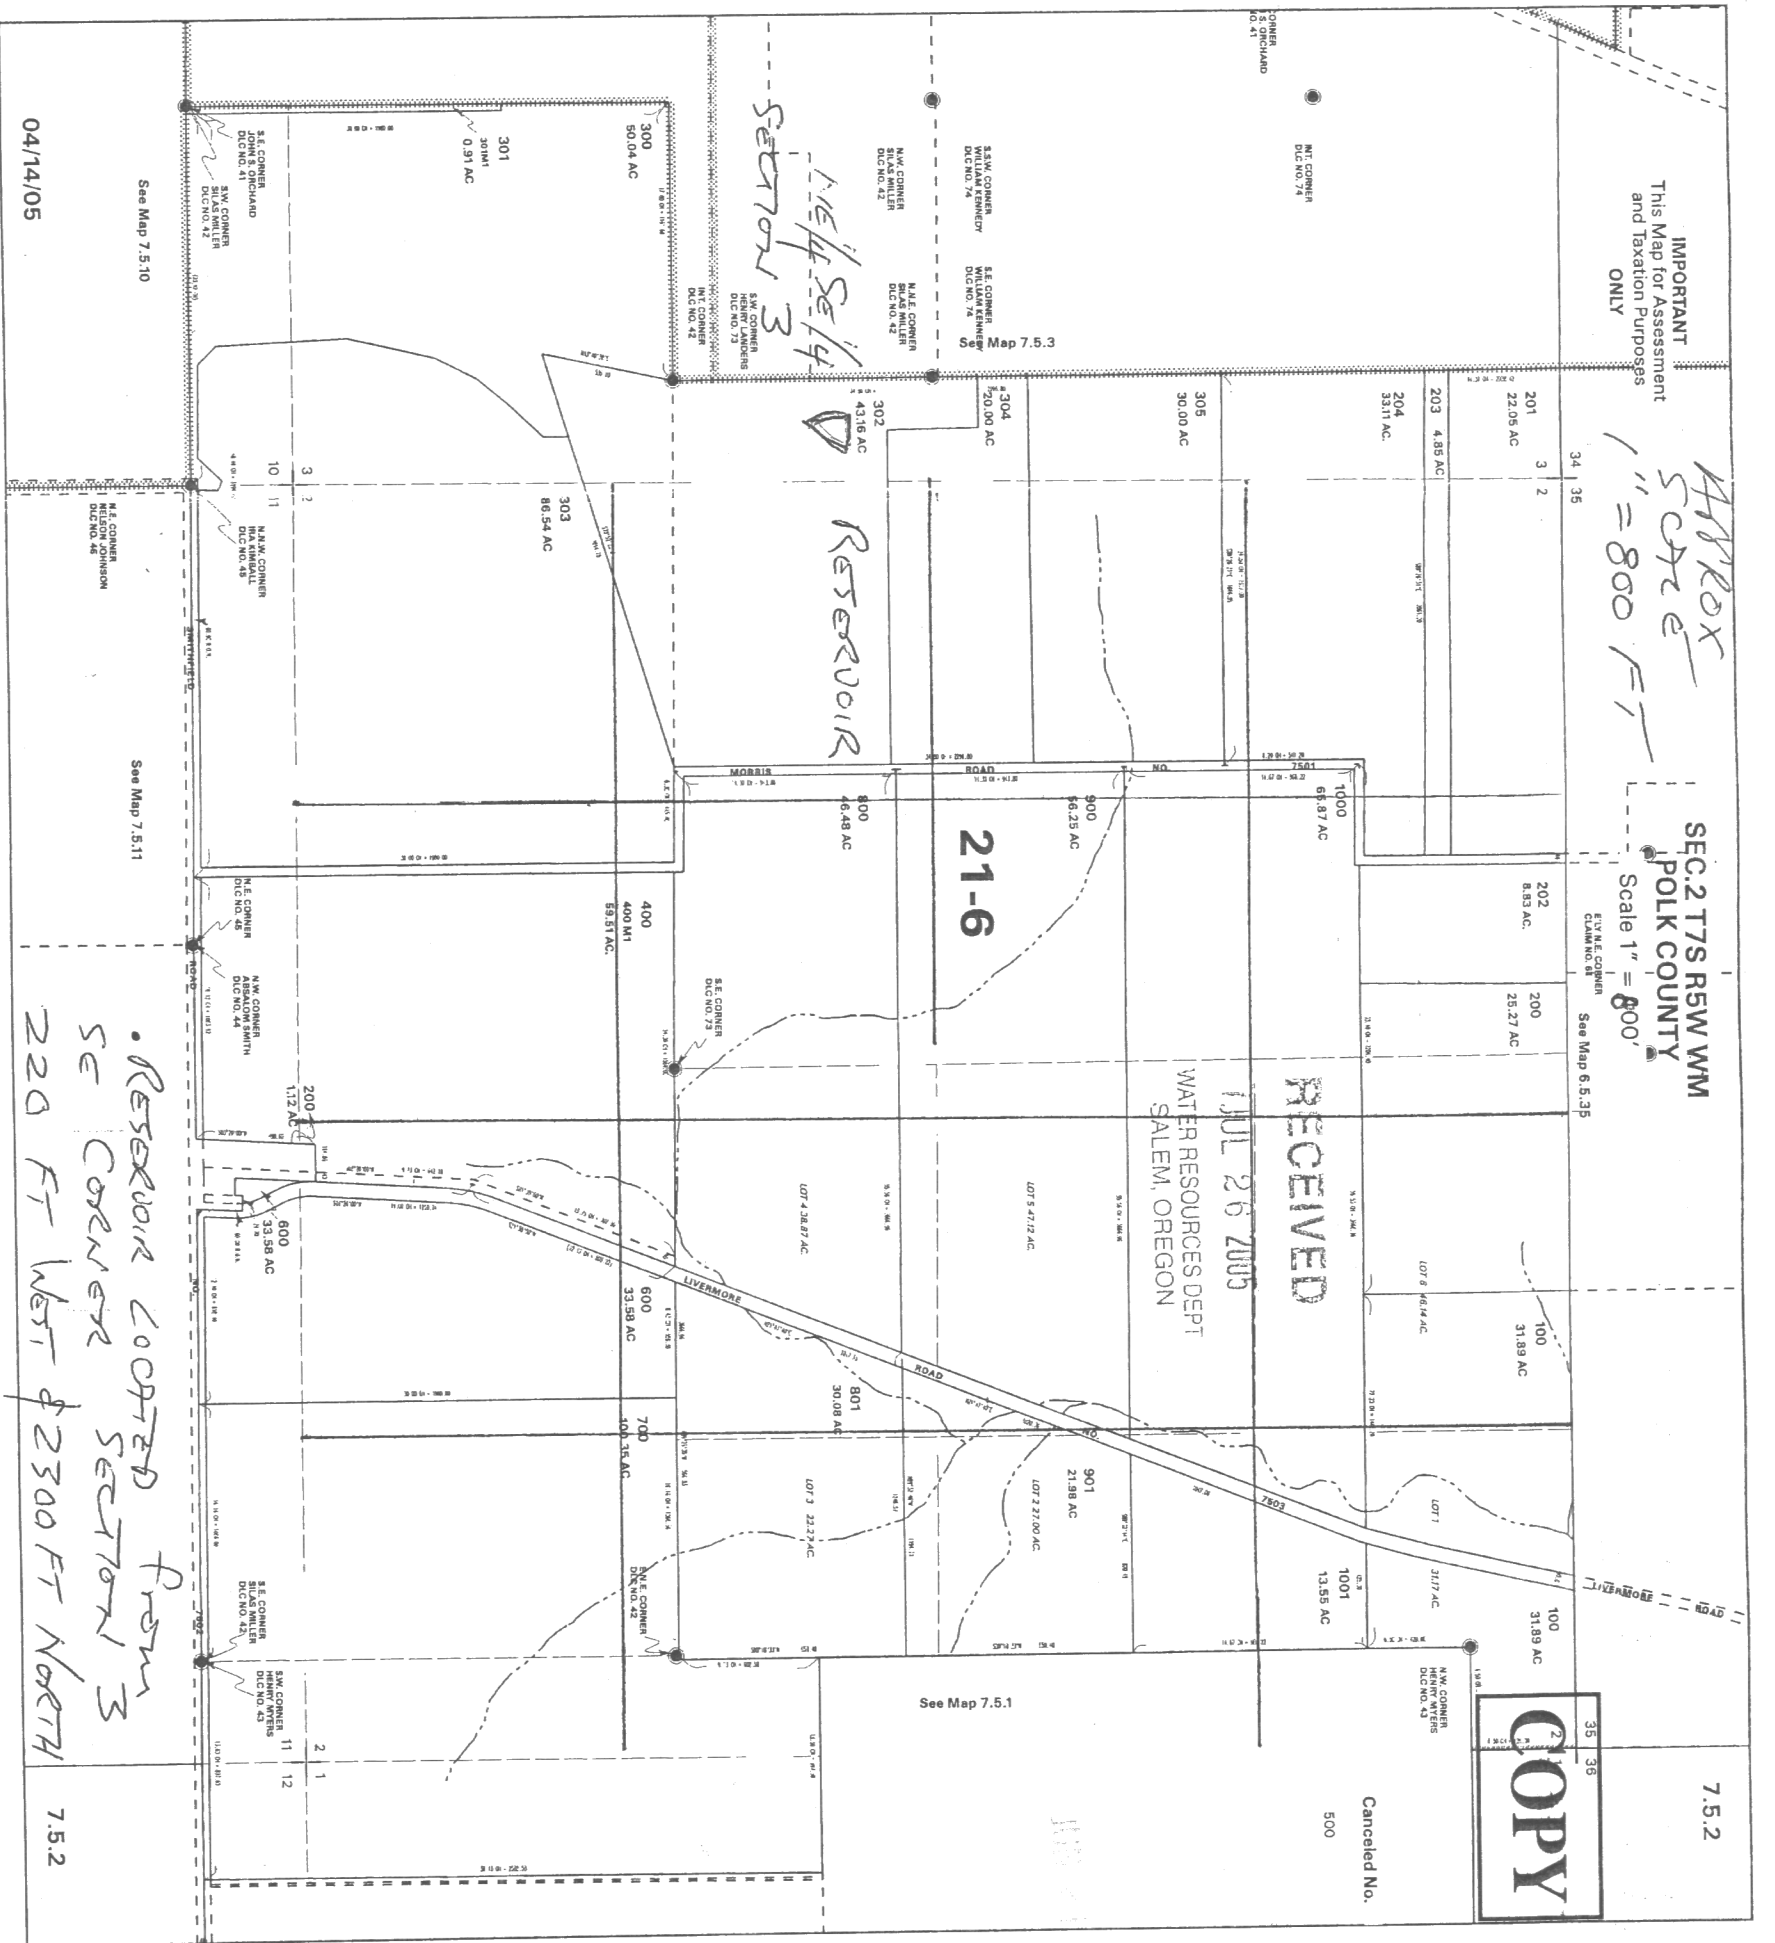

• Reservoir located from
 SE corner SECTION 3
 220 FT West of 2300 FT North

