


# O'Conner Application Map: 2N 12E 36 4400

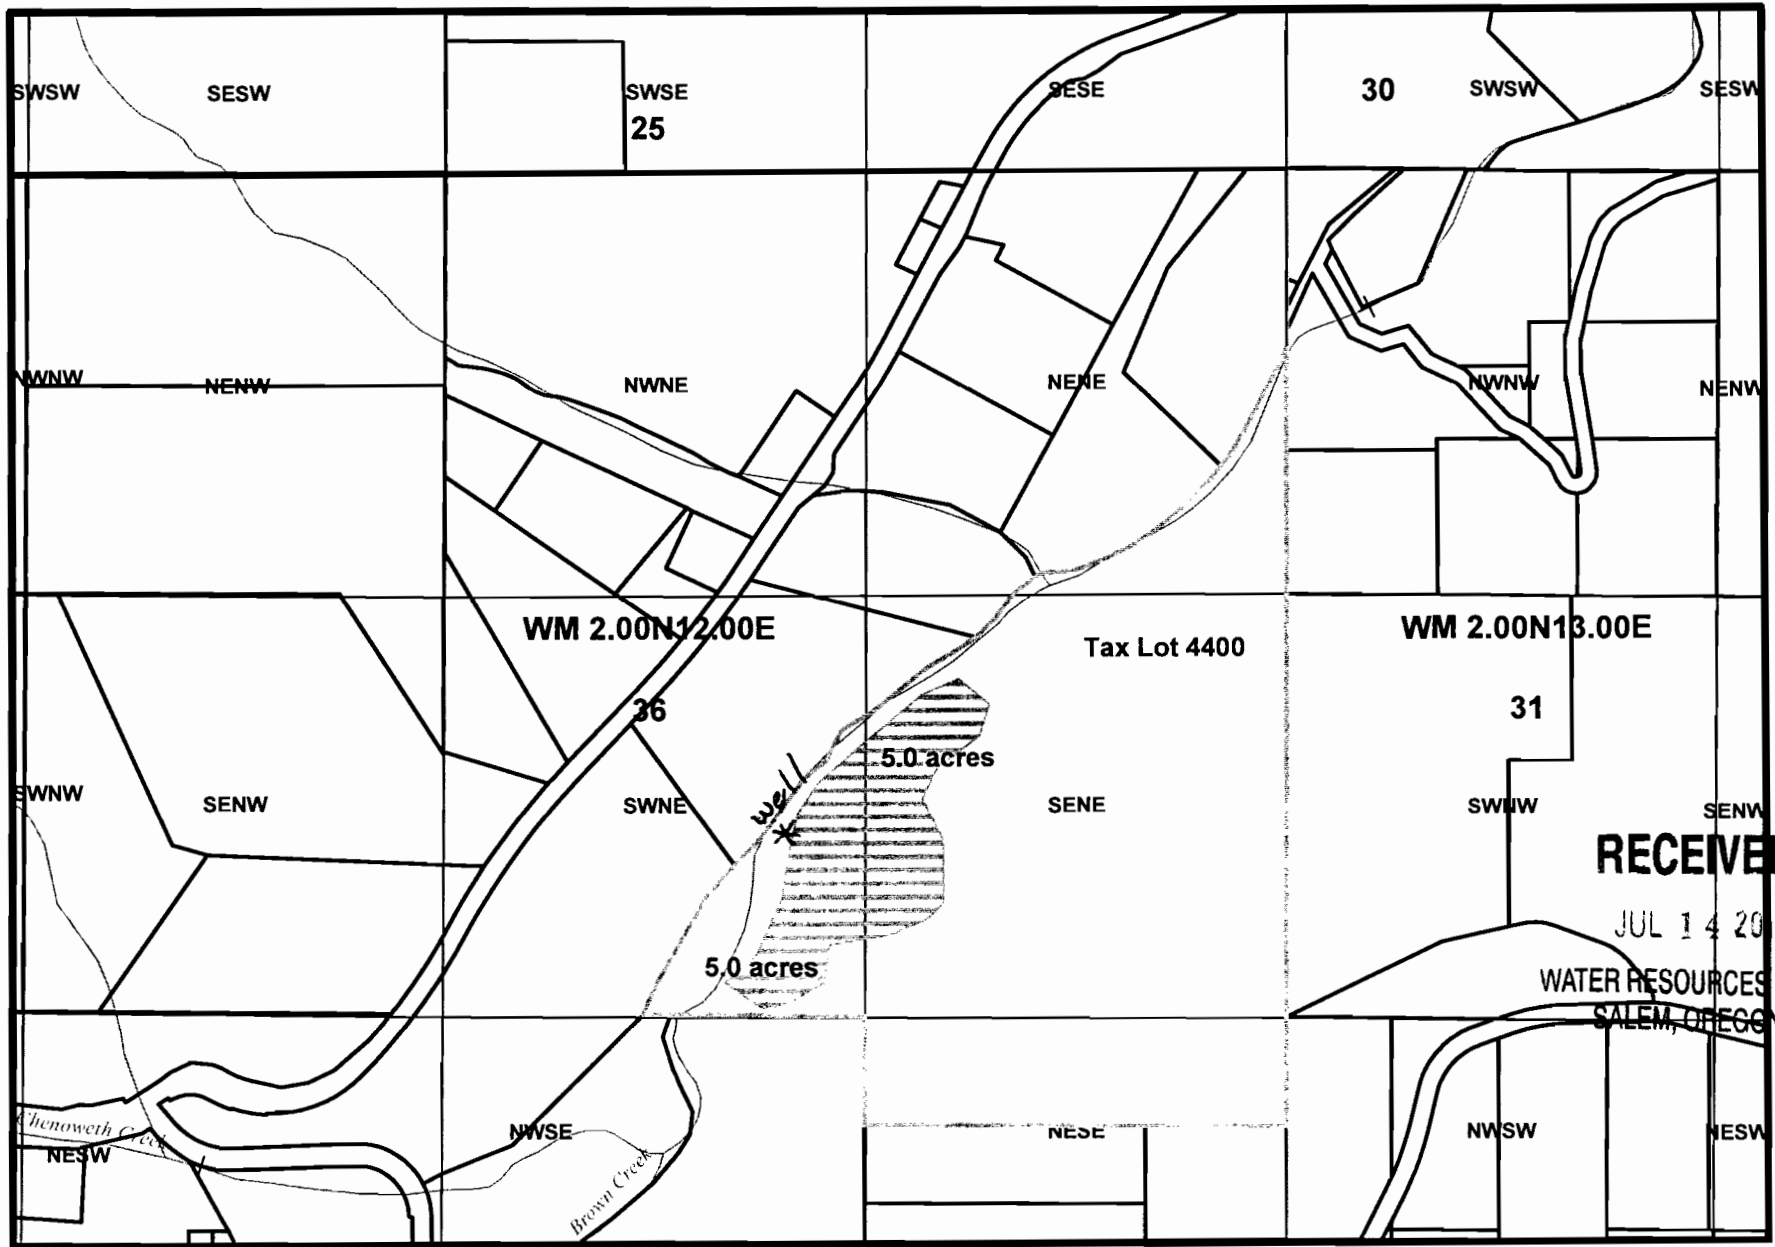

well is 2,070' south &  
1560' west of NE corner,  
Sec 36.

**RECEIVED**  
JUL 14 2000  
WATER RESOURCES DEPT  
SALEM, OREGON

G-17405