

SURFACE WATER APPLICATION MAP
LOCATED IN THE SW¼ SW¼ OF SECTION 13,
TOWNSHIP 21 SOUTH, RANGE 12 WEST, W.M.
DOUGLAS COUNTY, OREGON

PREPARED FOR: JAMES W. & SHARON L. WILL
PREPARED BY: DENNIS GOUDE
DATE PREPARED: JUNE 29, 2010

Scale 1"=400'

LEGEND

P.O.B.



P.O.D.




PIPE



NOTE:

THE POINT OF DIVERSION IS AN INSPIRING PLASTIC BOX. WITH A 1½ INCH PLASTIC PIPE RUNNING 220 FEET TO A 1500 GALLON STORAGE TANK. AT THE STORAGE TANK IS A ½ HORSEPOWER PUMP WITH AN EIGHTY GALLON PRESSURE TANK THAT SUPPLIES WATER TO THE PLACES OF USE THROUGH 220 FEET OF 1 INCH DIAMETER PLASTIC PIPE.

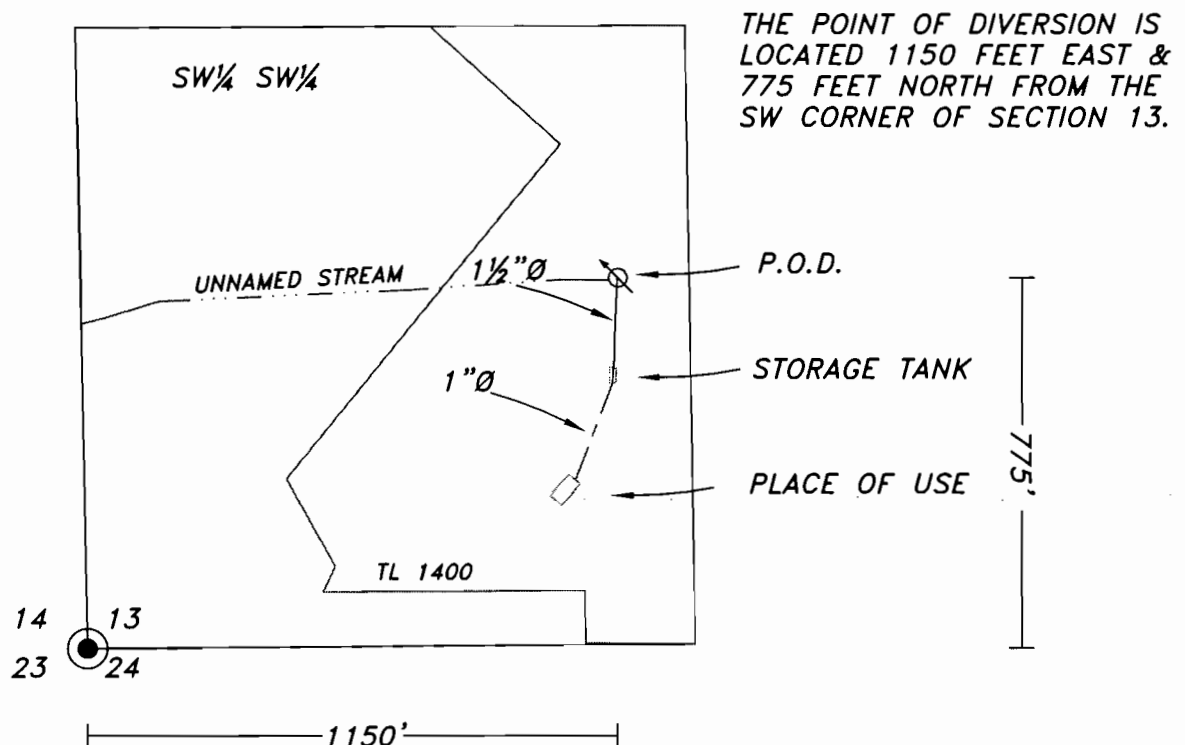

EXAMINERS DISCLAIMER STATEMENT

The preparation of this map was for the purpose of identifying the location of the Water Right only and has no intent to provide dimensions or location of property ownership lines.

**Stuntzner Engineering
& Forestry, L.L.C.**

ENGINEERING • LAND SURVEYING • FORESTRY
PLANNING • WATER RIGHTS

706 South 4th St. Phone: (541) 267-2872
Post Office Box 118 Fax: (541) 267-0588
Coos Bay, Oregon 97602