


T. 39 S. R. 19 E. W.M.

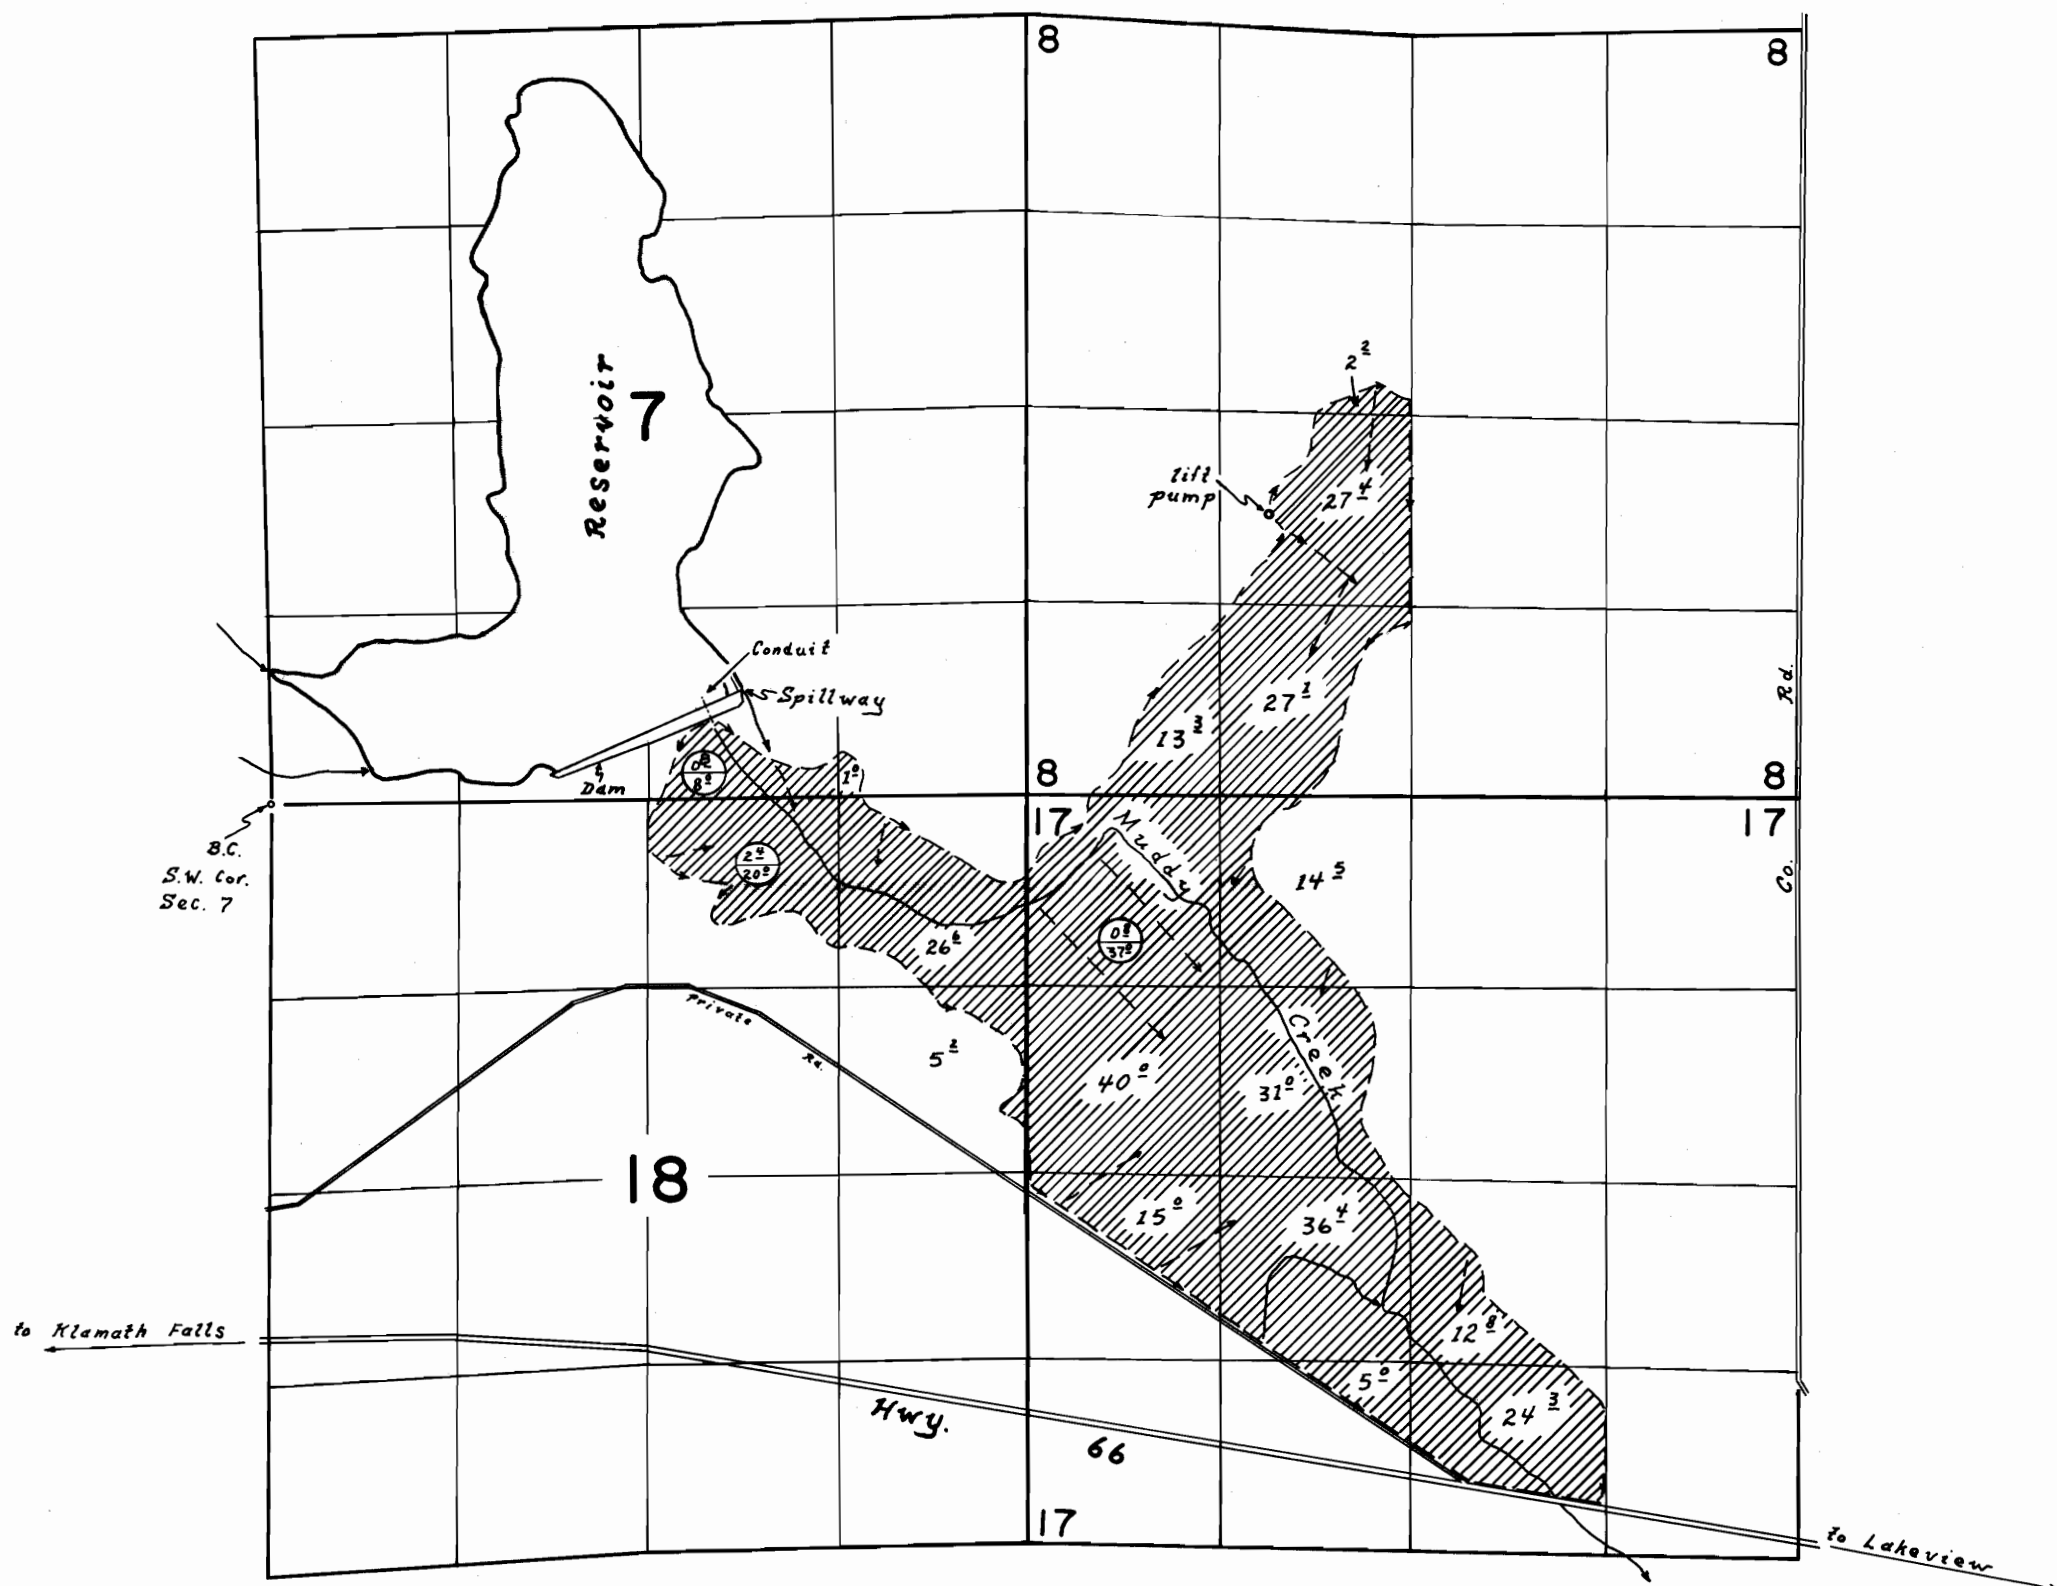

Div. Pt. Loc. 600' N. of 3015' E. from S.W. cor. Sec. 7

FINAL PROOF SURVEY
UNDER

R-34409

R-2648

Application No. 34410 Permit No. 27515
IN NAME OF

Charles K. Kelly

Surveyed 18 Sept. 1972 by L. E. Gould

Primary
Supplemental