


TOWNSHIP, 12 SOUTH, RANGE 25 EAST, W. M.

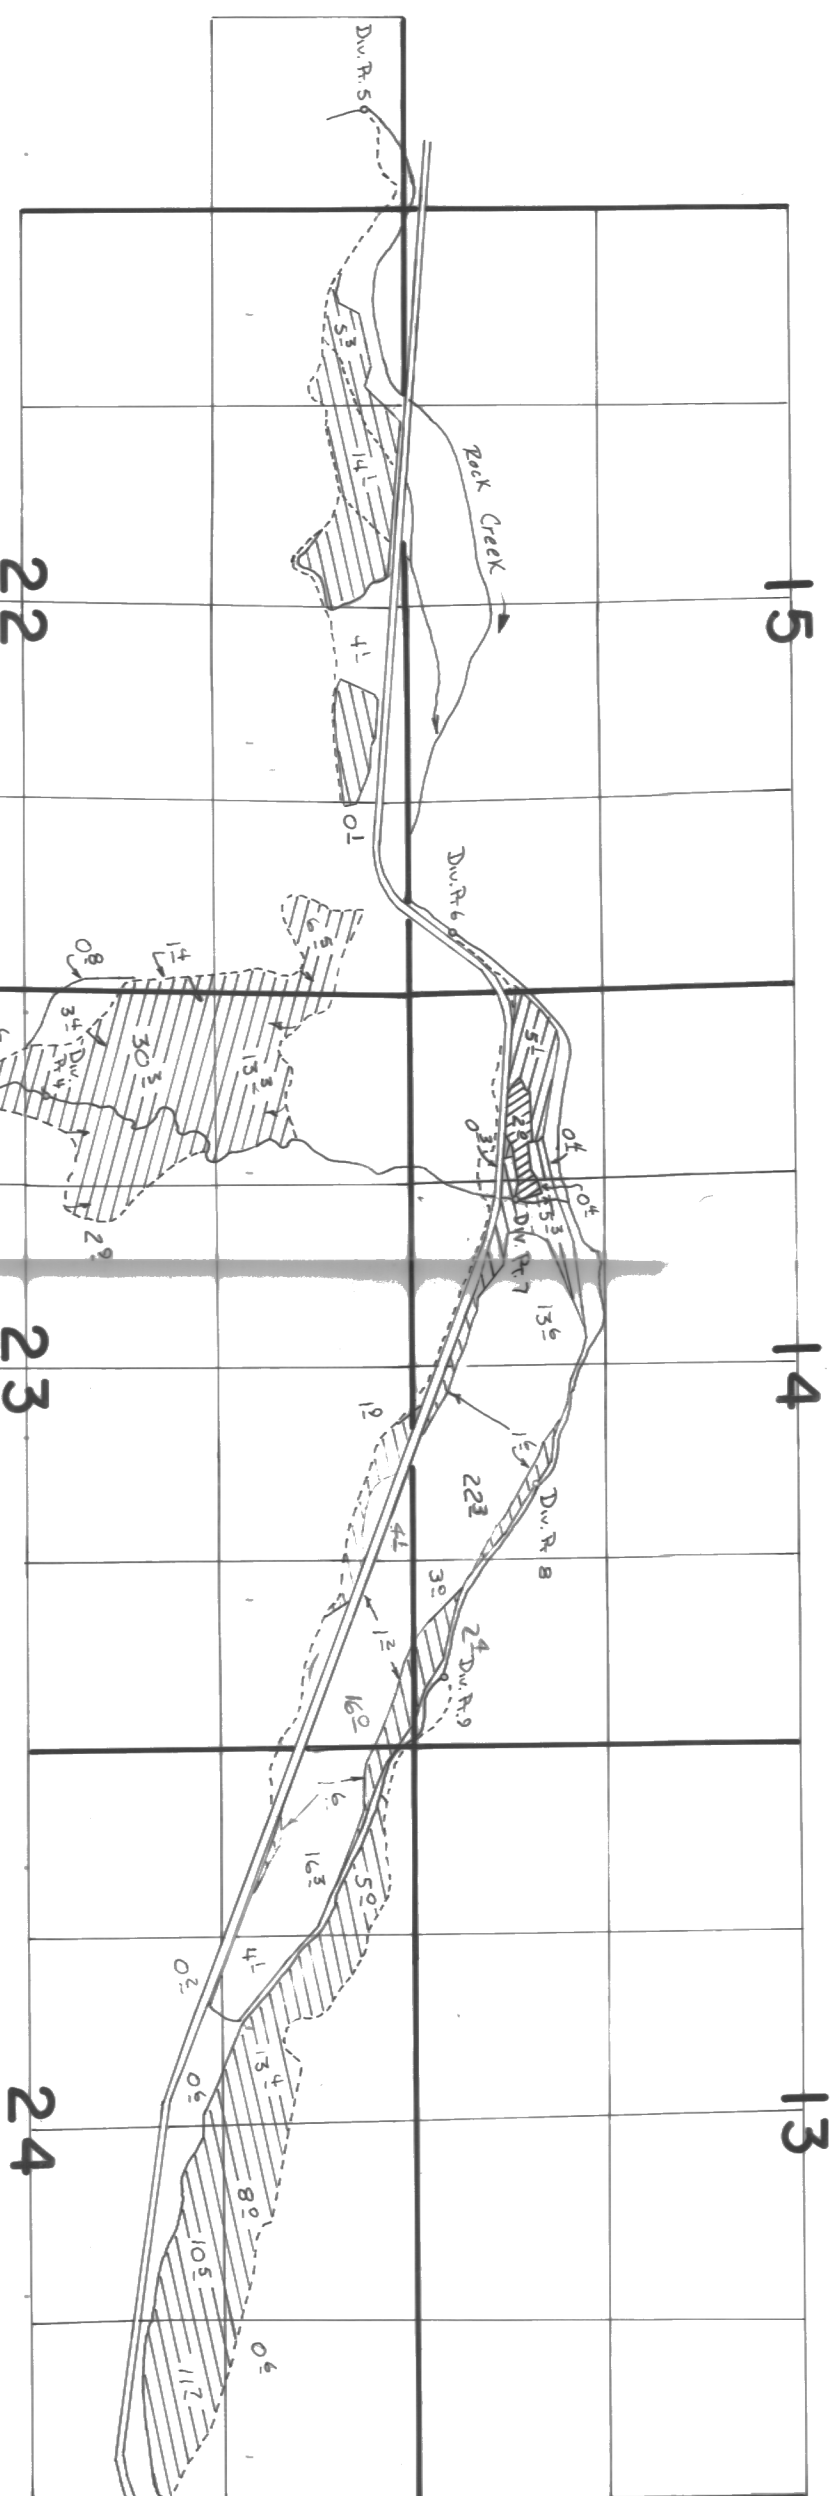

SCALE 1" = 1320'

Div. Pts. Located:

1. 1800'S. & 1510'W. from E1/4 cor. SEC. 27
2. 250'S. & 870'W. from E1/4 cor. SEC. 27
3. 410'S. & 710'E. } from W1/4 cor. SEC. 23
4. 140'N. & 720'E. }
5. 270'S. & 680'W. from NE cor. SEC. 21
6. 300'N. & 410'W. }
7. 730'N. & 1420'E } from SW cor. SEC. 14
8. 850'N. & 3380'E. }
9. 200'N. & 470'E. from SE cor. SEC. 14

Rock Creek

Birch Creek - Primary

Birch Creek - Suppl.

FINAL PROOF SURVEY
UNDER

Application No. 37728 Permit No. 28123
IN NAME OF

Try Creek Ranch Inc.

Surveyed AUG. 20 1976, by D. NORBY
JULY 25 79 C.L. HUGHES
MAR. 18 86 V.L. CHURCH