


SEC.13 T.26S. R.4W. W.M.
DOUGLAS COUNTY
Scale 1" = 500'

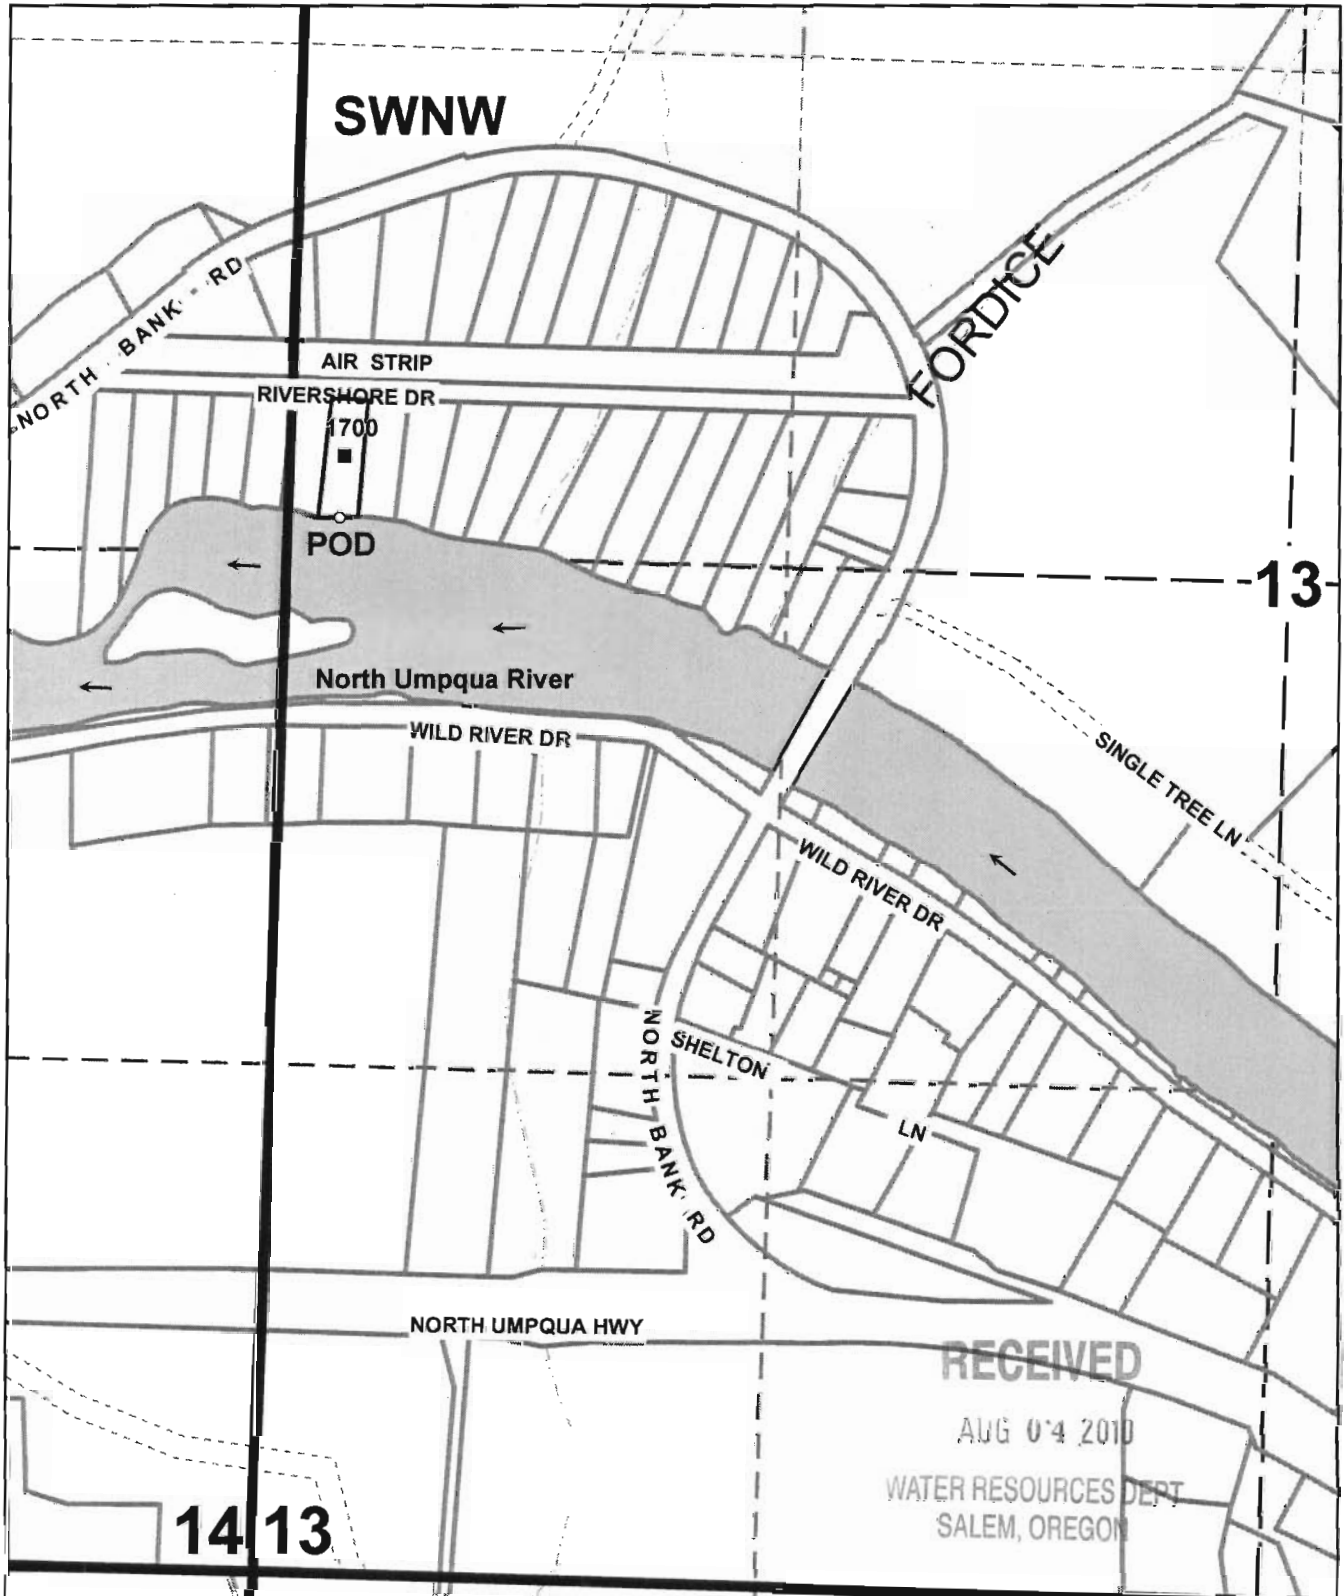

POD is located 140 ft. north and 2475 ft. west
of the center of Section 13.

S-87601

RECEIVED

AUG 04 2010

WATER RESOURCES DEPT
SALEM, OREGON