RECEIVED
AUG 09 2010
WATER RESOURCES DEPT
SALEM, OREGON

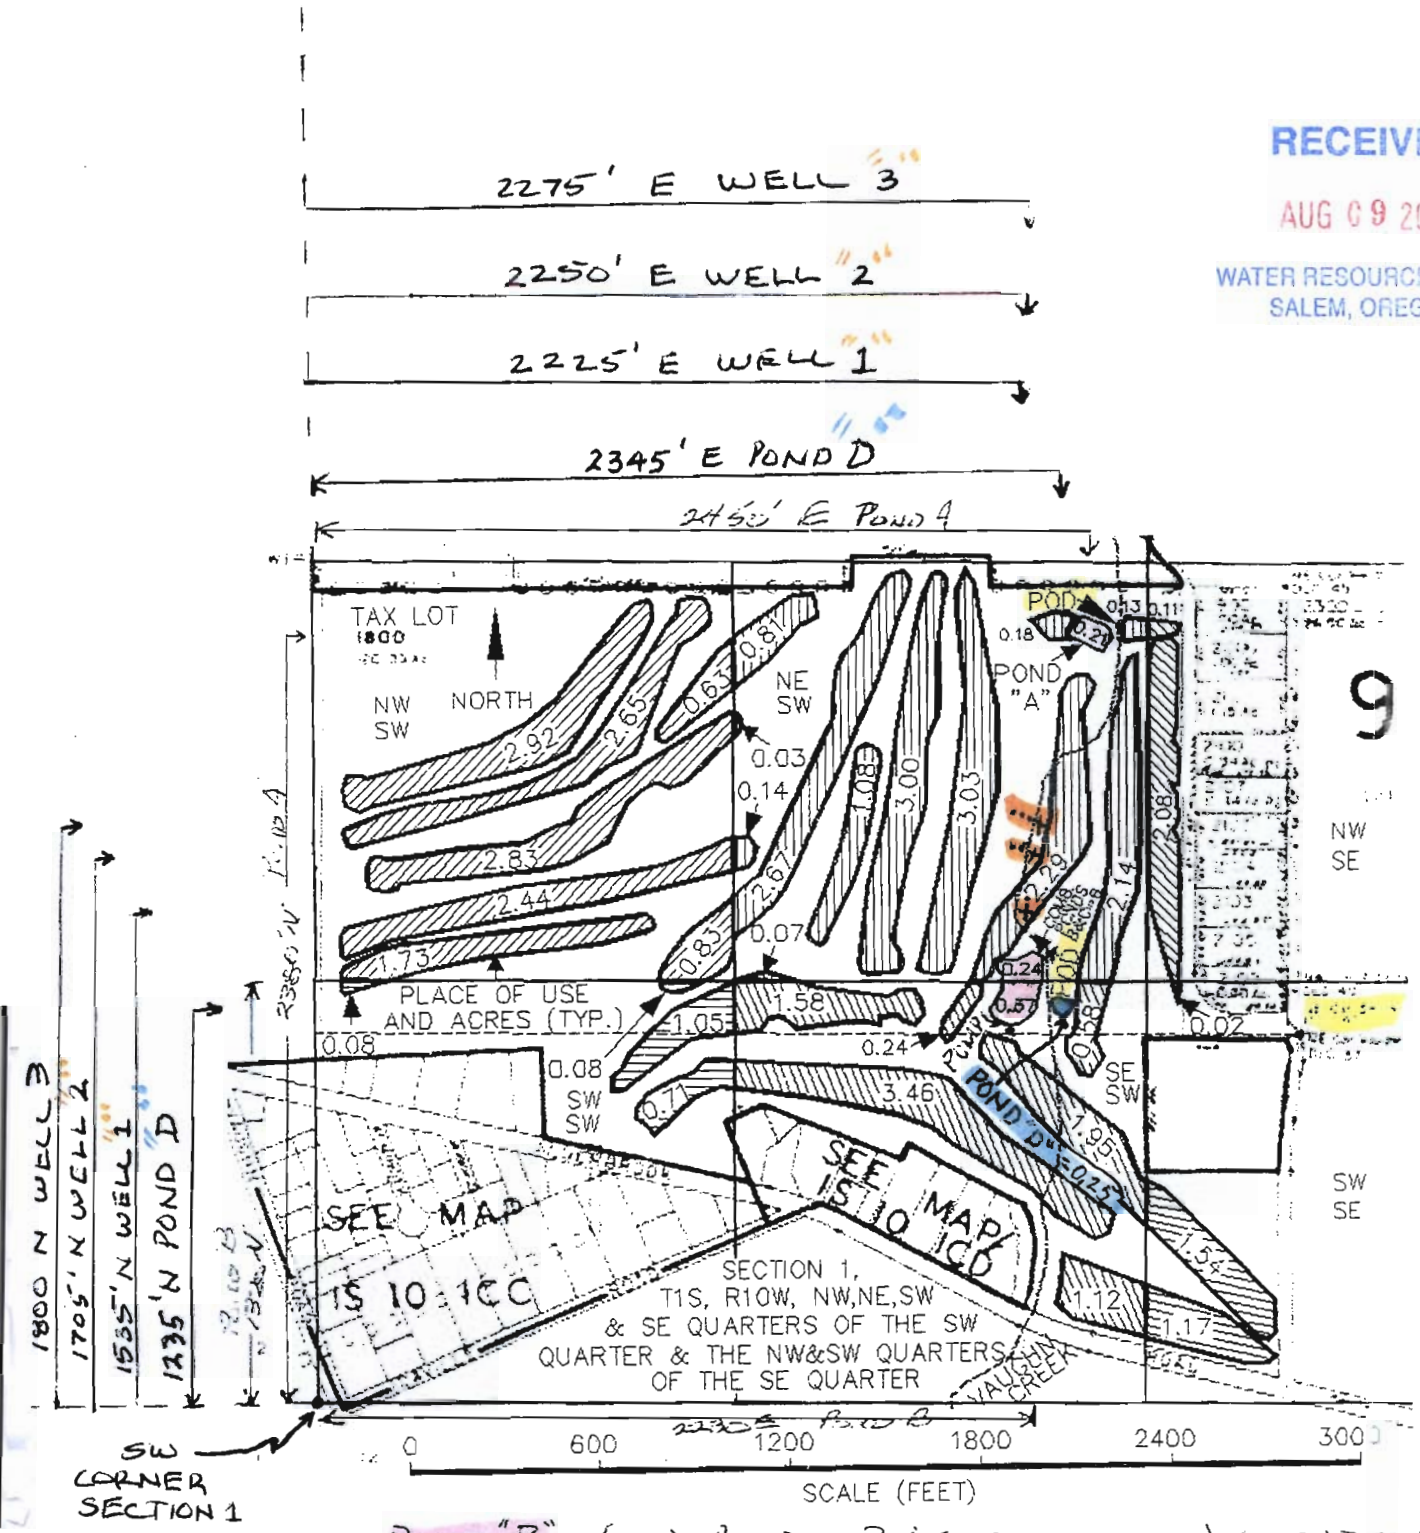

* POND "B" (OLD PONDS B & C COMBINED) LOCATION: 930' W FROM SE COR. SMITH DLC 45
1320' NORTH AND 2230' EAST FROM SW CORNER OF SECTION 1
* POND "A" LOCATION: LANDSCAPE USE
2350' NORTH AND 2450' EAST FROM SW CORNER OF SECTION 1
* DIV. PTS LOCATIONS: CREEK - 1300' N & 55' SW; 250' N & 850' WEST, ALL FROM SE COR. SMITH DLC 45
* POND "D" LOCATION: 1235' NORTH & 2345' EAST FROM SW CORNER OF SECTION 1

X WELL 1 LOCATION: 1535' N. & 2225' E. FROM SW CORNER OF SECTION 1.
XX WELL 2 LOCATION: 1705' N. & 2250' E. FROM SW CORNER OF SECTION 1.
XXX WELL 3 LOCATION: 1800' N & 2275' E. FROM SW CORNER OF SECTION 1.