


T12S, R2W SEC 34

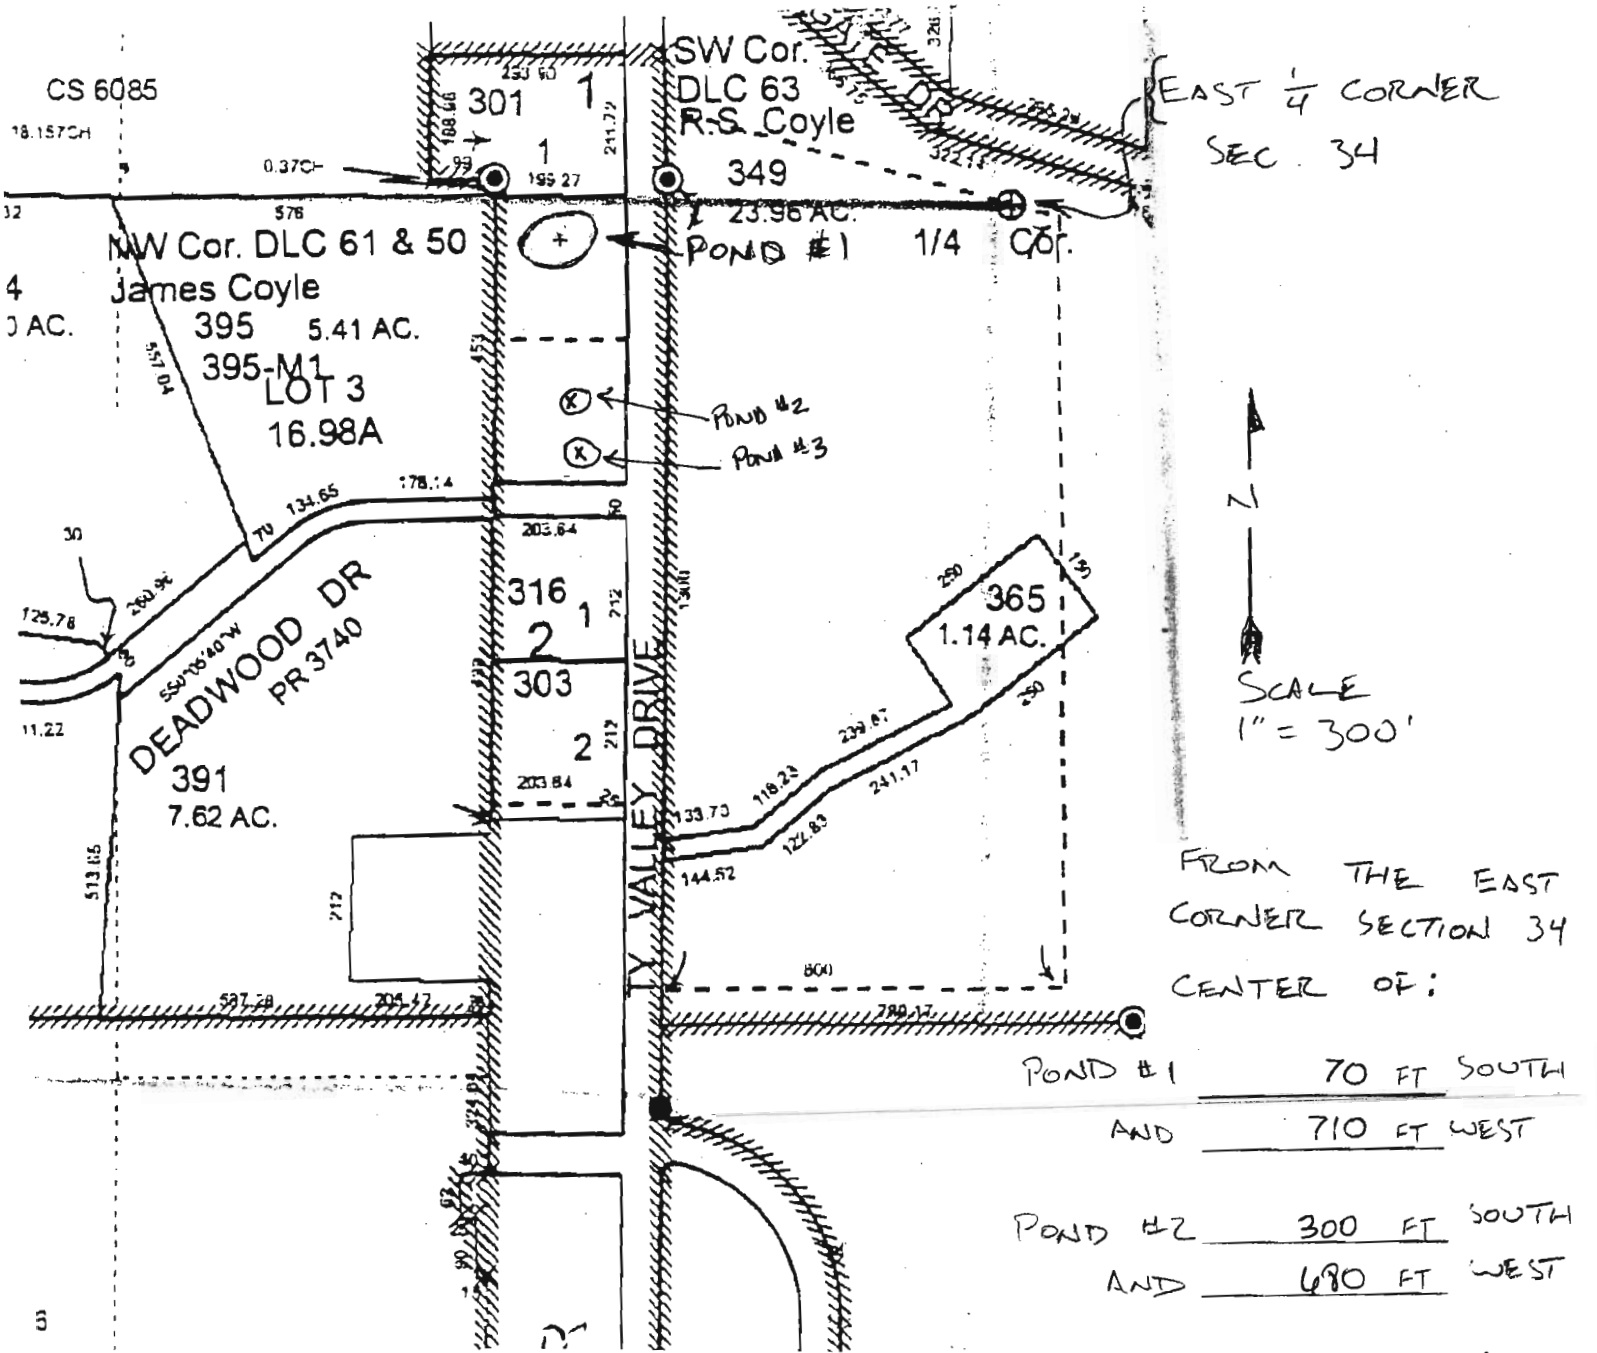

KIMBERLY SNOOK
30680 TY VALLEY ROAD
LEBANON, OR 97355

NE 1/4 OF THE SE 1/4, SEC. 34, T12S, R2W
TAX LOT 372

RECEIVED

AUG 26 2010

WATER RESOURCES DEPT
SALEM, OREGON

R-87648