


T12S, R2W SEC 34

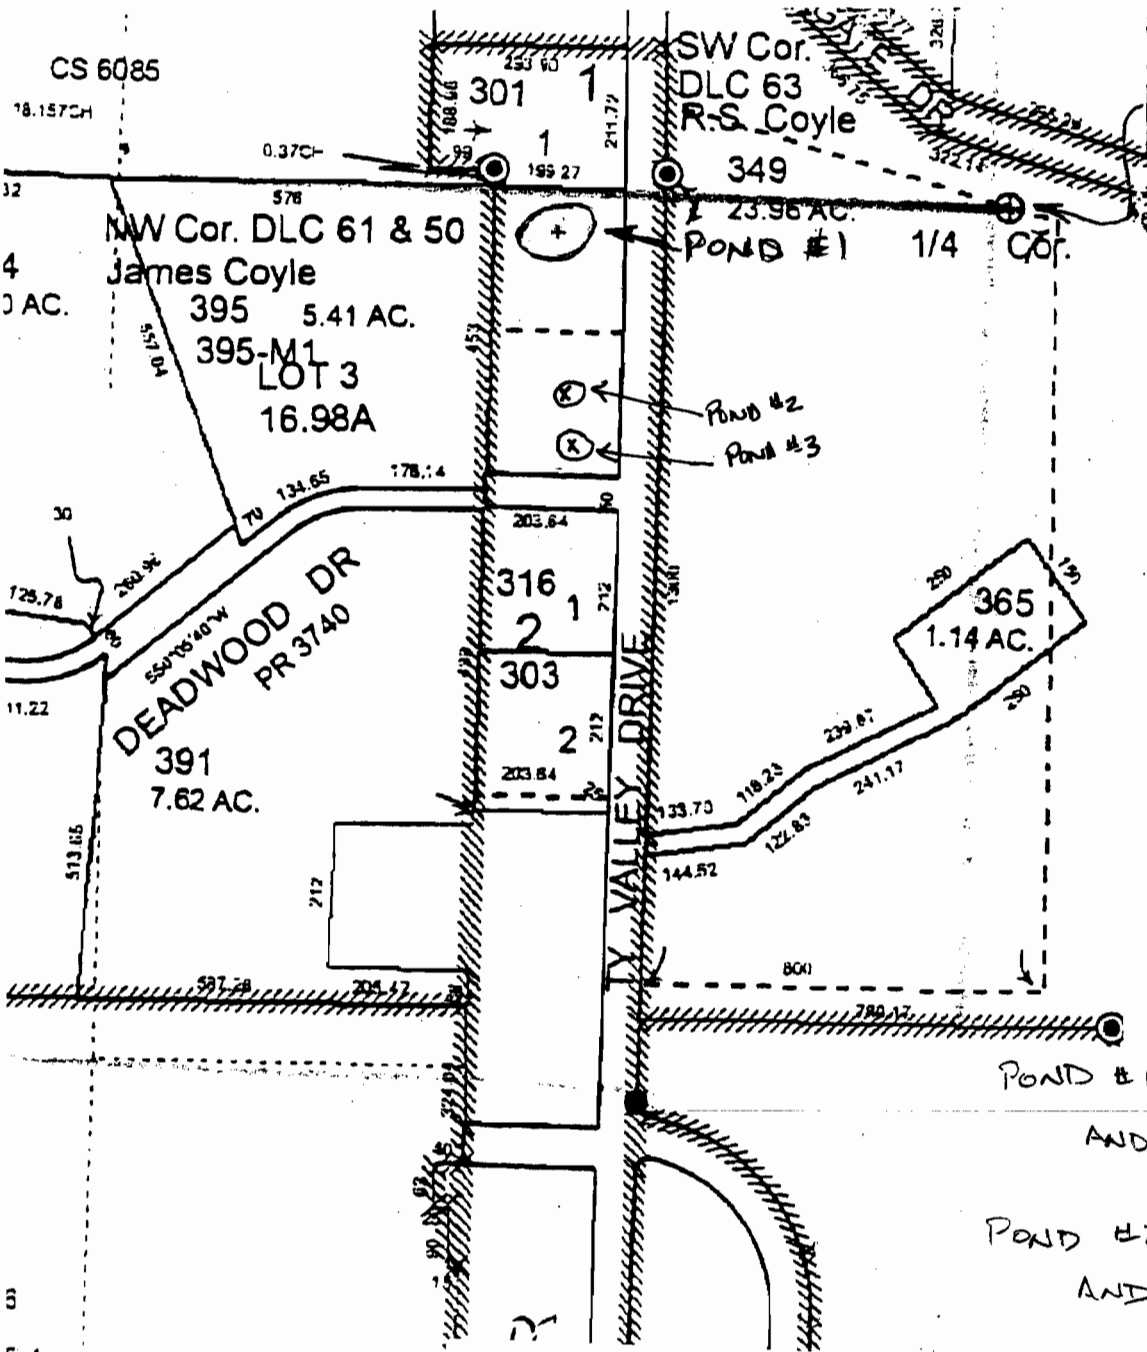

EAST 1/4 CORNER
SEC. 34



SCALE
1" = 300'

FROM THE EAST
CORNER SECTION 34
CENTER OF:

POND #1 70 FT SOUTH
 AND 710 FT WEST

POND #2 300 FT SOUTH
 AND 690 FT WEST

POND #3 375 FT SOUTH
 AND 660 FT WEST

KIMBERLY SNOOK
30680 TY VALLEY ROAD
LEBANON, OR 97355

NE 1/4 OF THE SE 1/4, SEC. 34, T12S, R2W
TAX LOT 372

AUG 26 2010

R-E7649