


T12S, R2W SEC 34

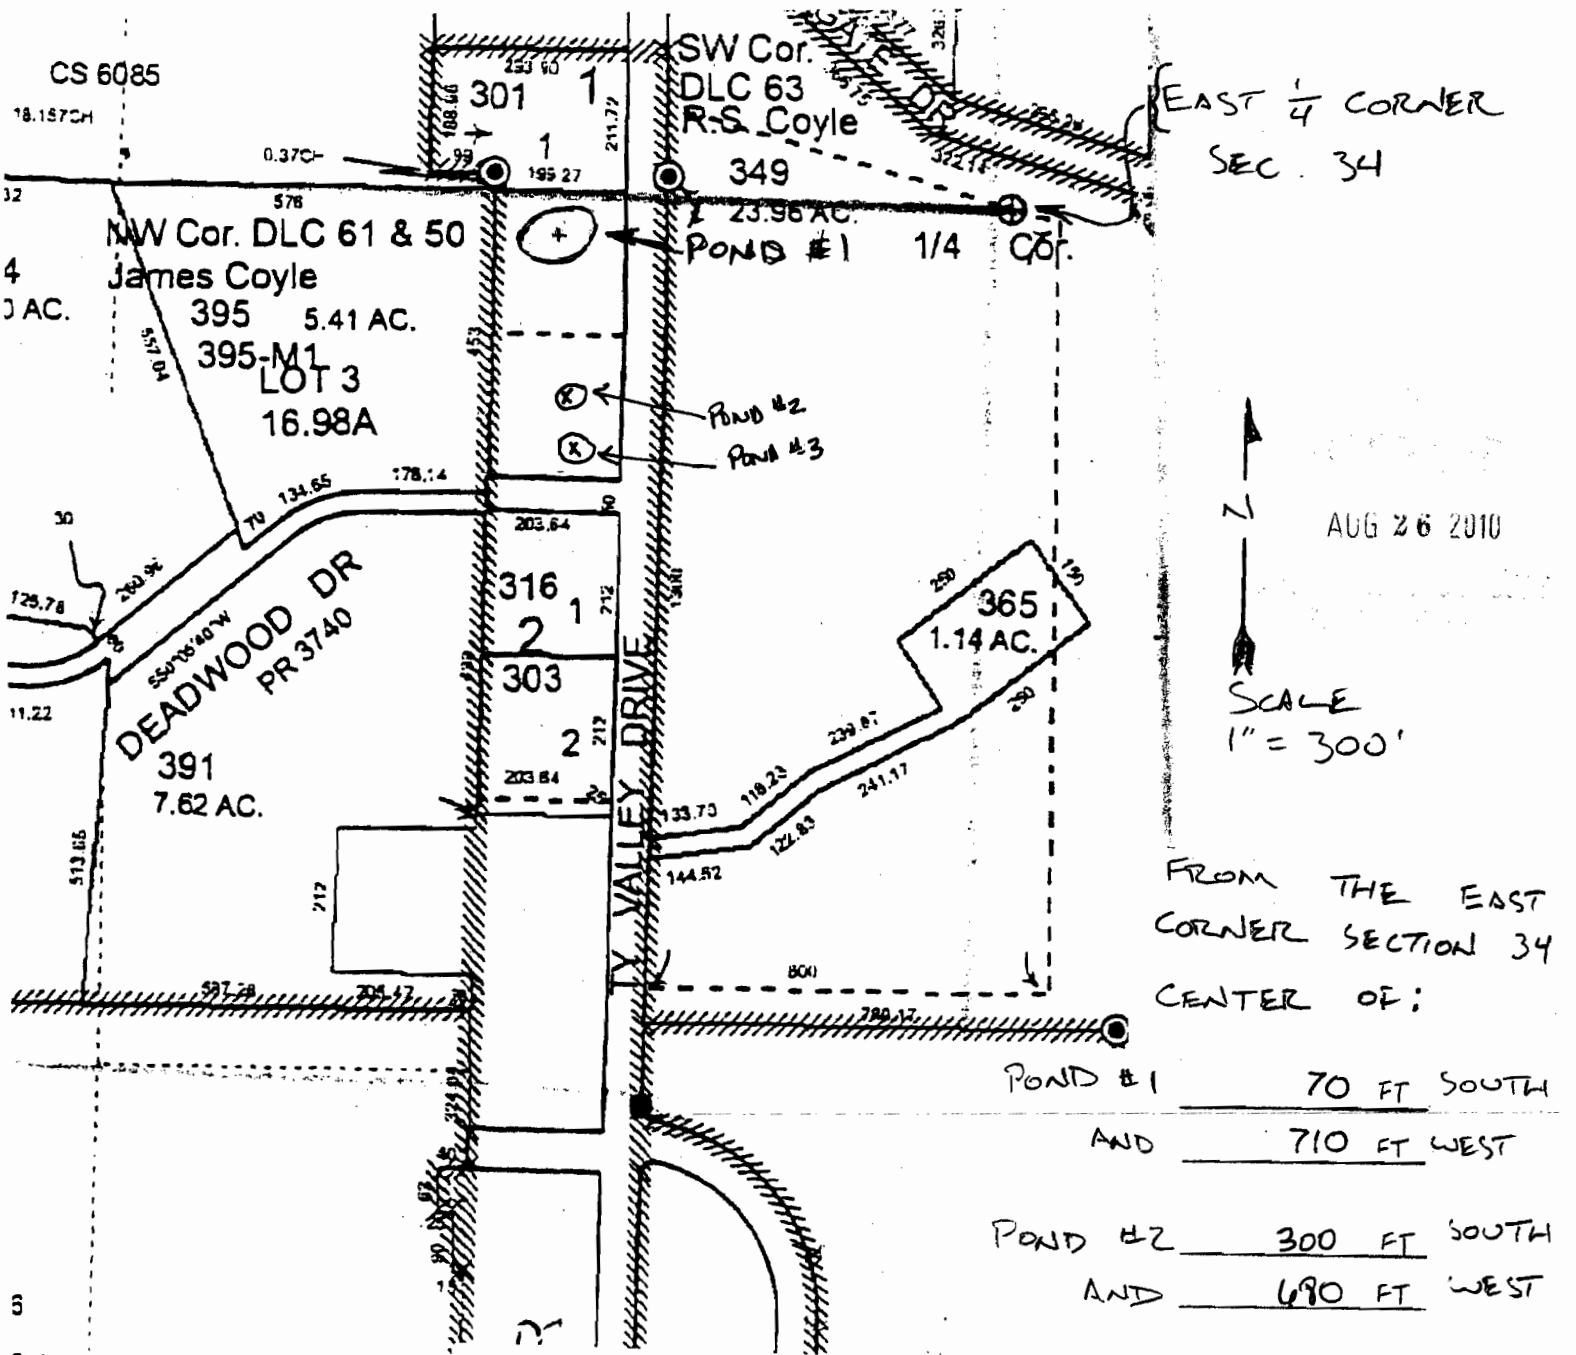

KIMBERLY SNOOK
30680 TY VALLEY ROAD
LEBANON, OR 97355
NE 1/4 OF THE SE 1/4, SEC. 34, T12S, R2W
TAX LOT 372

R-67650