


EAGLE CREST AS-BUILT WATER PLAN

PREPARED BY W & H PACIFIC
PREPARED 7/1/93

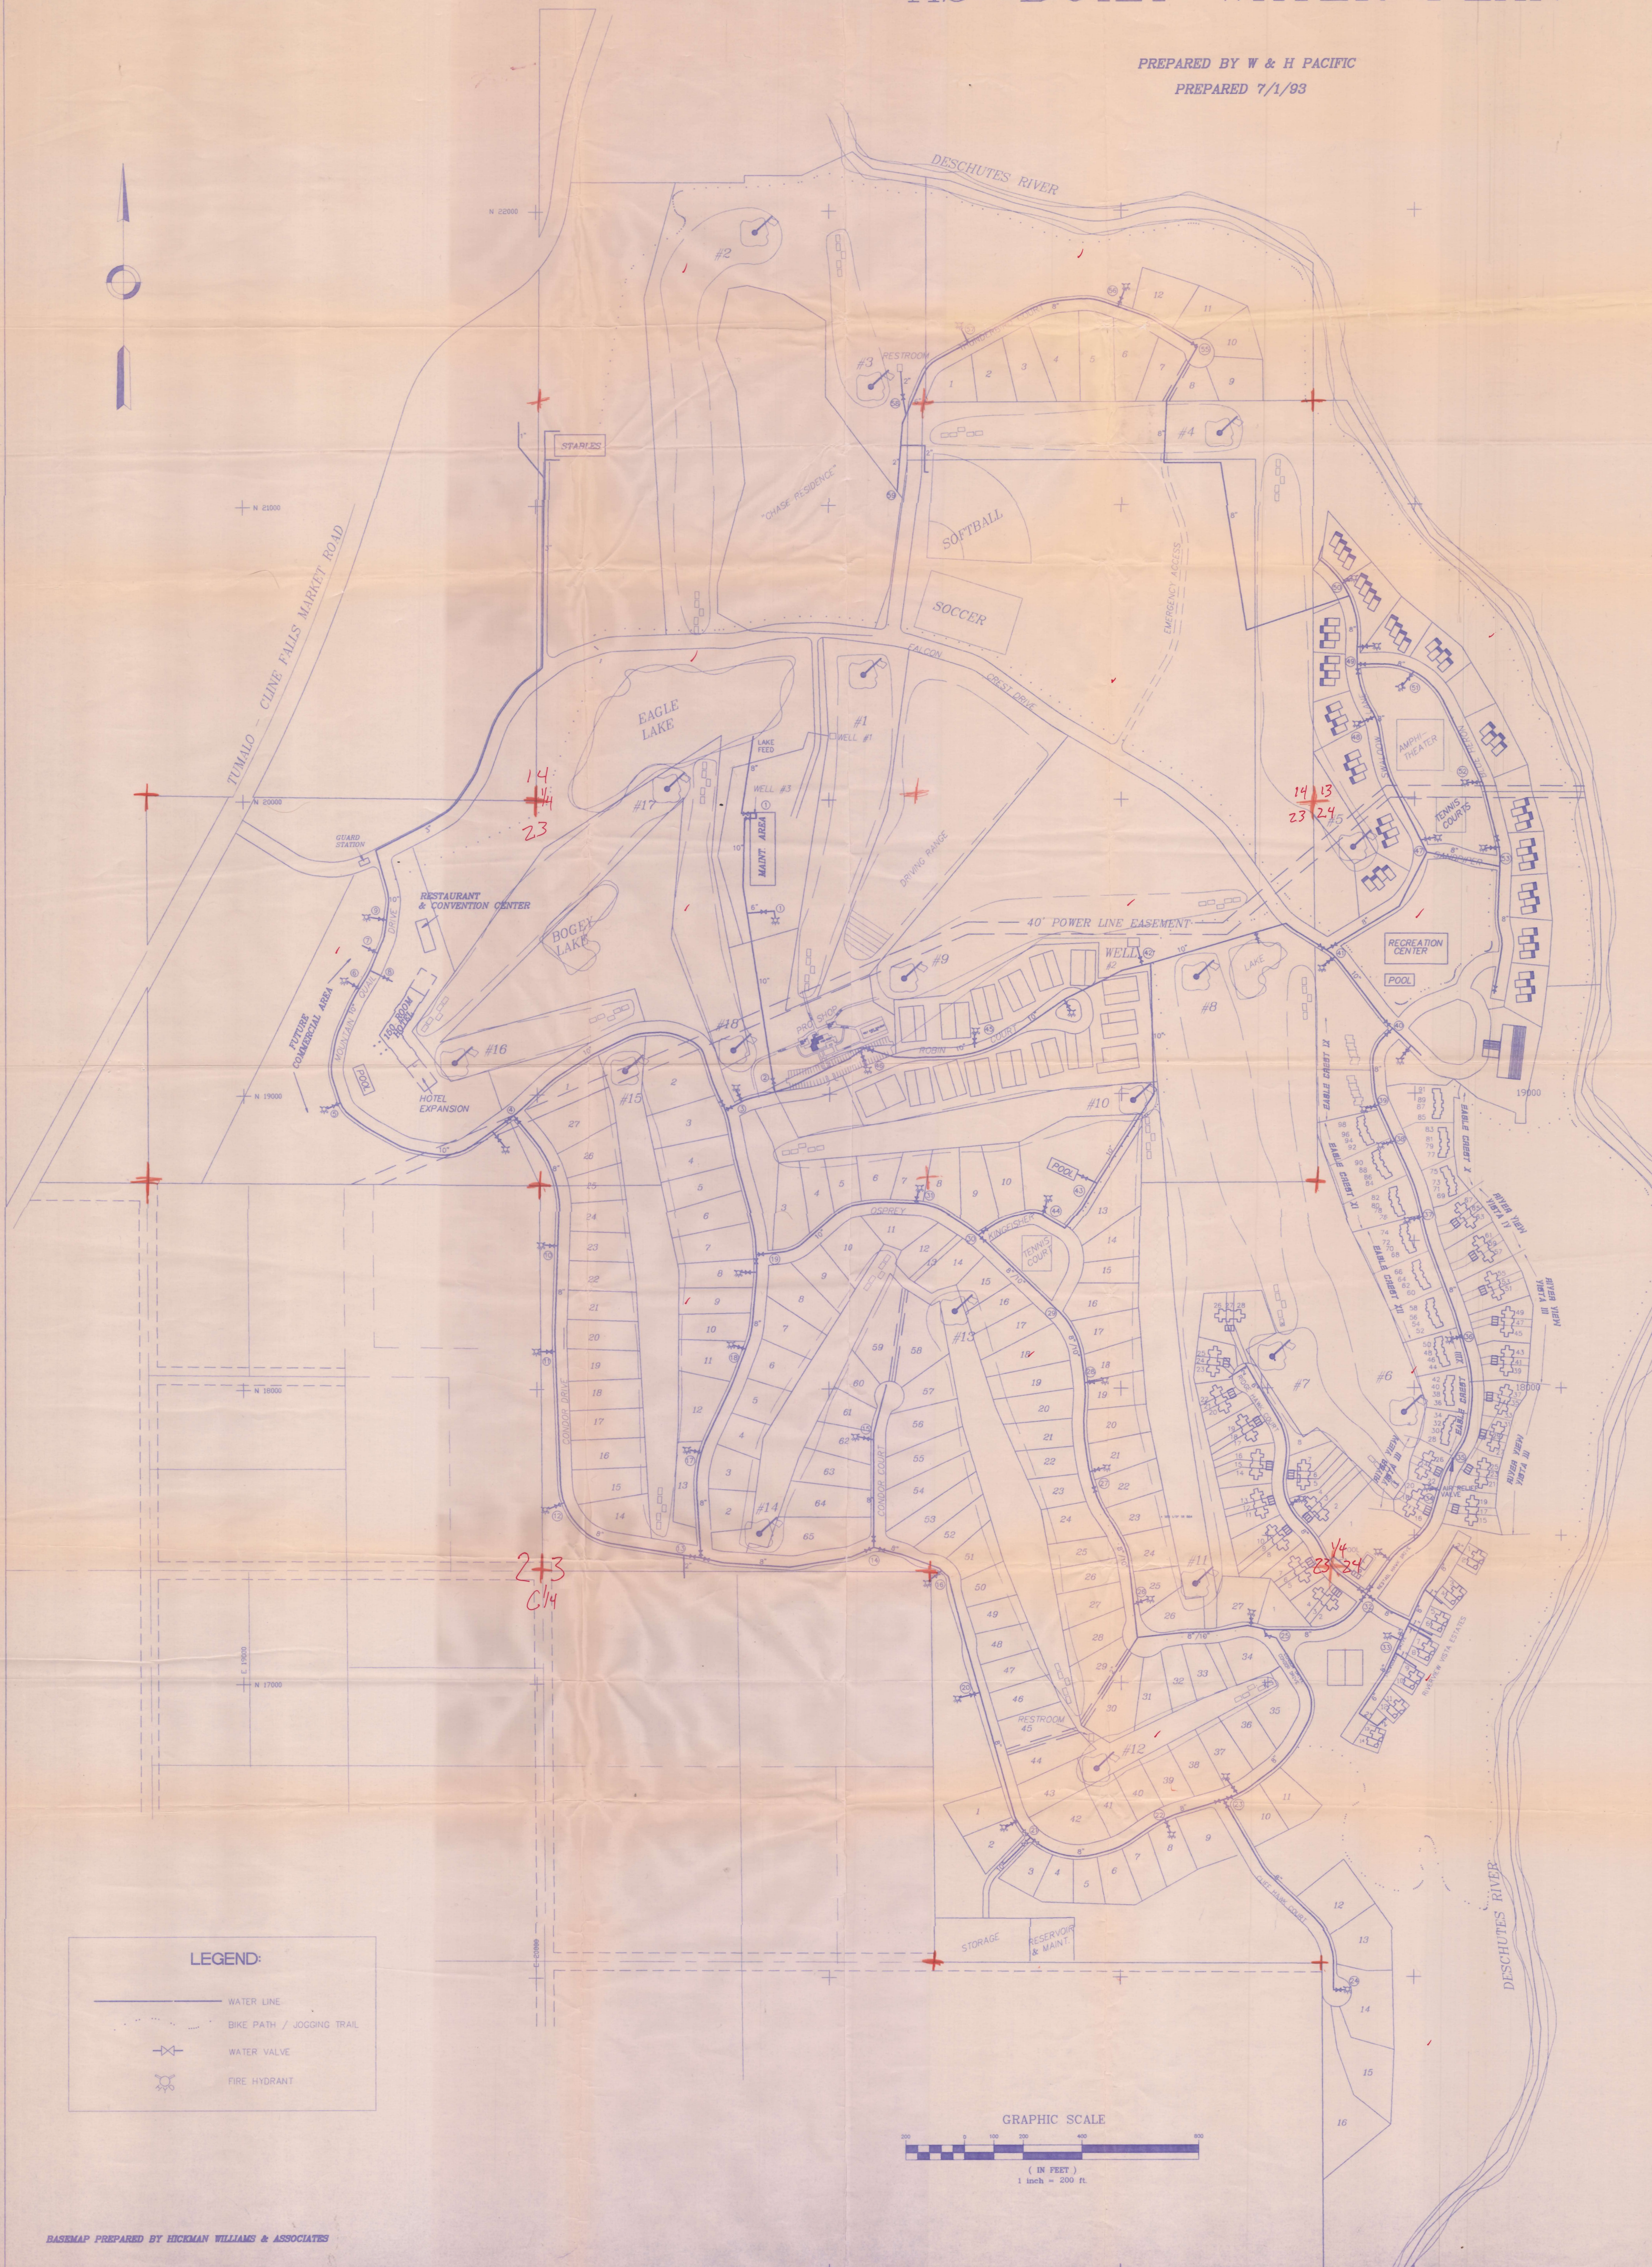

LEGEND:

	WATER LINE
	BIKE PATH / JOGGING TRAIL
	WATER VALVE
	FIRE HYDRANT

