

D 14 13

T10S R29E W.M.

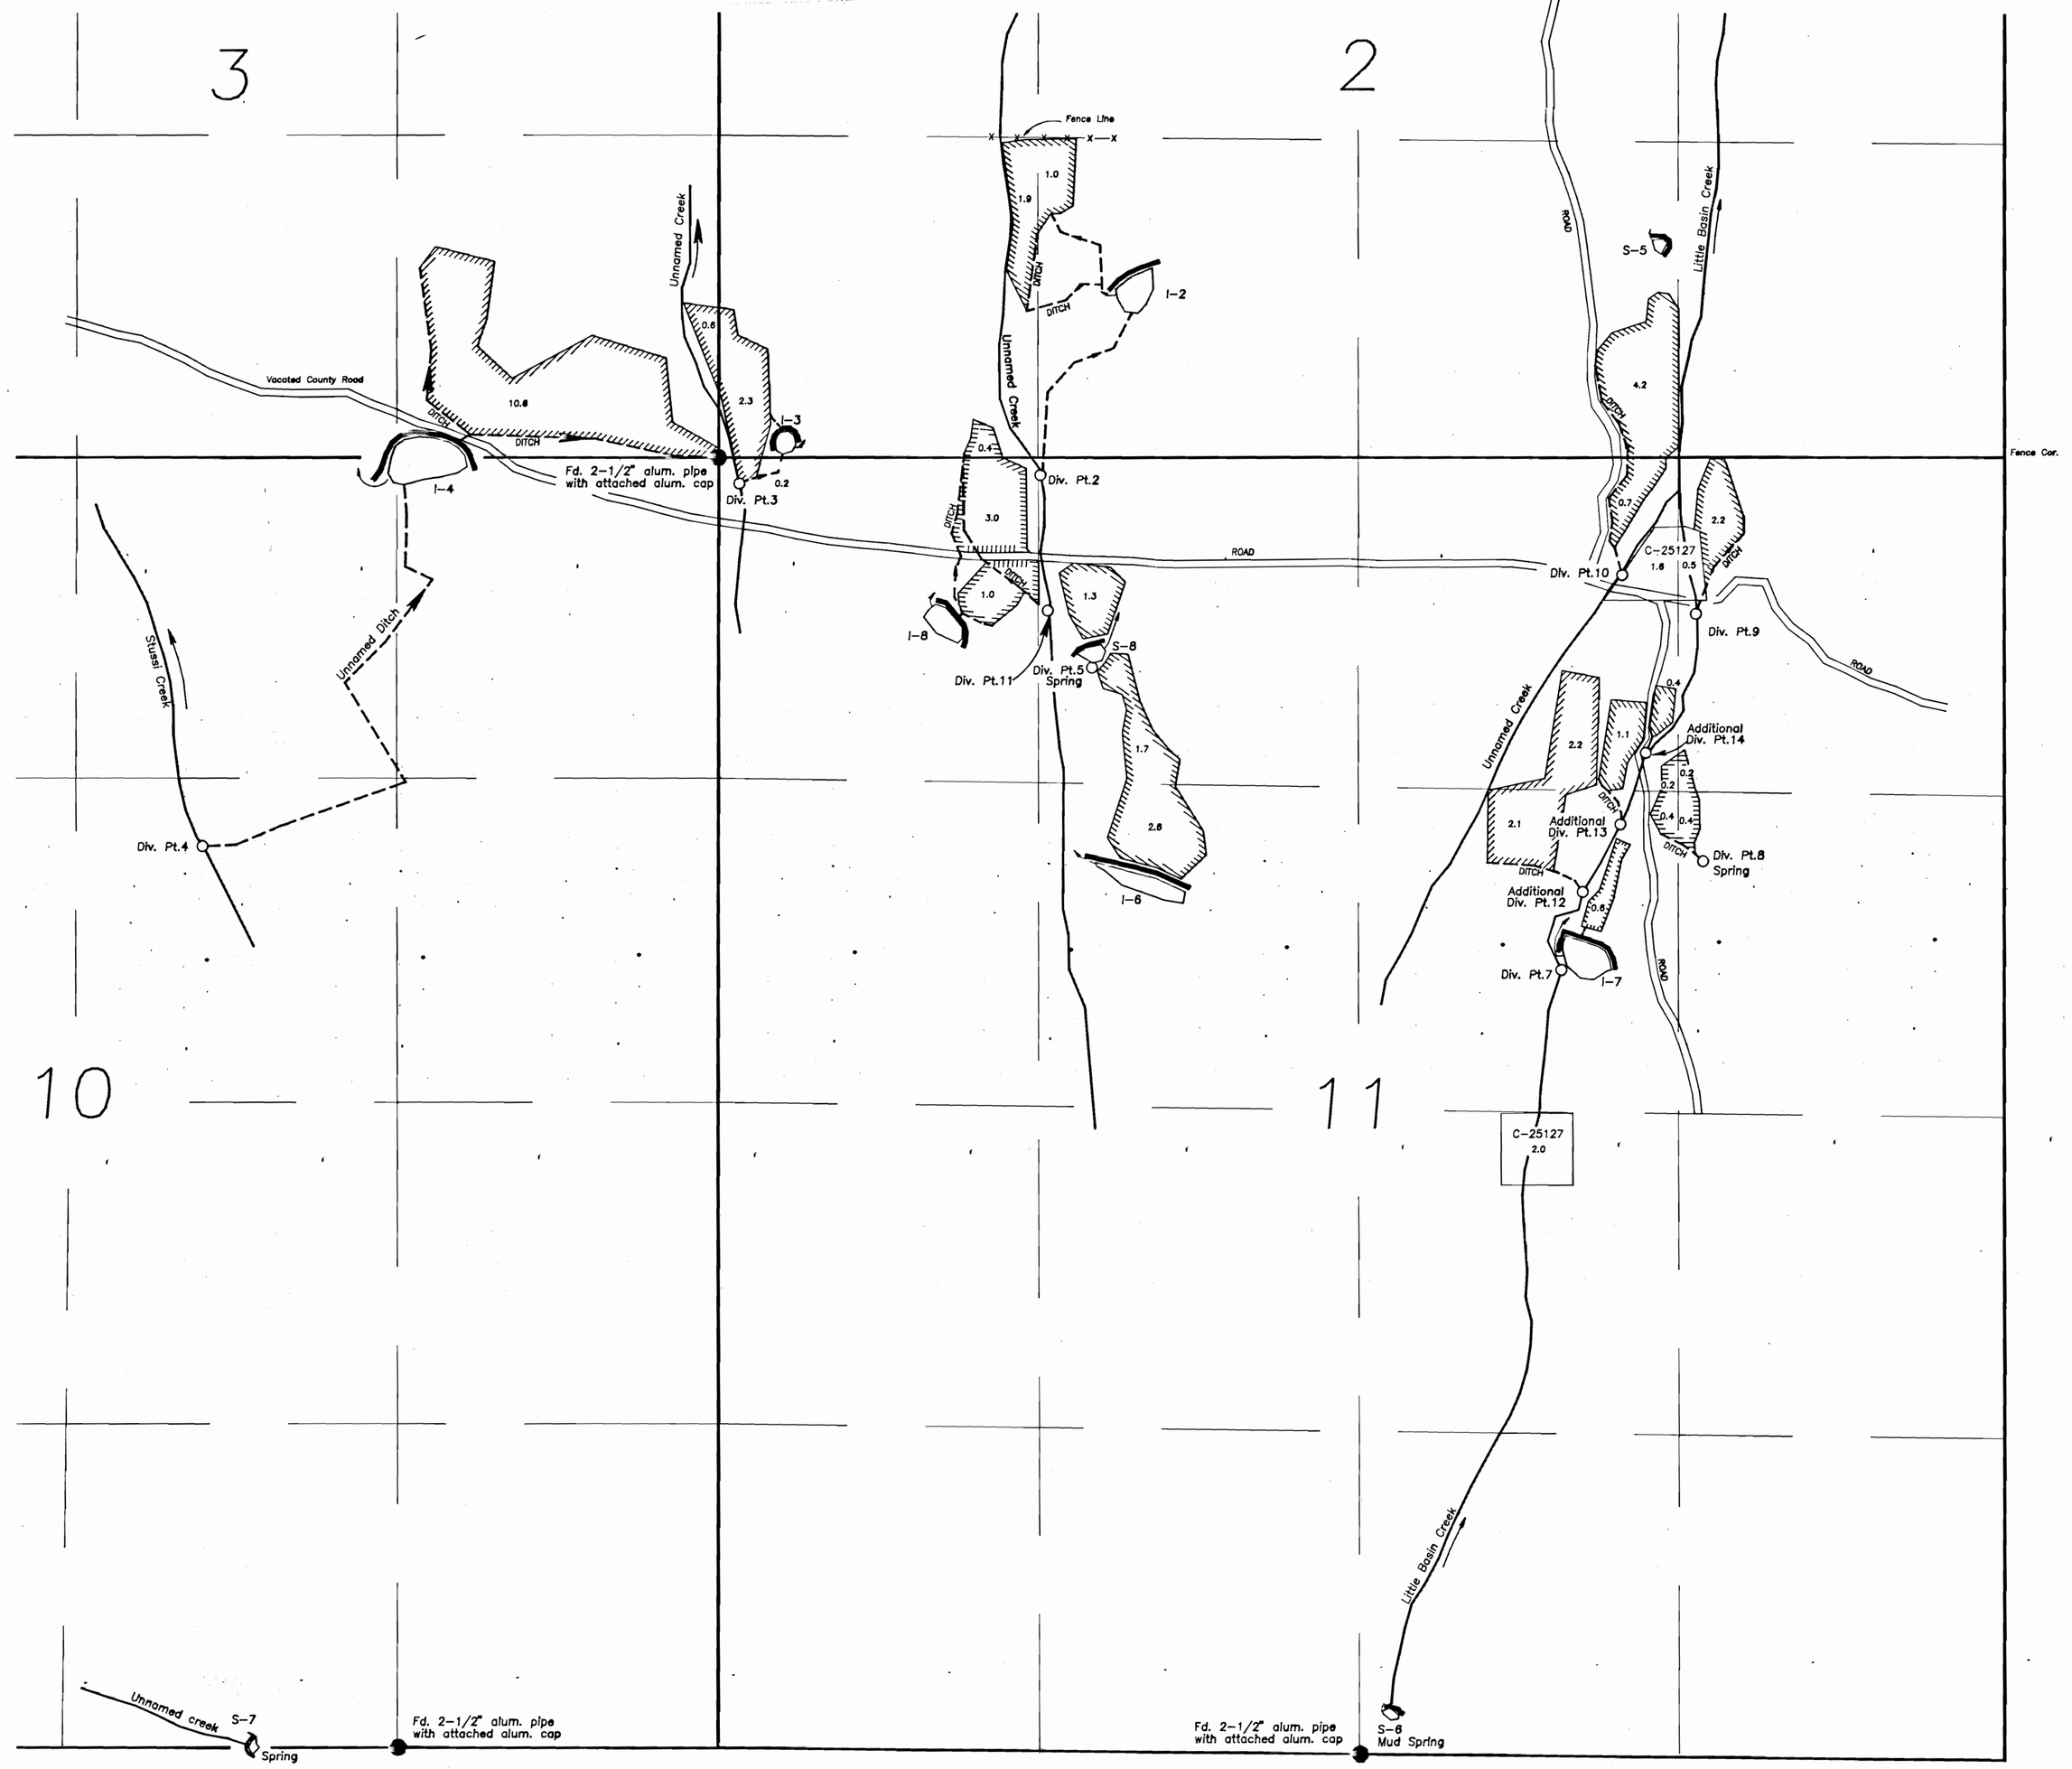

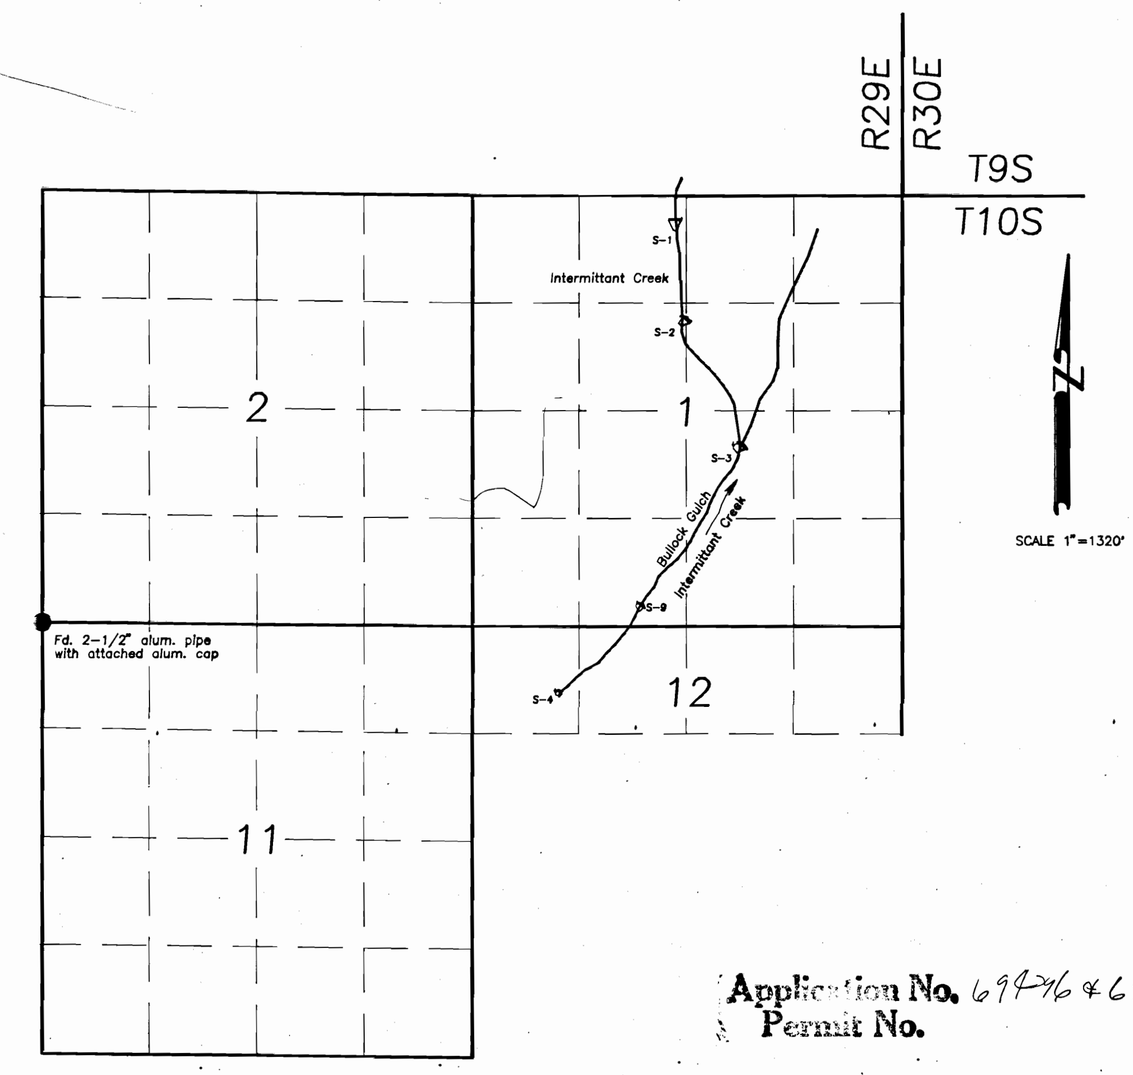



Application No. 69496 & 69497
Permit No.

FINAL PROOF SURVEY

UNDER

PERMIT NO. R-11105, P-50665

IN NAME OF

GEORGE W. AND MARCA L. GIRDNER

SURVEYED AUG. 5 & 8, 1994

NOTE: The preparation of this map was for the purpose of identifying the location of the proposed water right and has no intent to provide dimensions or location of property ownership lines. Location information shown hereon was furnished by the applicant.

Place of use

Certified Water Right Examiner
009
Robert D. Bagett
Nov.19, 1987
STATE OF OREGON

Stream and Spring Diversion Points

Div. Pt.2 70 ft. S. & 1330 ft. E. of the NW cor. Sec. 11
Div. Pt.3 110 ft. S. & 90 ft. E. of the NW cor. Sec. 11
Div. Pt.4 1600 ft. S. & 2130 ft. W. of the NW cor. Sec. 11
Div. Pt.5 860 ft. S. & 1540 ft. E. of the NW cor. Sec. 11
Div. Pt.7 2110 ft. S. & 3480 ft. E. of the NW cor. Sec. 11
Div. Pt.8 1660 ft. S. & 4060 ft. E. of the NW cor. Sec. 11
Div. Pt.9 640 ft. S. & 4030 ft. E. of the NW cor. Sec. 11
Div. Pt.10 480 ft. S. & 3730 ft. E. of the NW cor. Sec. 11
Div. Pt.11 620 ft. S. & 1330 ft. E. of the NW cor. Sec. 11
Div. Pt.12 1780 ft. S. & 3570 ft. E. of the NW cor. Sec. 11
Div. Pt.13 1510 ft. S. & 3720 ft. E. of the NW cor. Sec. 11
Div. Pt.14 1210 ft. S. & 3830 ft. E. of the NW cor. Sec. 11

Stock Reservoirs

S-1 4920 ft. N. & 7770 ft. E. of the NW cor. Sec. 11
S-2 3720 ft. N. & 7910 ft. E. of the NW cor. Sec. 11
S-3 2170 ft. N. & 8610 ft. E. of the NW cor. Sec. 11
S-4 870 ft. S. & 6370 ft. E. of the NW cor. Sec. 11
S-5 900 ft. N. & 3920 ft. E. of the NW cor. Sec. 11
S-6 190 ft. N. & 140 ft. E. of the S1/4 cor. Sec. 11
S-7 0.0 ft. N. & 600 ft. W. of SE cor. of the SW1/4SE1/4 Sec.10
S-8 770 ft. S. & 1520 ft. E. of the NW cor. Sec. 11
S-9 210 ft. N. & 7370 ft. E. of the NW cor. Sec. 11

Irrigation Reservoirs

I-1 (I-1 application) changed to S-9 Final Proof.
I-2 760 ft. N. & 1690 ft. E. of the NW cor. Sec. 11
I-3 120 ft. N. & 270 ft. E. of the NW cor. Sec. 11
I-4 400 ft. N. & 1240 ft. W. of the NW cor. Sec. 11
I-5 this designation not used.
I-6 1680 ft. S. & 1710 ft. E. of the NW cor. Sec. 11
I-7 1980 ft. S. & 3590 ft. E. of the NW cor. Sec. 11
I-8 660 ft. S. & 990 ft. E. of the NW cor. Sec. 11

RECEIVED
AUG 8 0 1994
WATER RESOURCES DEPT.
SALEM, OREGON

BAGETT - GRIFFITH & ASSOCIATES
John Day, Oregon

MAP OF FINAL PROOF SURVEY
UNDER PERMIT NO. R-11105 AND P-50665
SITUATED IN SECTIONS 1, 2, 3, 10, 11, 12 AND 13,
T10S, R29E, W.M.

GRANT COUNTY, OREGON

SURVEYED FOR	GEORGE AND MARCA GIRDNER	
SURVEYED BY	ROB & SDF & GJR & DEM & RJL	Aug. 5 & 8 1994
Scale: 1"=400'	Drawn by: J.L.W.	

IDAHO BLUEPRINT & SUP. CO. INC. - BOISE, IDAHO