



D 14 13

T10S R29E W.M.

T9S
R30E
R29E

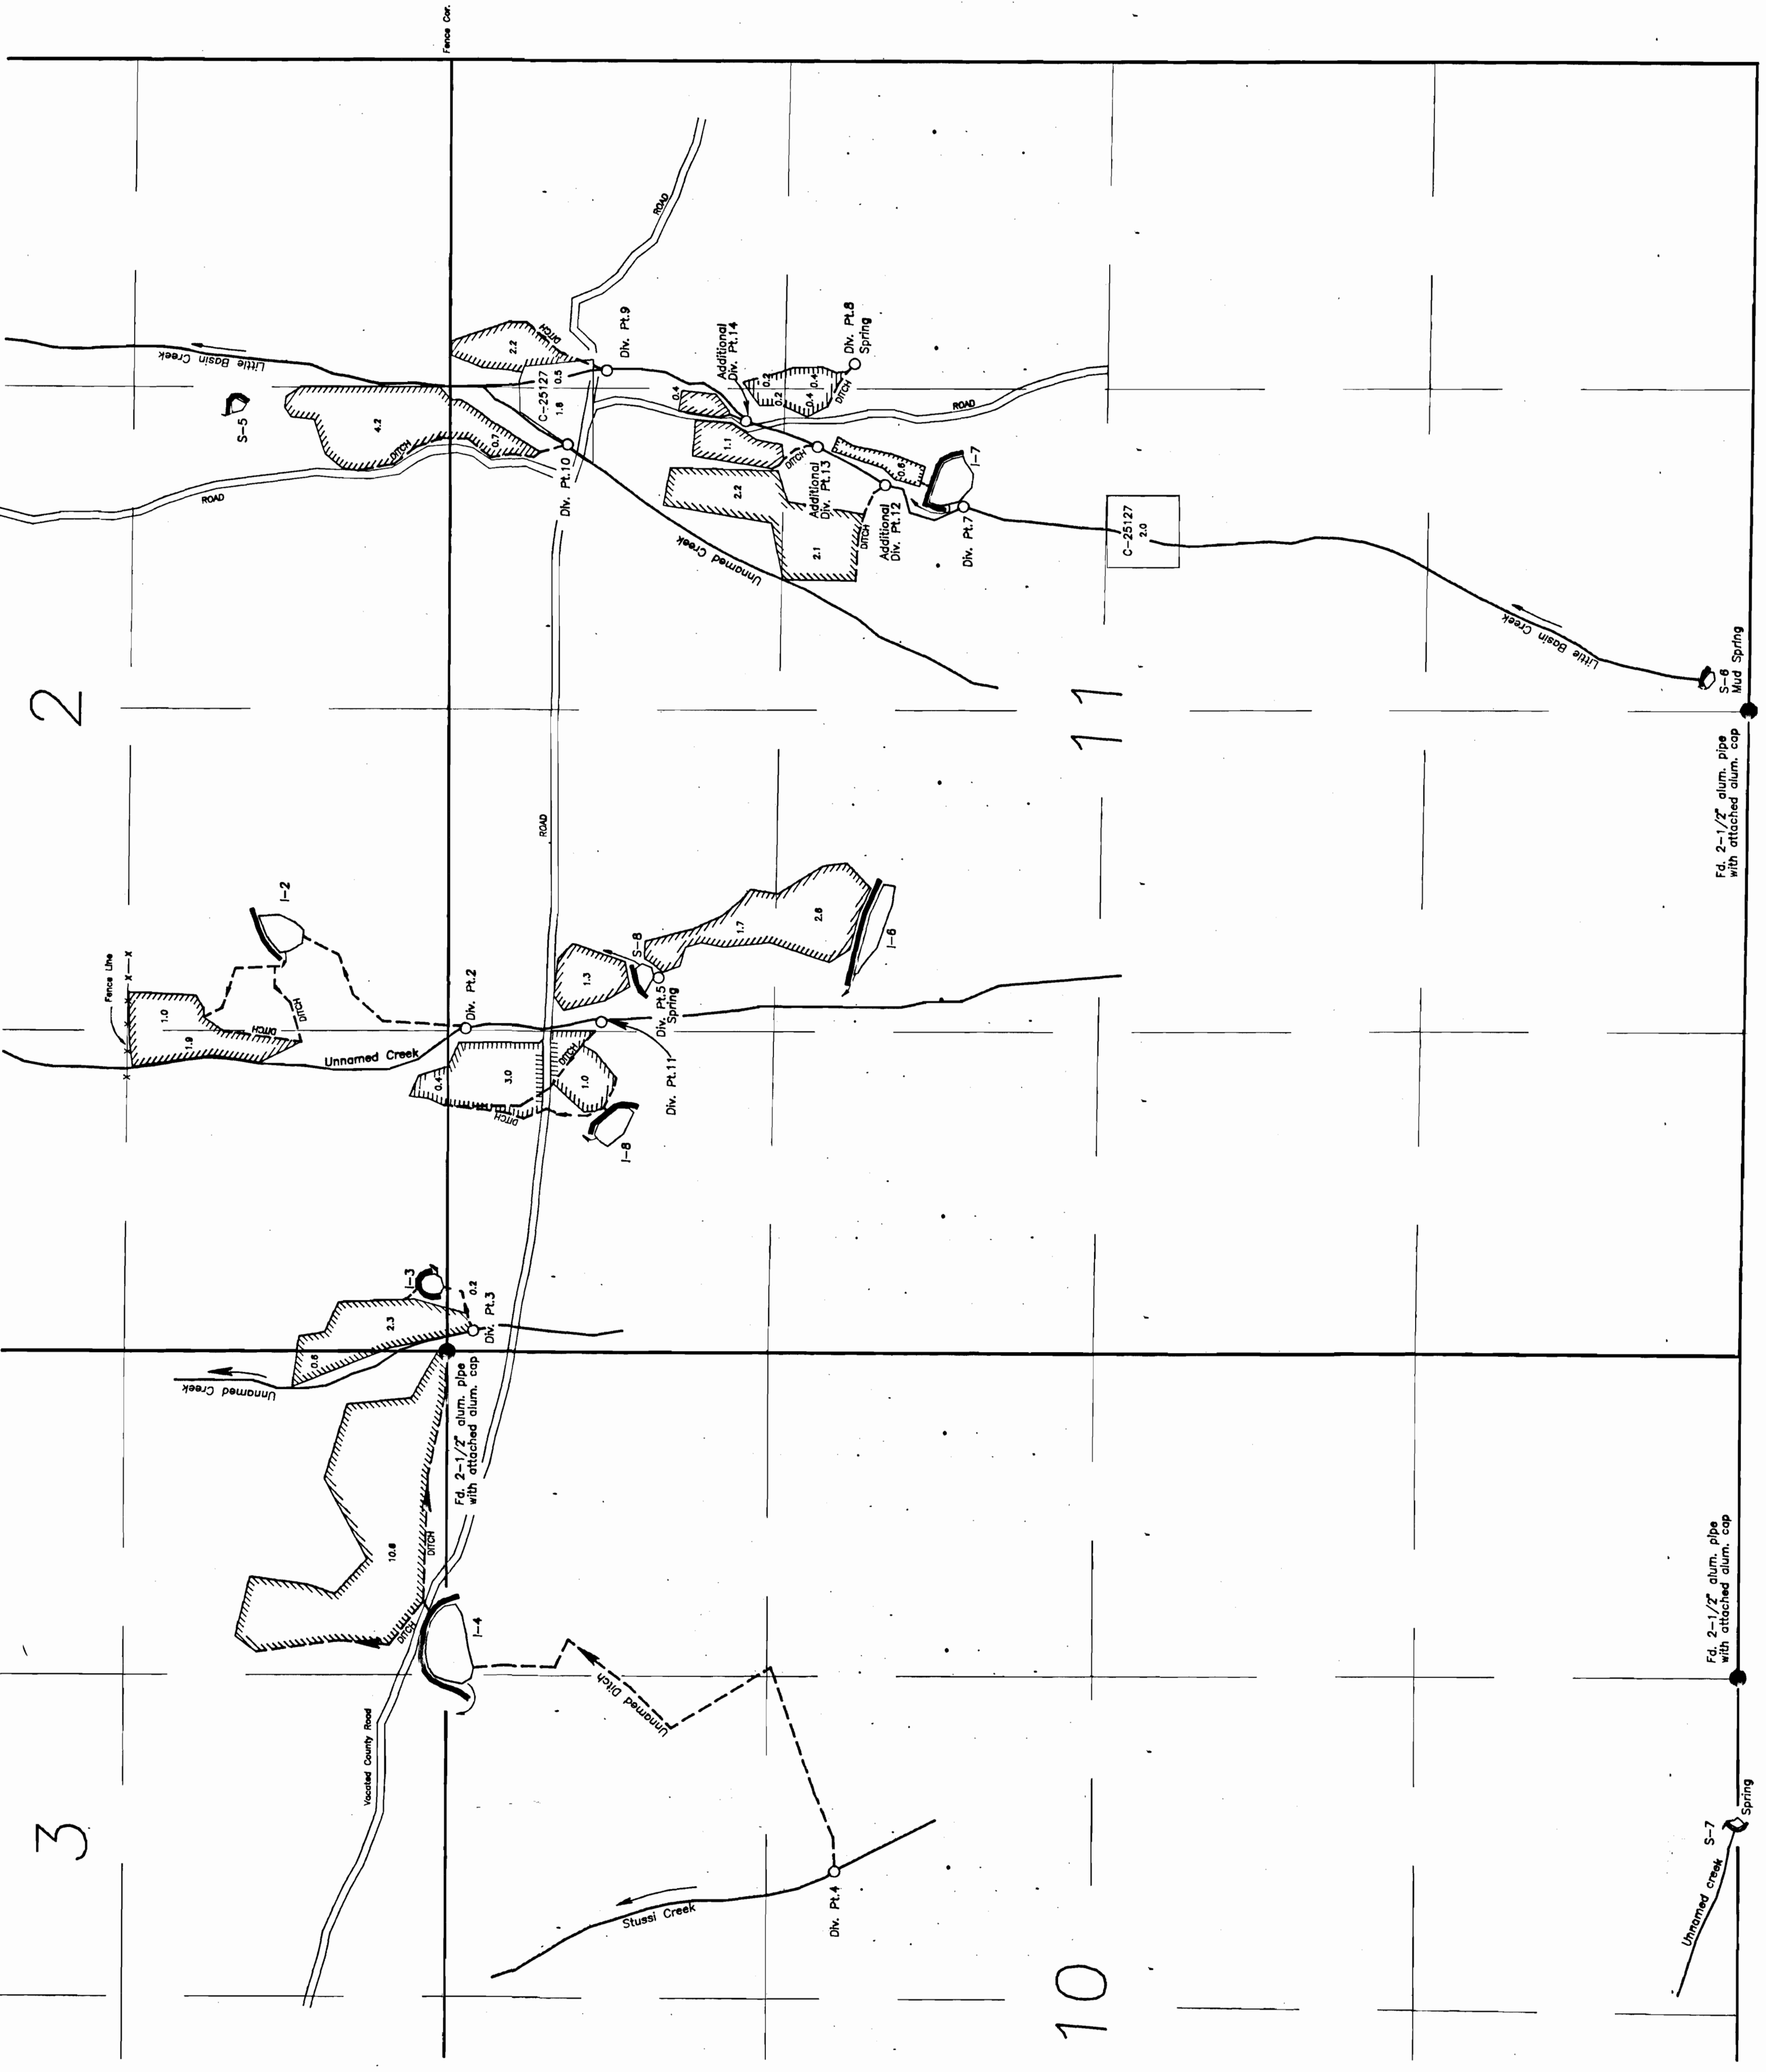

T10S
R30E
R29E

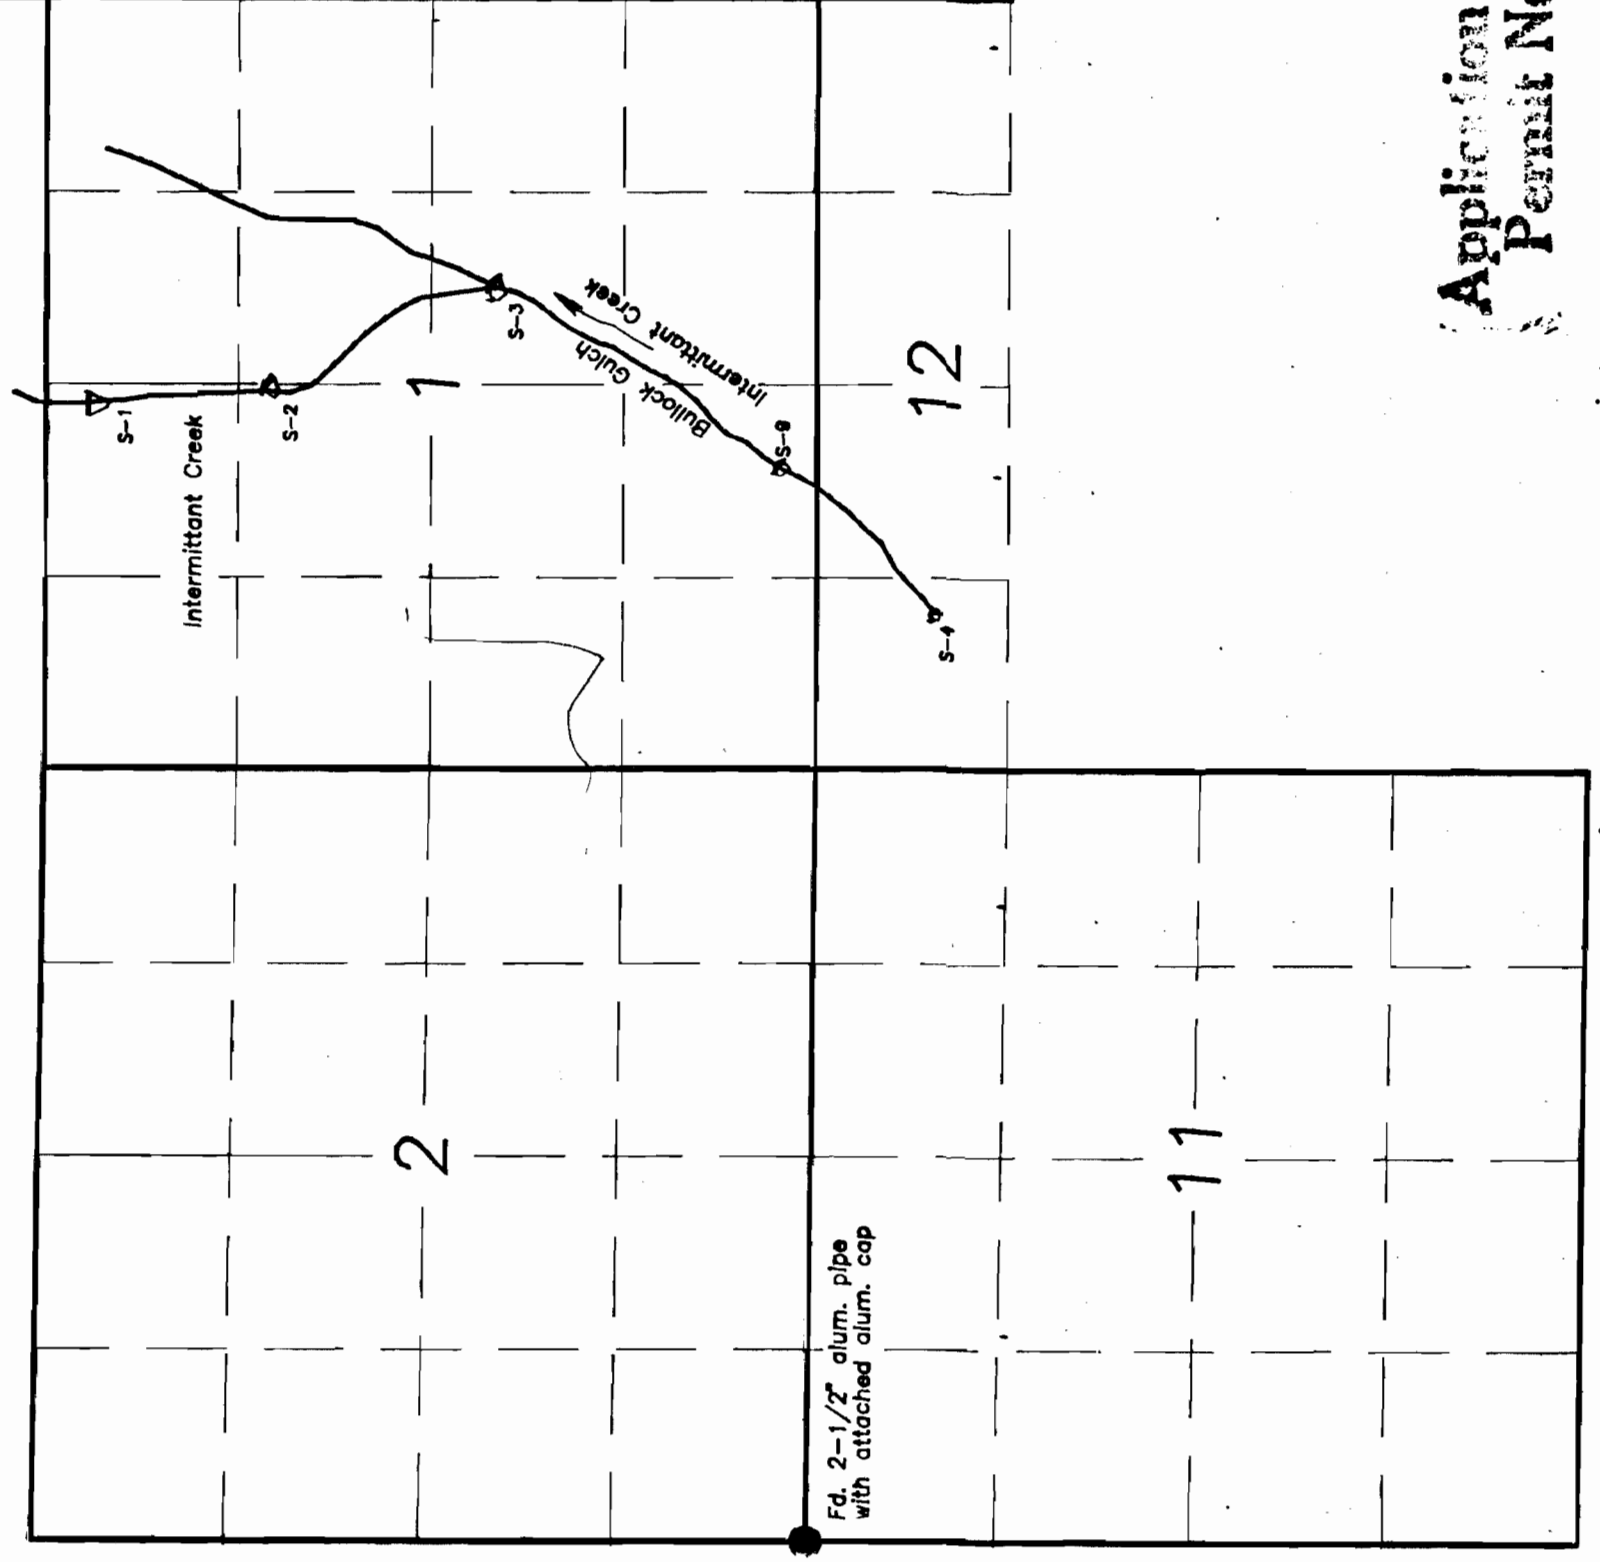

Application No. 69476 & 69477
Permit No.

Stream and Spring Diversion Points

- D.N. P.L. 2 70 ft. S. & 1330 ft. E. of the NW cor. Sec. 11
- D.N. P.L. 3 110 ft. S. & 90 ft. E. of the NW cor. Sec. 11
- D.N. P.L. 4 180 ft. S. & 1540 ft. E. of the NW cor. Sec. 11
- D.N. P.L. 5 860 ft. S. & 1540 ft. E. of the NW cor. Sec. 11






FINAL PROOF SURVEY

PERMIT NO. R-1105, P-50855
IN WELLS OF
GEORGE W. AND MARCA L. GIRDNER
SURVEYED AUG. 5 & 6, 1994

NOTE: The preparation of this map was based on the original survey data and the location of the proposed wells, diversions or locations of property shown hereon was furnished by the applicant.

Place of use

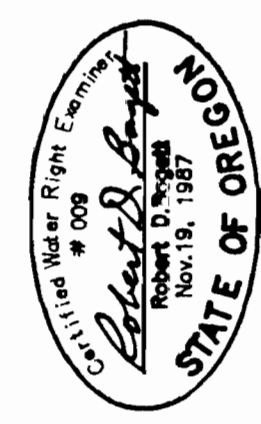

RECEIVED
JUL 30 1994

BAGETT - GRIFFITH & ASSOCIATES	
DATE	04/28/94
MAP OF FINAL PROOF SURVEY	
SITUATED IN SECTIONS 1, 2, 3, 10, 11, 12 AND 13,	
T10S, R29E, W.M.	
GRANT COUNTY, OREGON	
SURVEYED FOR	GEORGE AND MARCA GIRDNER
Scale: 1"=400'	Drawn by: J.L.W.
Aug. 1994	