


NE 1/4 SEC. 20 T7S R2W WM, MARION COUNTY

ADJUSTED CORRECTED

APPROX SCALE 1" = 400 FT.

7

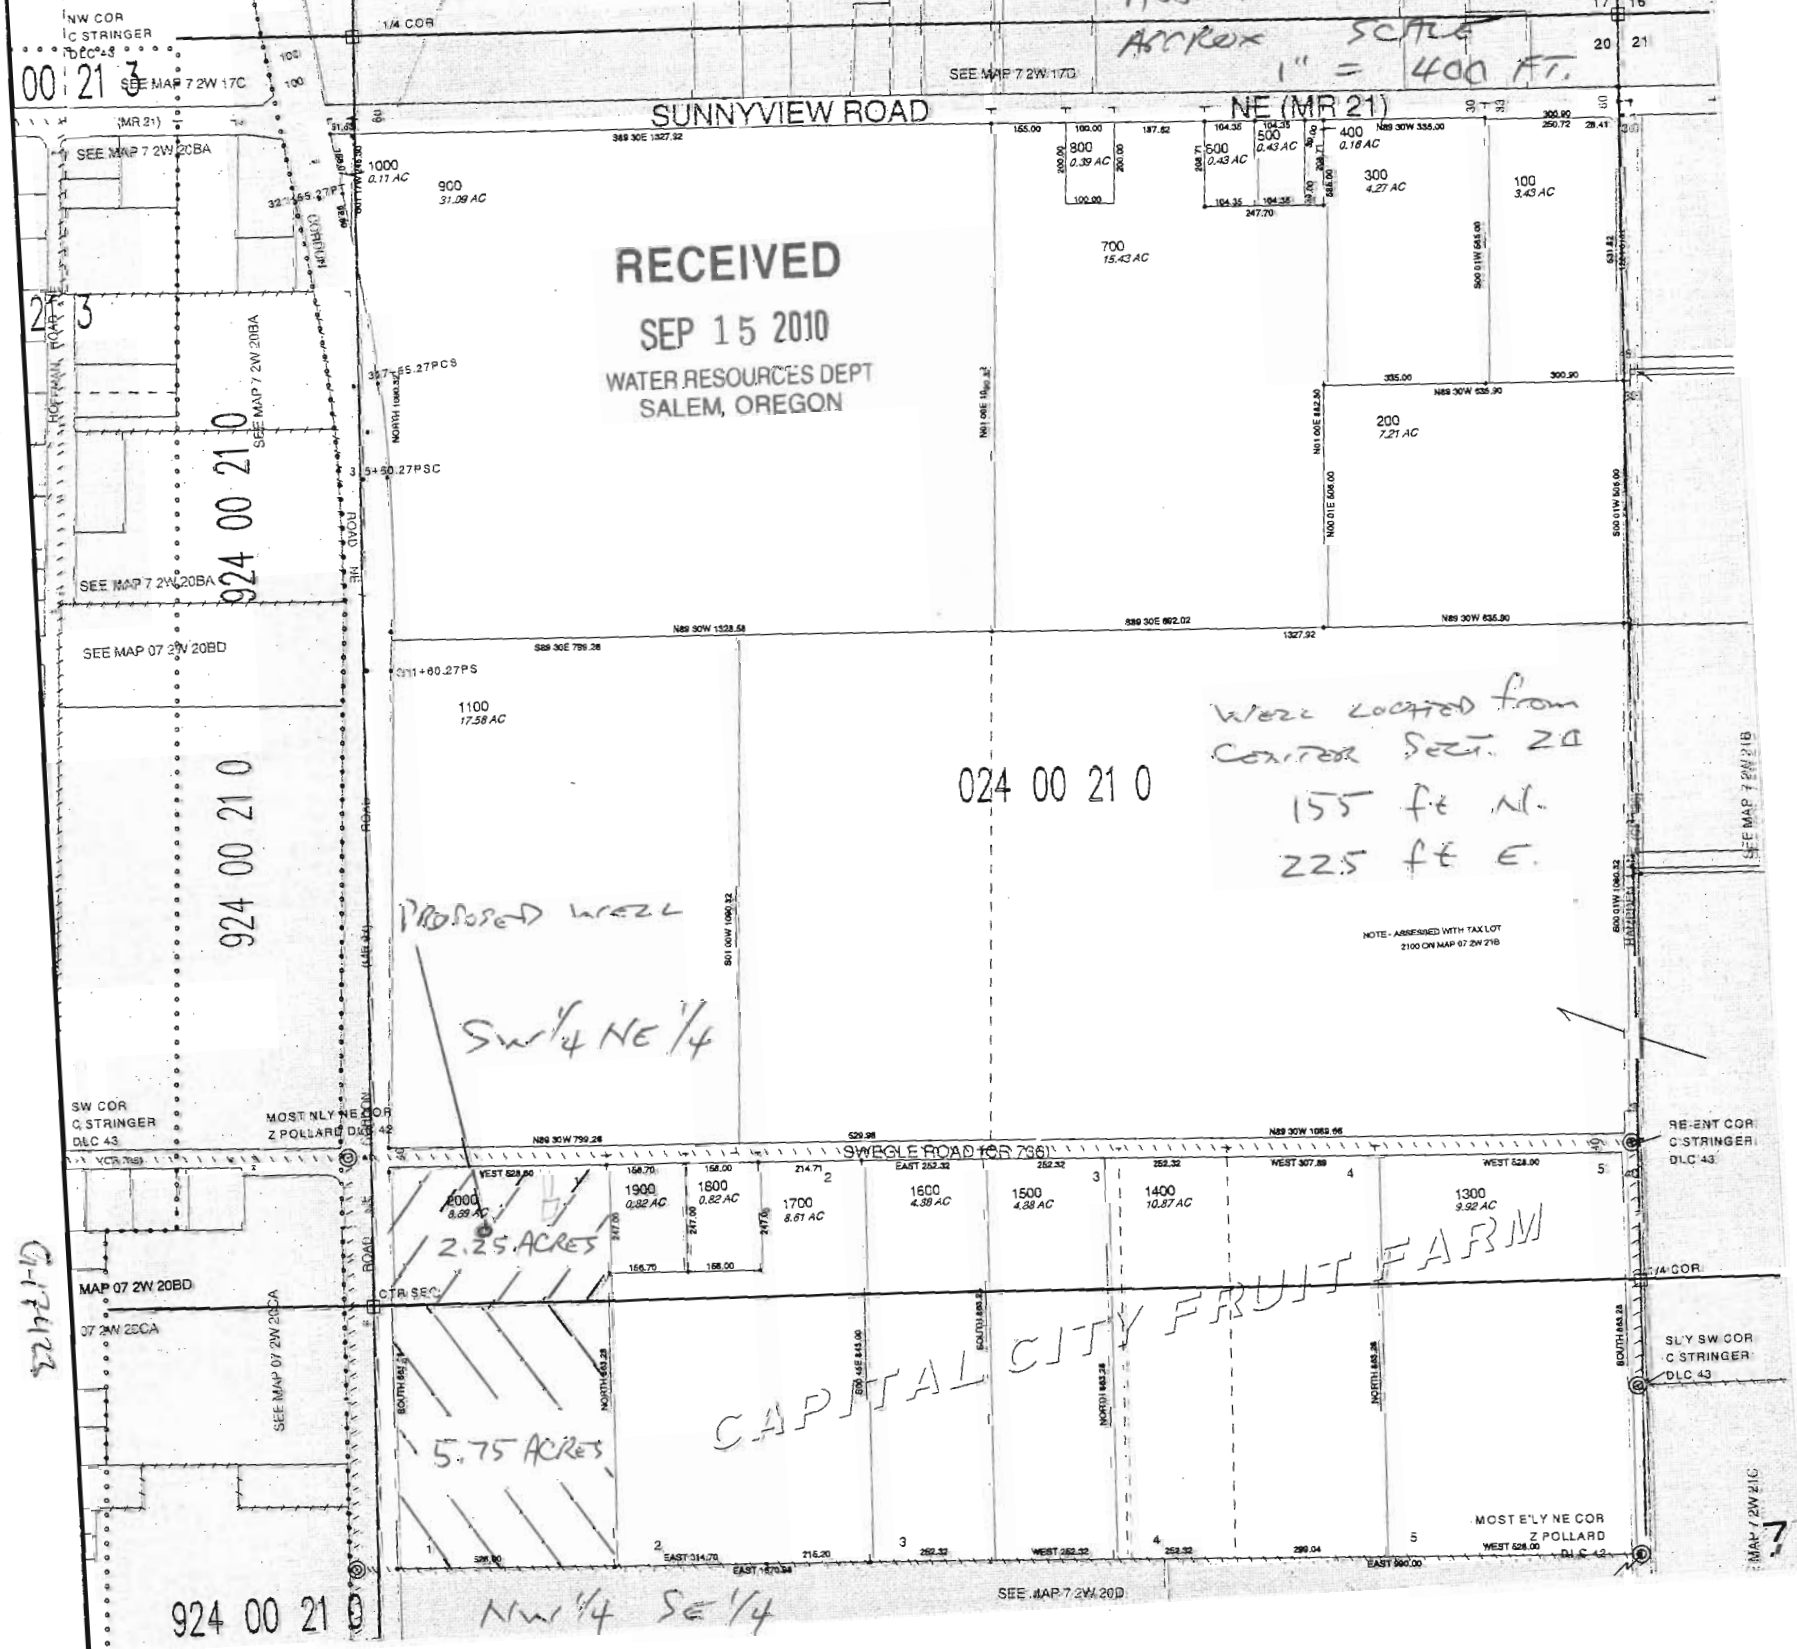

D-17422

SEE MAP 7 2W 21B

MAP 7 2W 21C