




UNITED STATES FOREST SERVICE C/O MT. BACHELOR INC.
CLAIM OF BENEFICIAL USE MAP
APPLICATION SEPTEMBER 2, 2010
SERIAL G-12885
LOCATED WITHIN TOWNSHIP 18 SOUTH, RANGE 9 EAST, W.M.,
TOWNSHIP 18 SOUTH, RANGE 8 EAST, W.M.,
TOWNSHIP 19 SOUTH, RANGE 9 EAST, W.M.

- LEGEND**
- EXISTING WELL LOCATION
 - SECTION LINE
 - QUARTER SECTION LINE
 - SIXTEENTH SECTION LINE
 - AREA OF USE FOR QUASI-MUNICIPAL WATER RIGHT (PERMIT G-12885)

POINT OF APPROPRIATION (MTB-02):
TOWNSHIP 18 SOUTH, RANGE 9 EAST, W.M., SECTION 20,
SE1/4, NW 1/4.
LOCATION: 1447' SOUTH AND 2256' EAST FROM THE
NORTHWEST CORNER OF SECTION 20.

COBU MAP # 0538

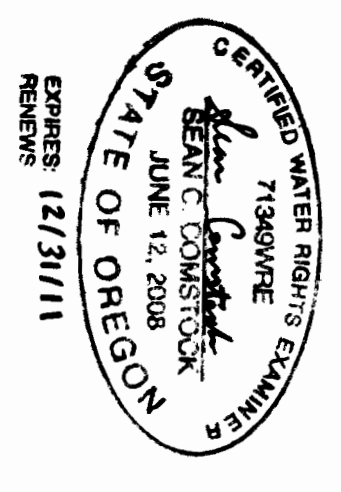

NOTE: THIS MAP WAS PREPARED FOR THE PURPOSE
OF IDENTIFYING THE LOCATION OF WATER RIGHTS
THIS MAP IS NOT INTENDED TO PROVIDE LEGAL DIMENSIONS
OR LOCATIONS OF PROPERTY OWNERSHIP LINES.

NOTE: THE LOCATIONS OF FEATURES SHOWN ON THIS MAP
WERE OBTAINED FROM WHPACIFIC AS-BUILT CONSTRUCTION
DRAWINGS. WHPACIFIC SURVEY TOPOGRAPHIC DATA,
DESCHUTES COUNTY GIS, FIELD MAPPING USING A
GEOEXPLORER MODEL NUMBER 79000-00 HAND HELD GPS
RECEIVER, AERIAL AUTOCAD INFORMATION AND FROM
INTERVIEWING MT. BACHELOR INC. STAFF.

