


Item 45

WATER RIGHTS APPLICATION MAP

TAX LOTS 103, 104, AND 110 IN TAX MAP FOR SECTION 6, T7S, R4W, WM. POLK COUNTY, OREGON

WORK COPY

FOR CLARITY THE LOCATION OF POD'S IS LISTED HERE:
POD RES. I: 1115 SOUTH AND 3673 WEST,
POD RES. J: 717 SOUTH AND 2685 WEST
POD. RES. K: 270 SOUTH AND 1354 WEST,
POD. RES. L: 640 SOUTH AND 1103 WEST,
POD. RES. M: 945 SOUTH AND 808 WEST,
FEET FROM THE NE CORNER SECTION 6.

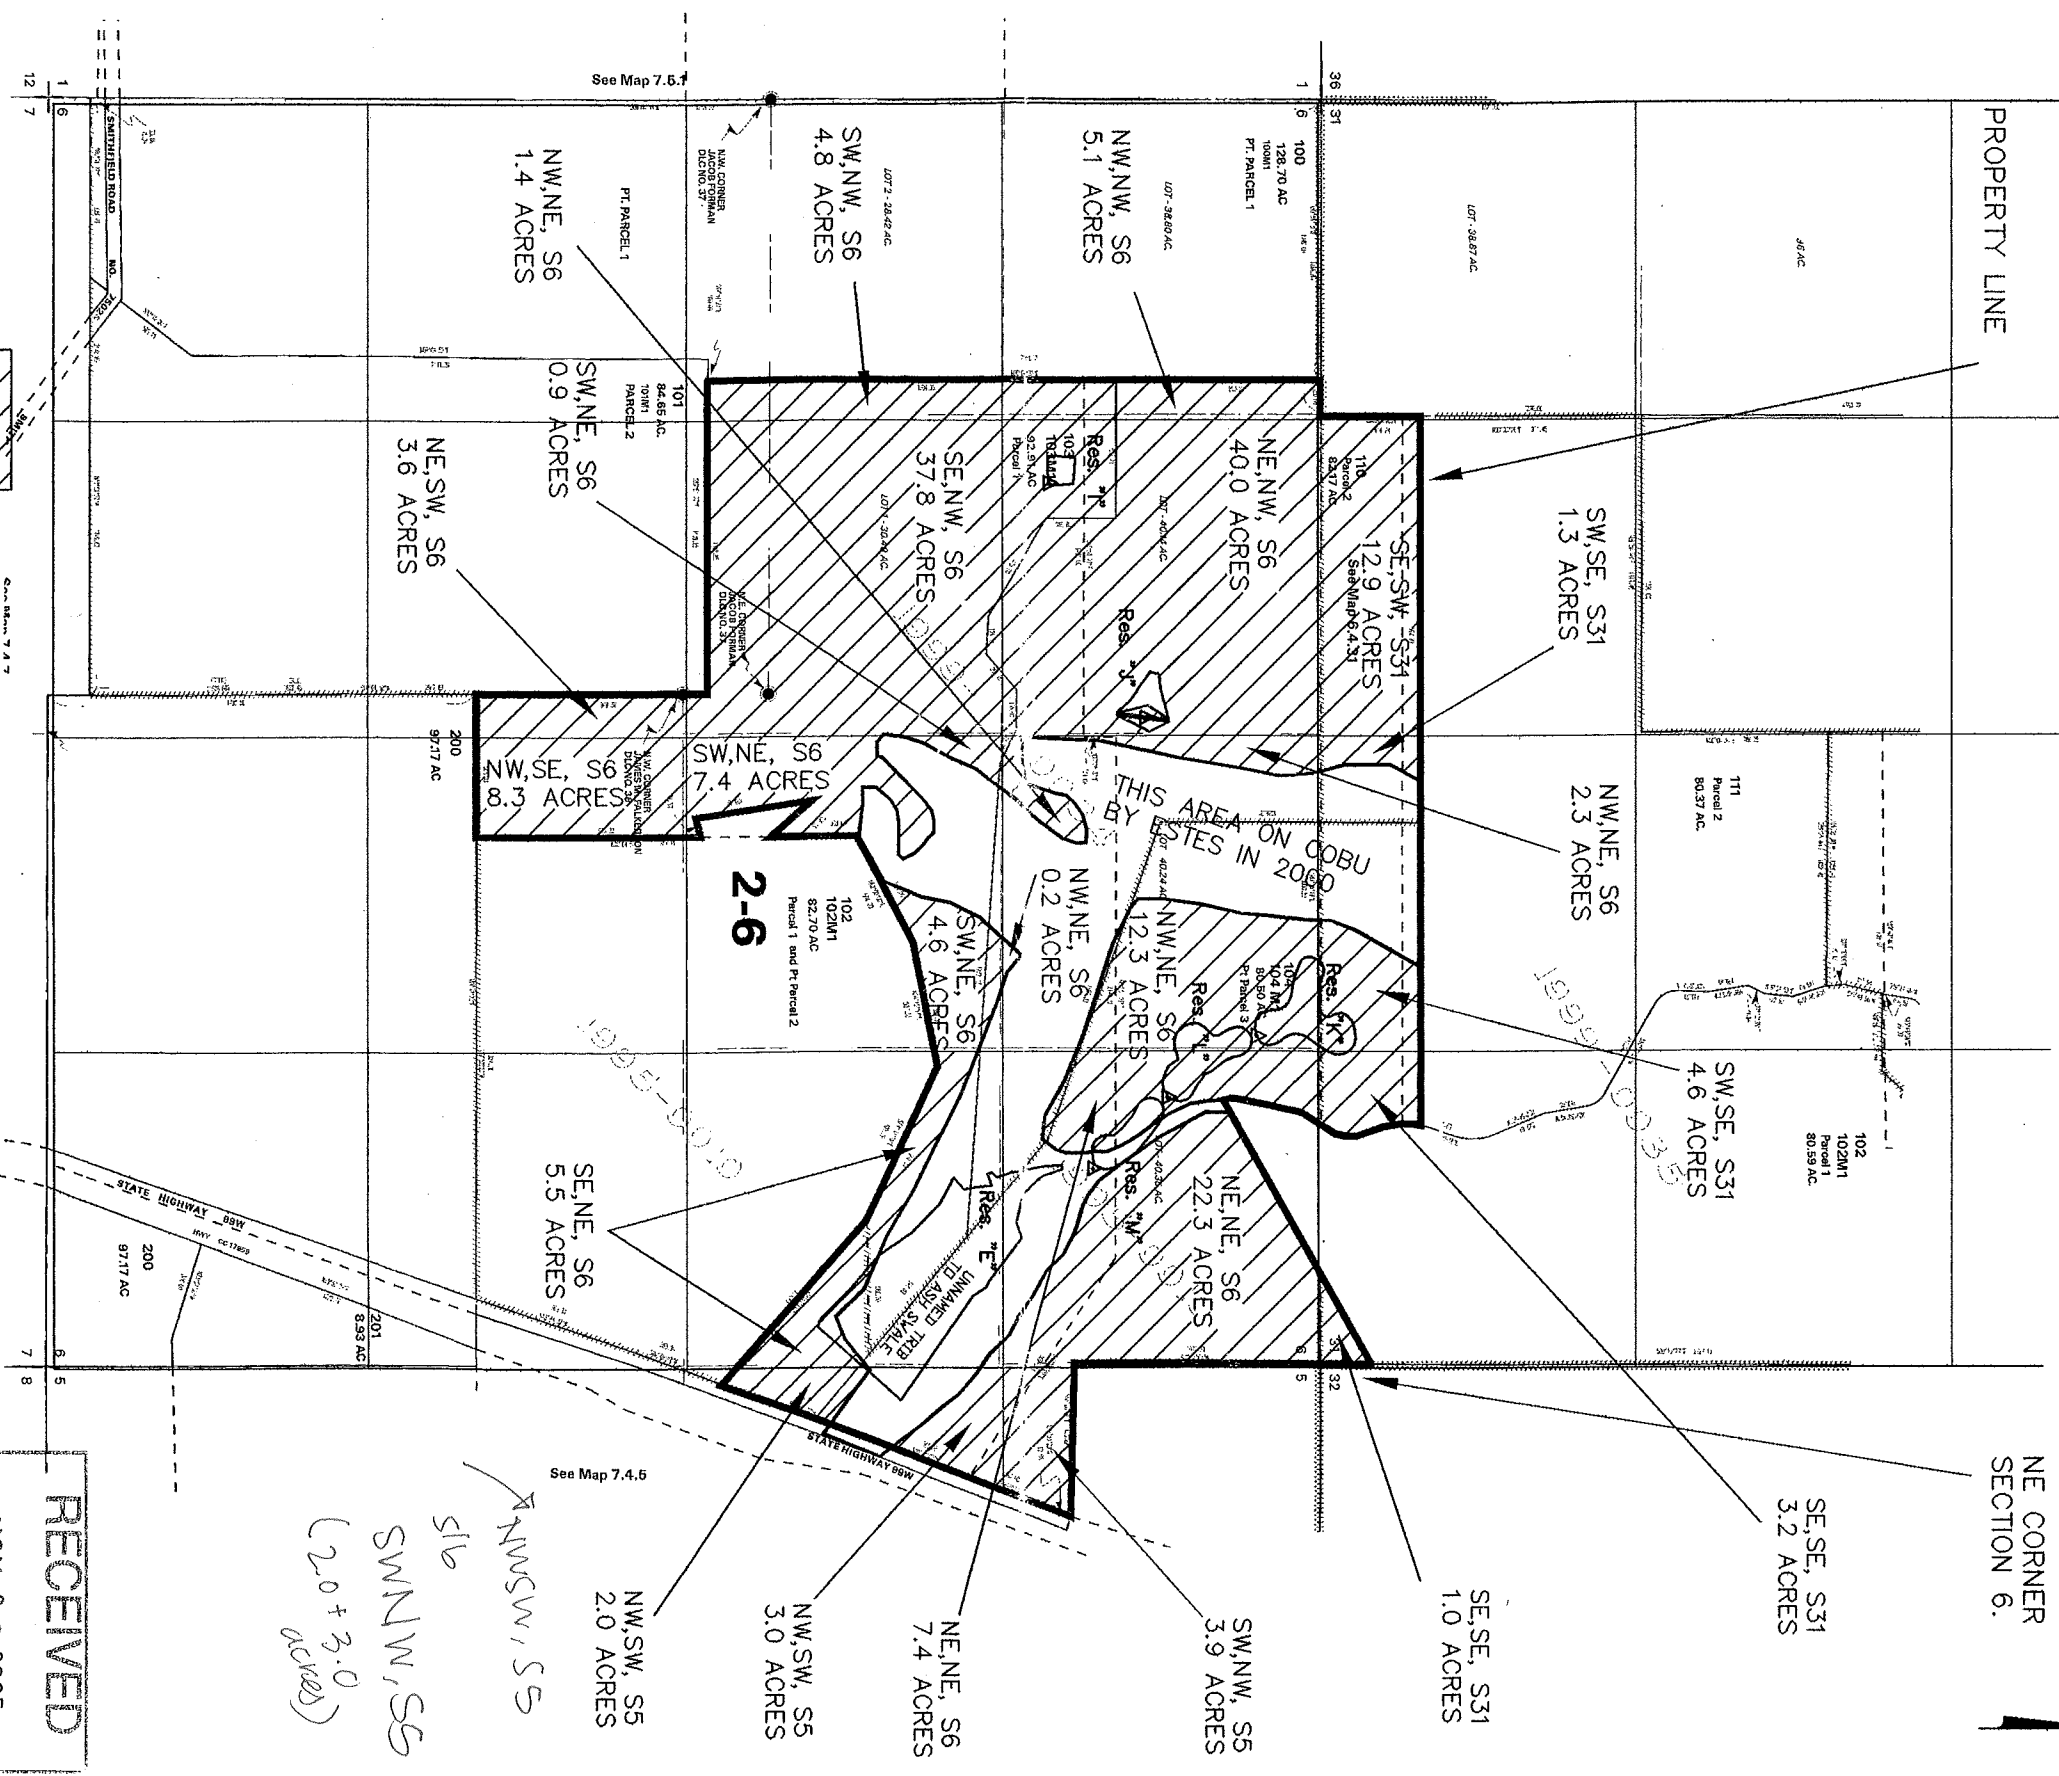

acres new irrigation



RECEIVED
 NOV 08 2005
 WATER RESOURCES DEPT
 SALEM, OREGON

MAP FOR:
 GET REALTY TRUST
 c/o Thomas Sorensen, trustee

Project: 3062074LEFT-COAST

Drawing: 3052074N

By: Eric Urstadt

Date: 28 SEP 2005



EXAMINERS DISCLAIMER STATEMENT

The preparation of this map was for the purpose of identifying the location of the Water Right only and has no intent to provide dimensions or location of property ownership lines.

PROPERTY LINES, ACRES, AND LINES ARE BASED ON SCALED AERIAL PHOTOS, TAX MAPS, AND COBU MAP BY ESTES IN 2000 AND NOT FIELD MEASUREMENTS.

Certified Water Right Examiner
 #385

Eric A. Urstadt
 May, 11 1994

STATE OF OREGON
 EXPIRES 6/30/2006

ANSW, S5
 slb
 SWNW, S5
 (2.0 + 3.0 acres)

5-86459