
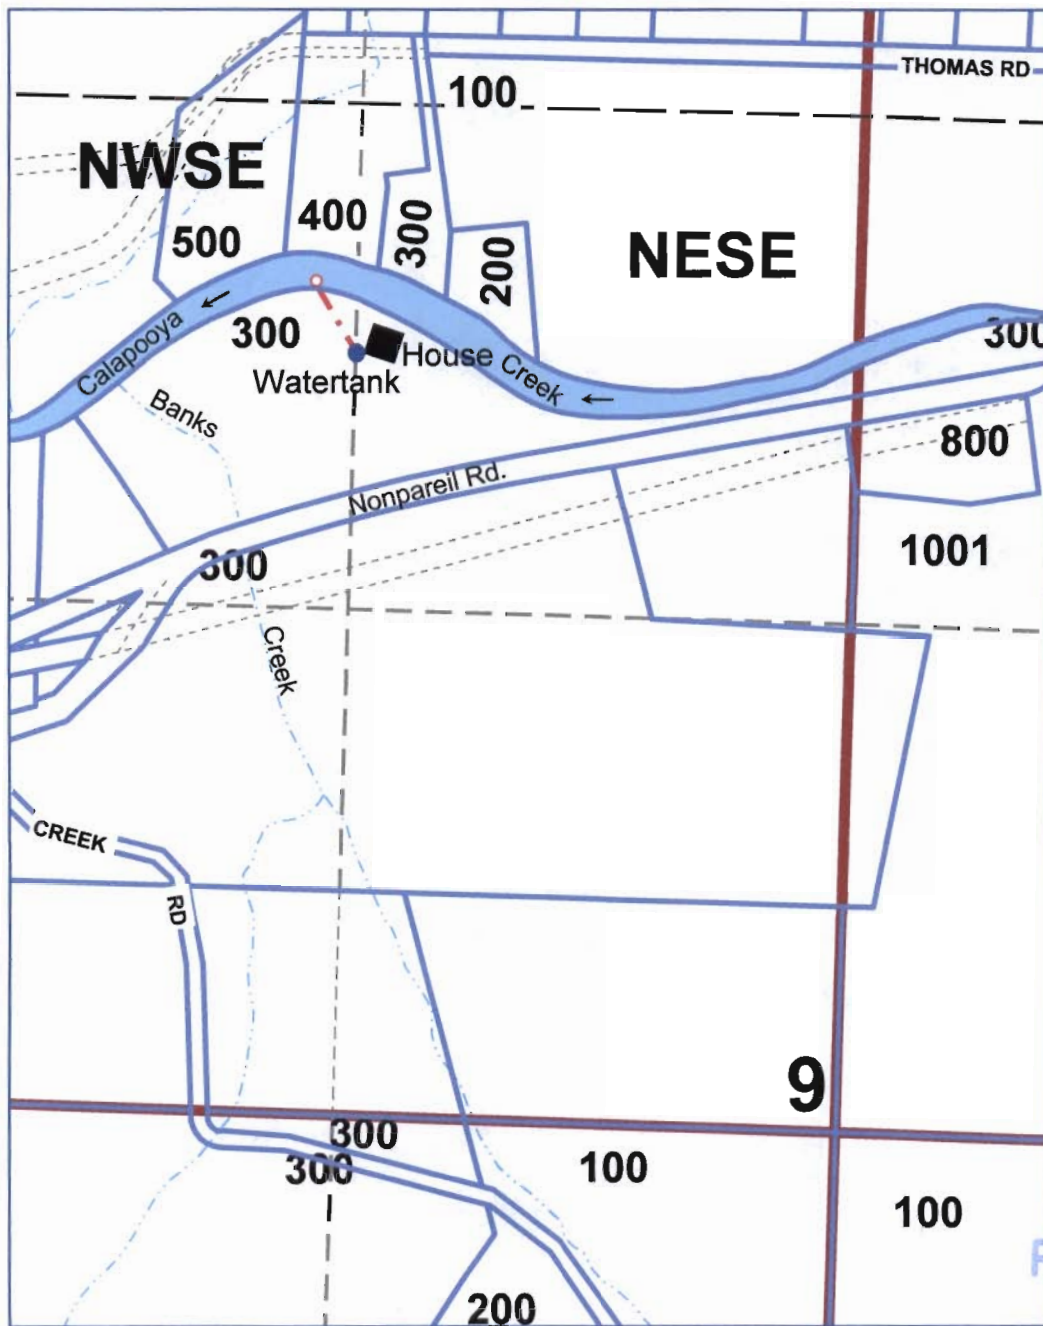


SEC.9 T.25S. R.4W. W.M.
DOUGLAS COUNTY
Scale 1" = 500'

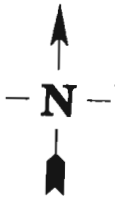

POD is 2180 ft. north and 2200 west from the SE corner of Section 9.

RECEIVED

NOV 09 2010

WATER RESOURCES DEPT
SALEM, OREGON

S-87665

1410 JS