


T35S R7W Sec14

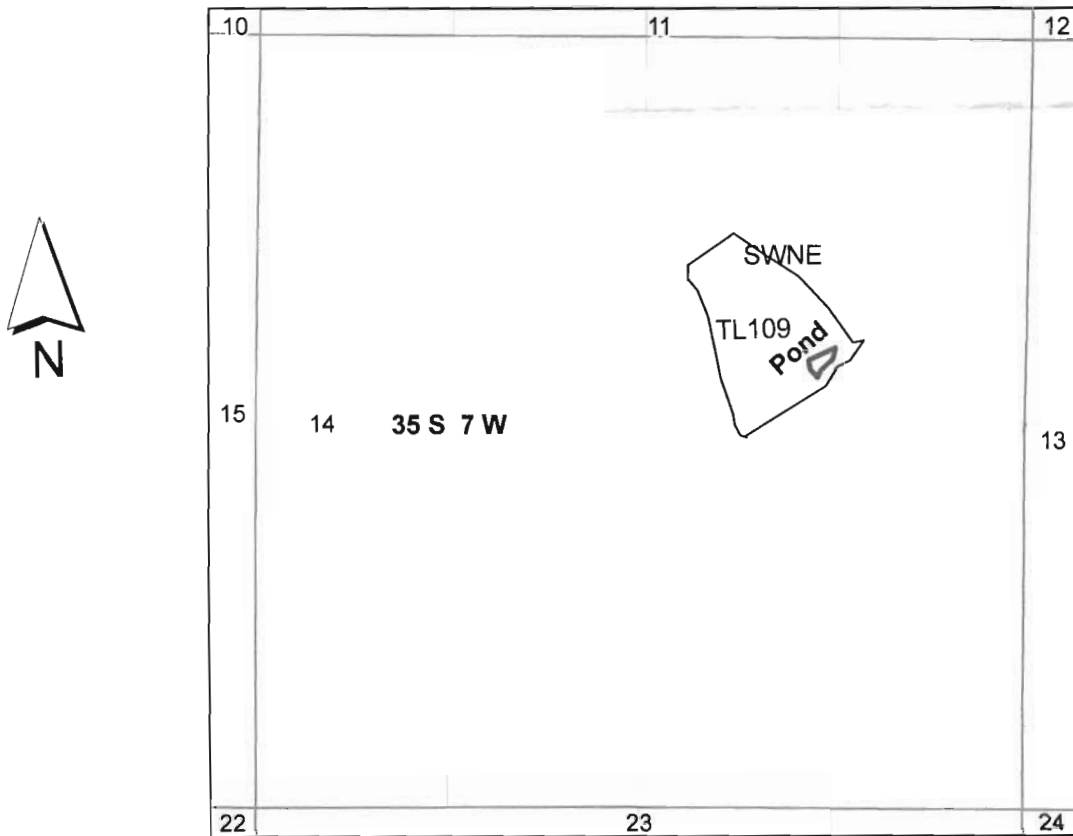

1 inch = 1,320 feet

Pond is 430 feet north and 1402 feet west from east corner of T35S R7W Sec 14

R-87669

RECEIVED
DEC 02 2010
WATER RESOURCES DEPT
SALEM, OREGON