


# 36S-3W-22-501

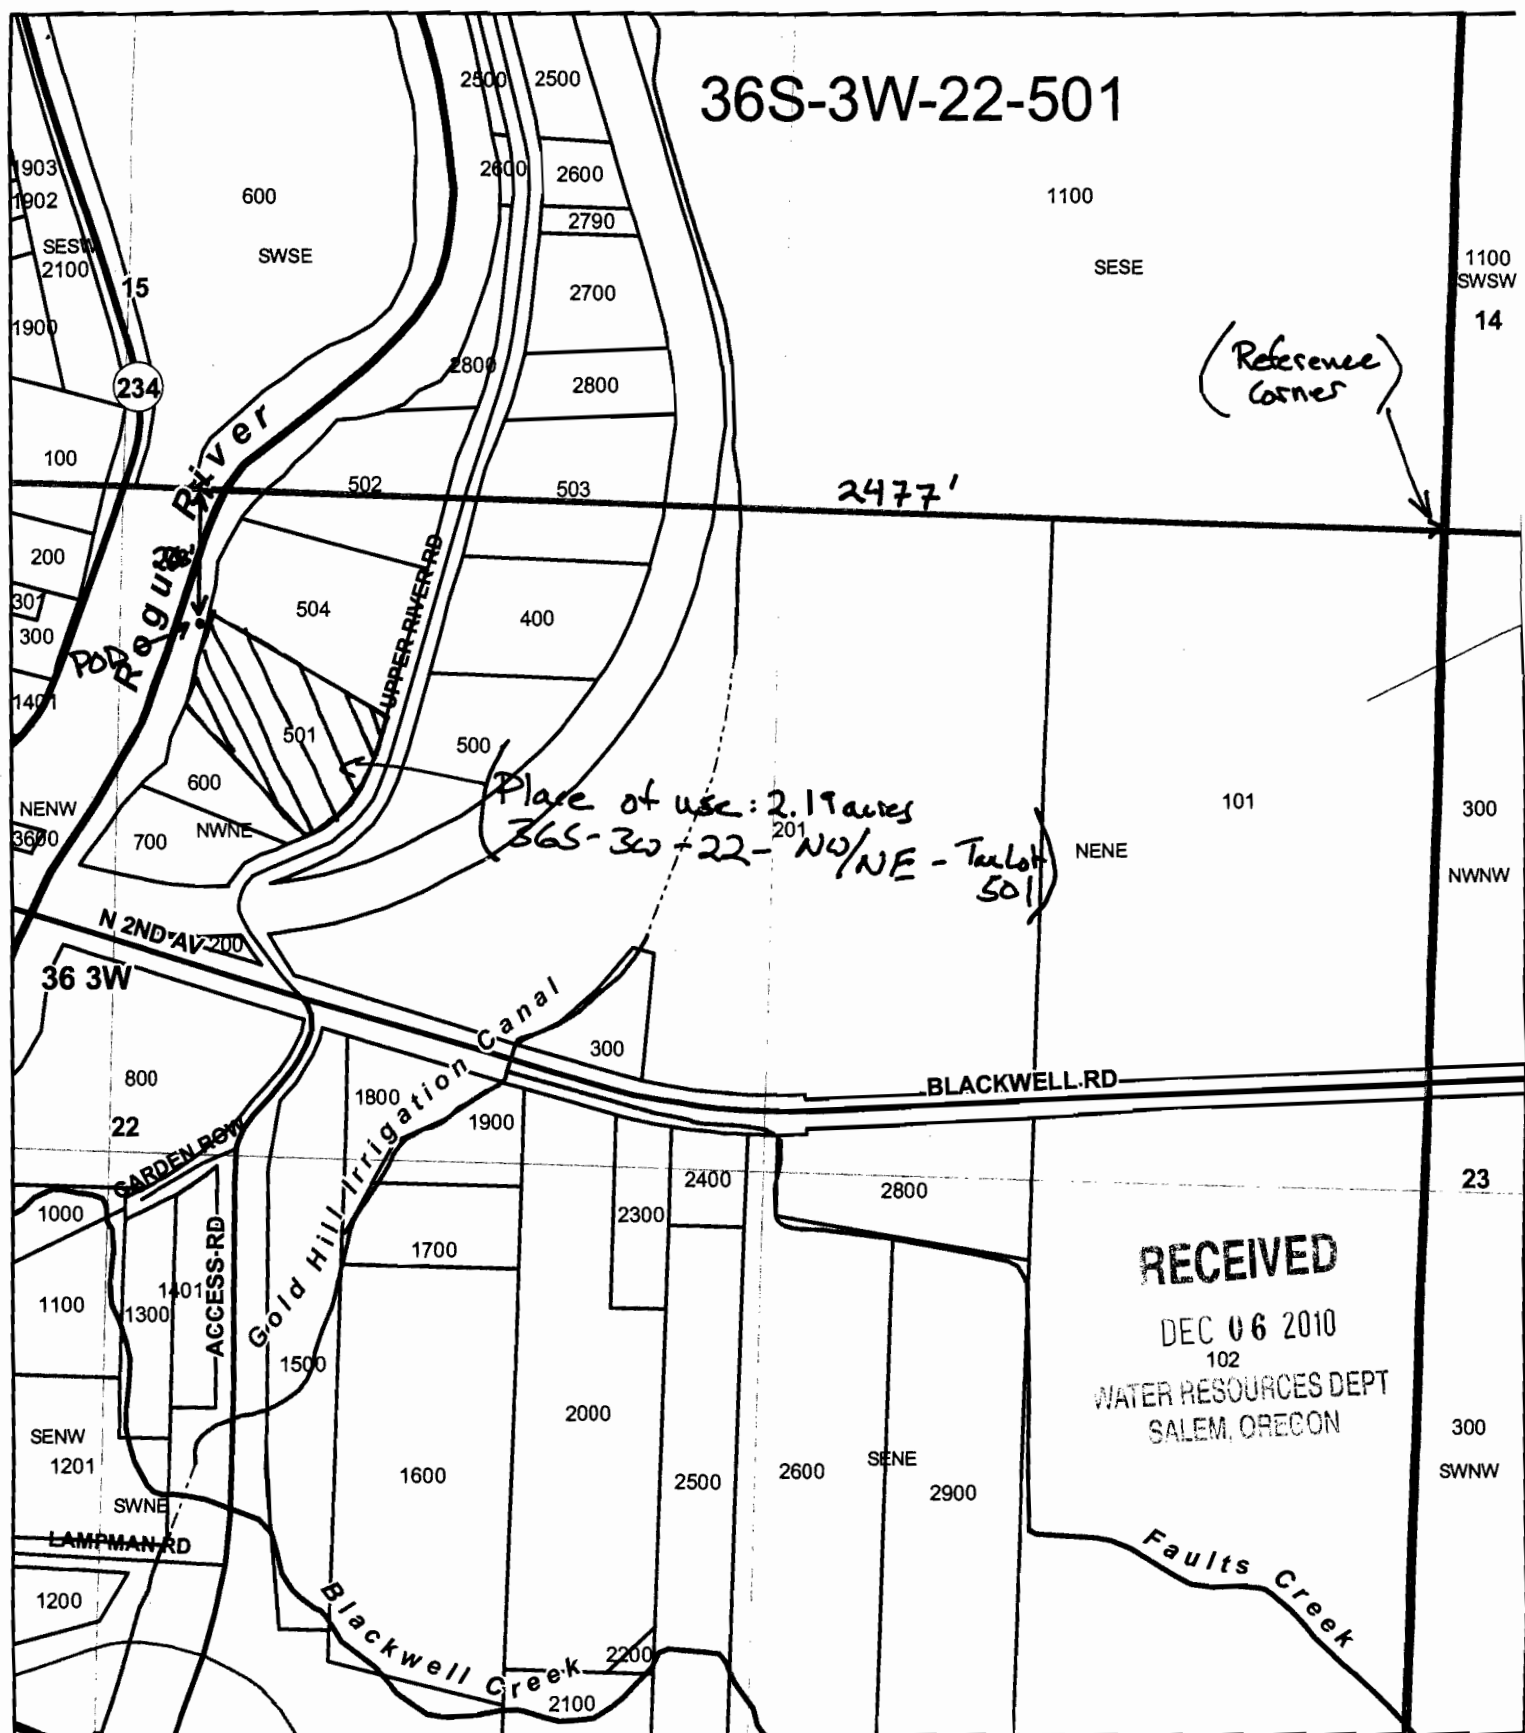





Place of use: 2.19 acres  
36S-3W-22-201 NW/NE - Taxlot 501

(Reference Corner)


**RECEIVED**  
DEC 06 2010  
102  
WATER RESOURCES DEPT  
SALEM, OREGON
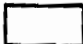
## Legend

-  Tax Lots
-  Sections
-  Townships
-  quarter quarters



1 inch = 384 feet

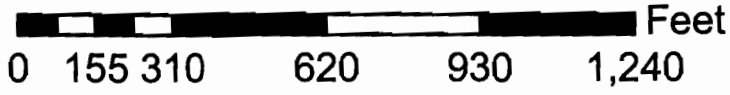

S-87670