


T38S, R3W, Sec. 32

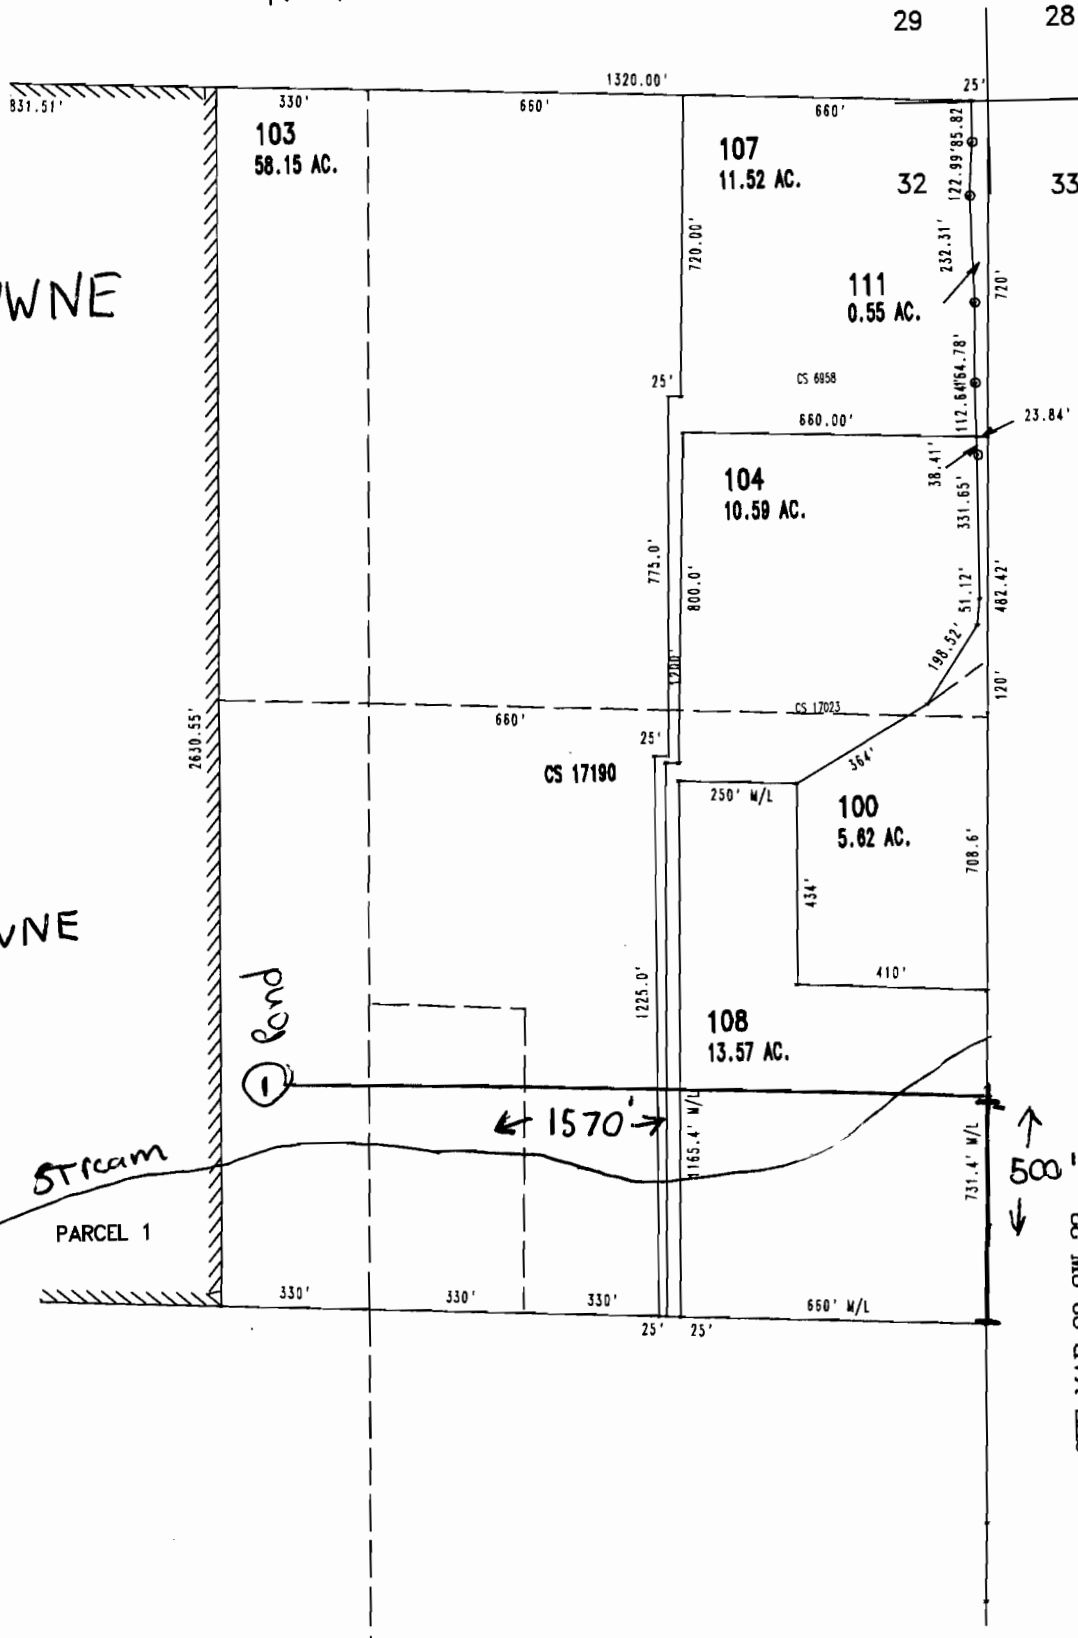

NWNE

SWNE



⊖ bend

RECEIVED

DEC 06 2010

SEE MAP 38 3W 33
WATER RESOURCES DEPT
SALEM, OREGON

R-8767H