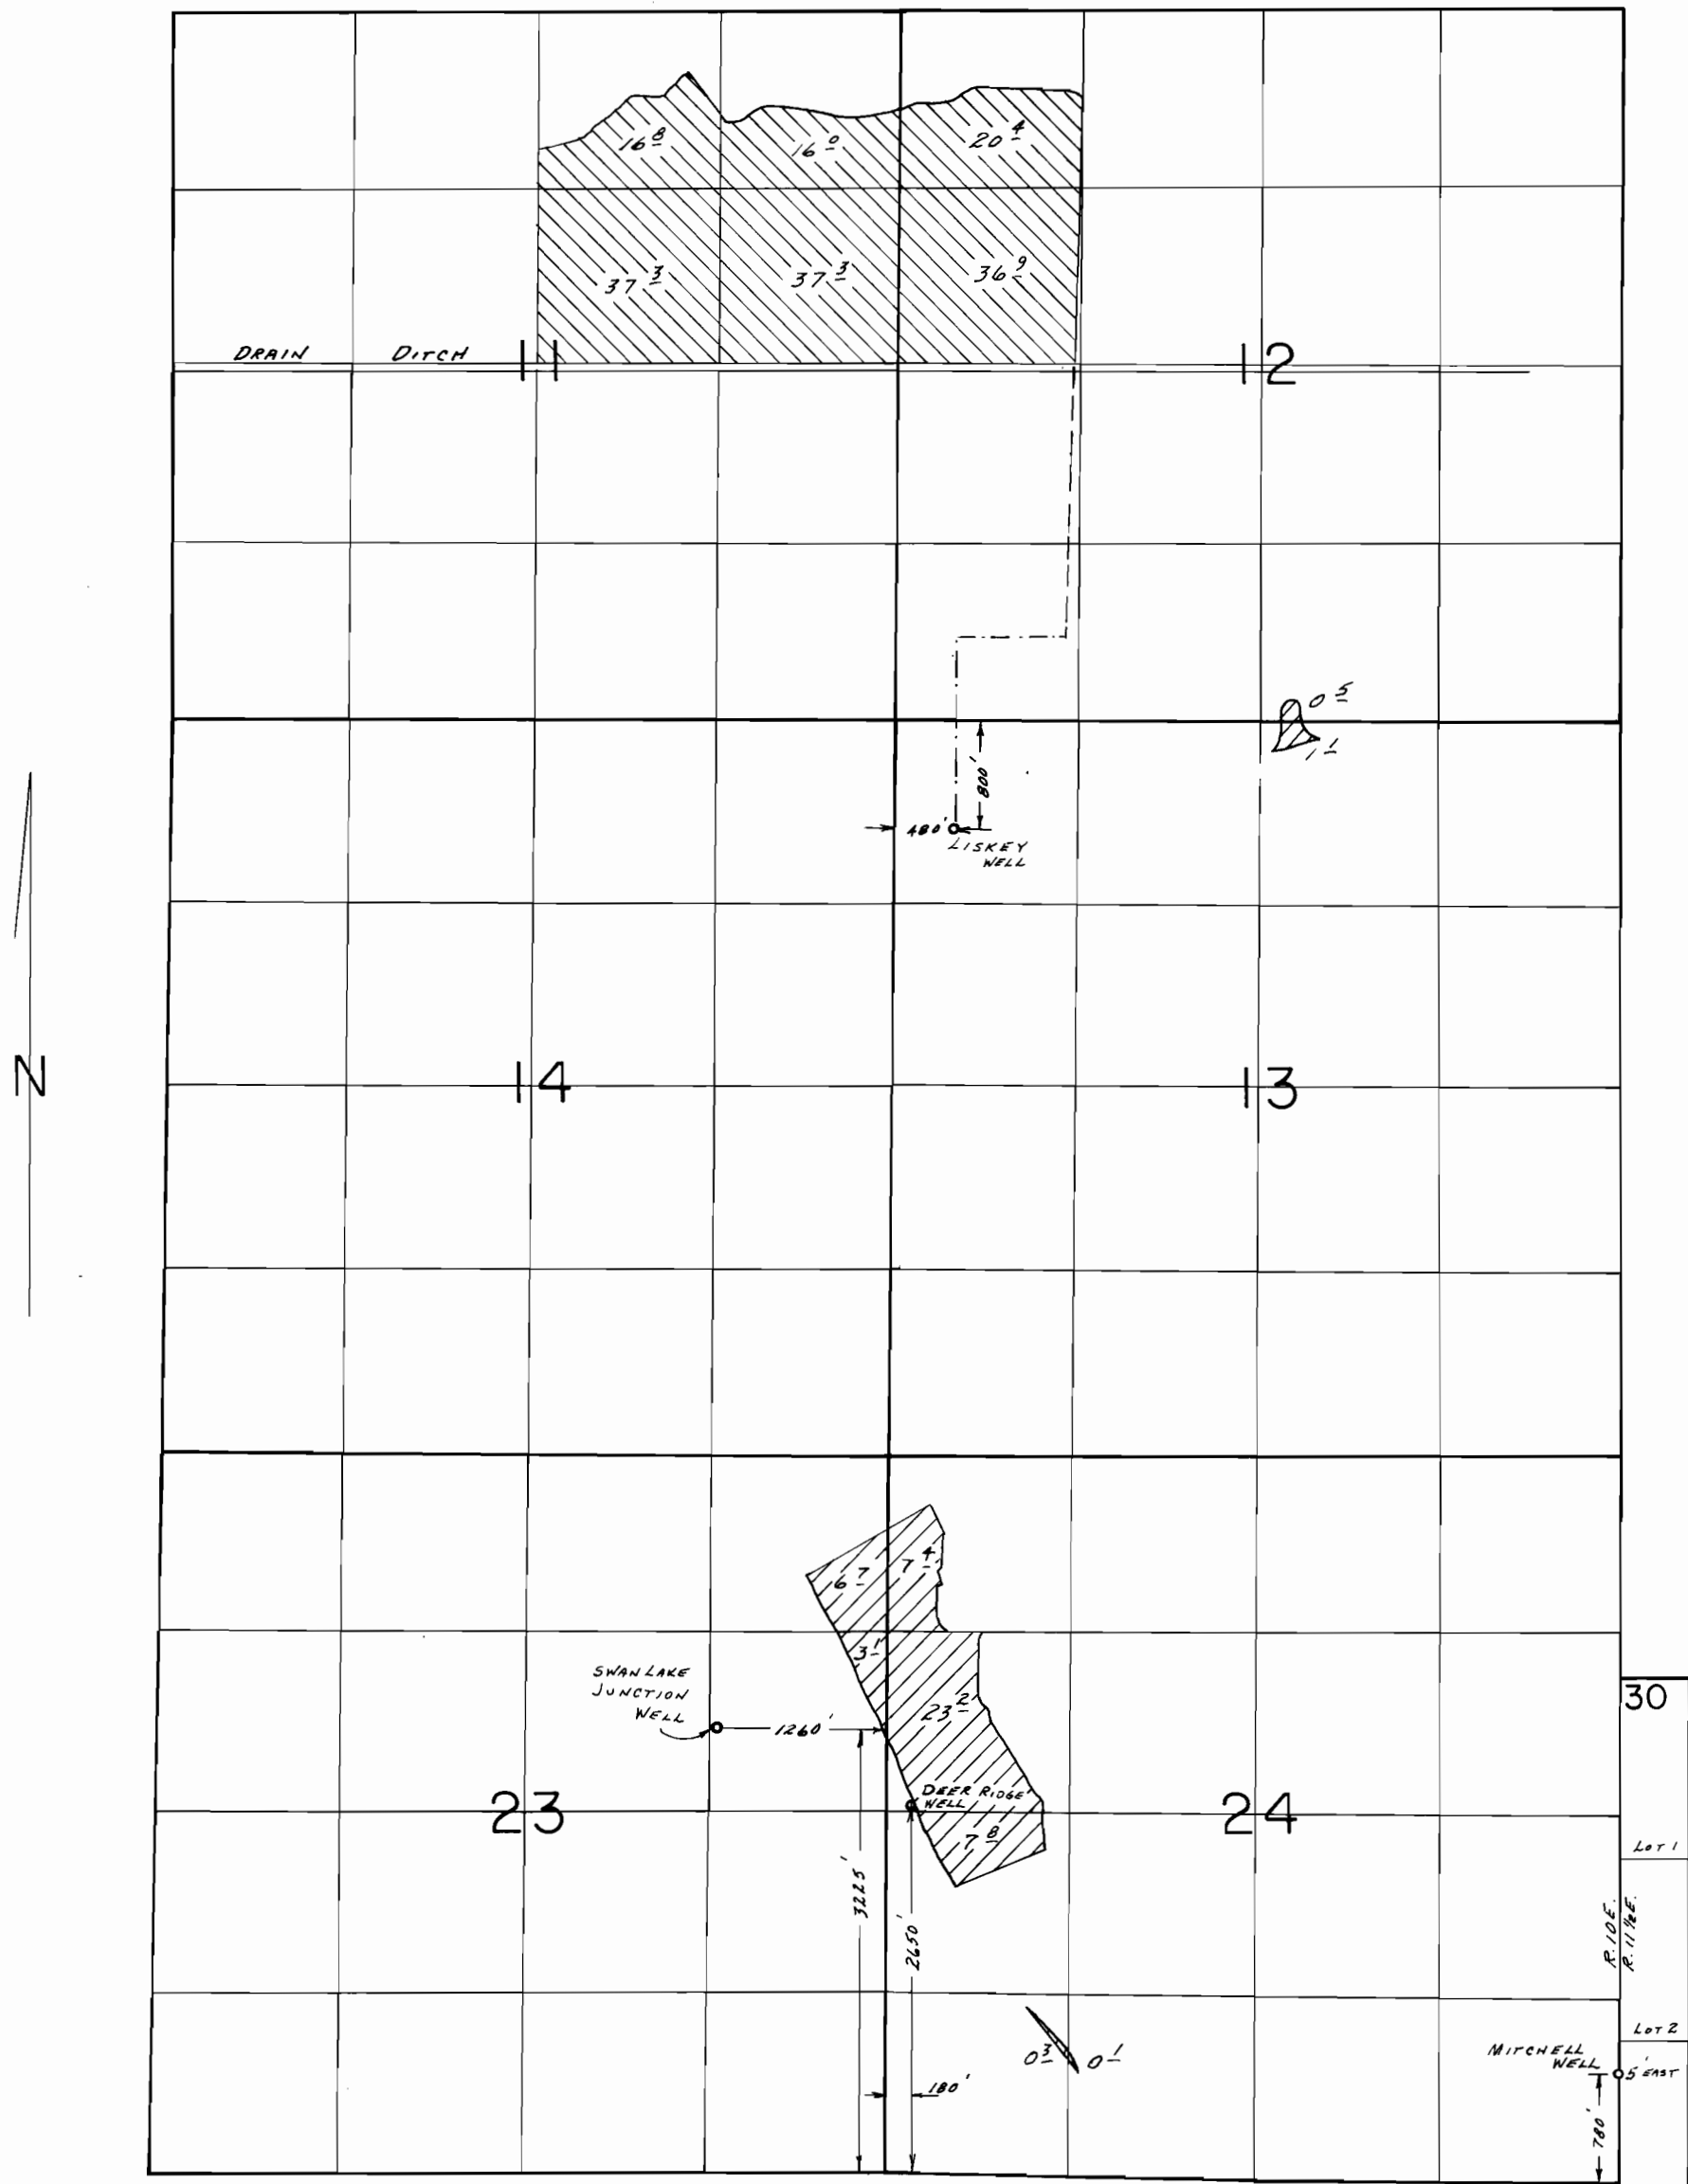

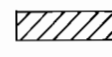
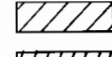



T.38S.,R.10&11/2E.,W.M.



-  Permit G-5191 (Liskey Well)
-  Permit G-10129 (Liskey Well)
-  " " (Deer Ridge Well)
-  " " (Mitchell Well)

30
Lot 1
RIDGE
R. 11/2 E.
Lot 2
MITCHELL
WELL
05' DIST
Lot 3
Lot 4
30

SCALE: 1" = 1320'

FINAL PROOF SURVEY
UNDER

Transfer No. 4843
G-5390 G-5191
Application No. G-10510 Permit No. G-10129.....
IN NAME OF

NEVIN CATTLE COMPANY

Surveyed Oct. 6, 1988, by B.W. BISHOP

C 119