


T.38S.,R.10&11E.,W.M.

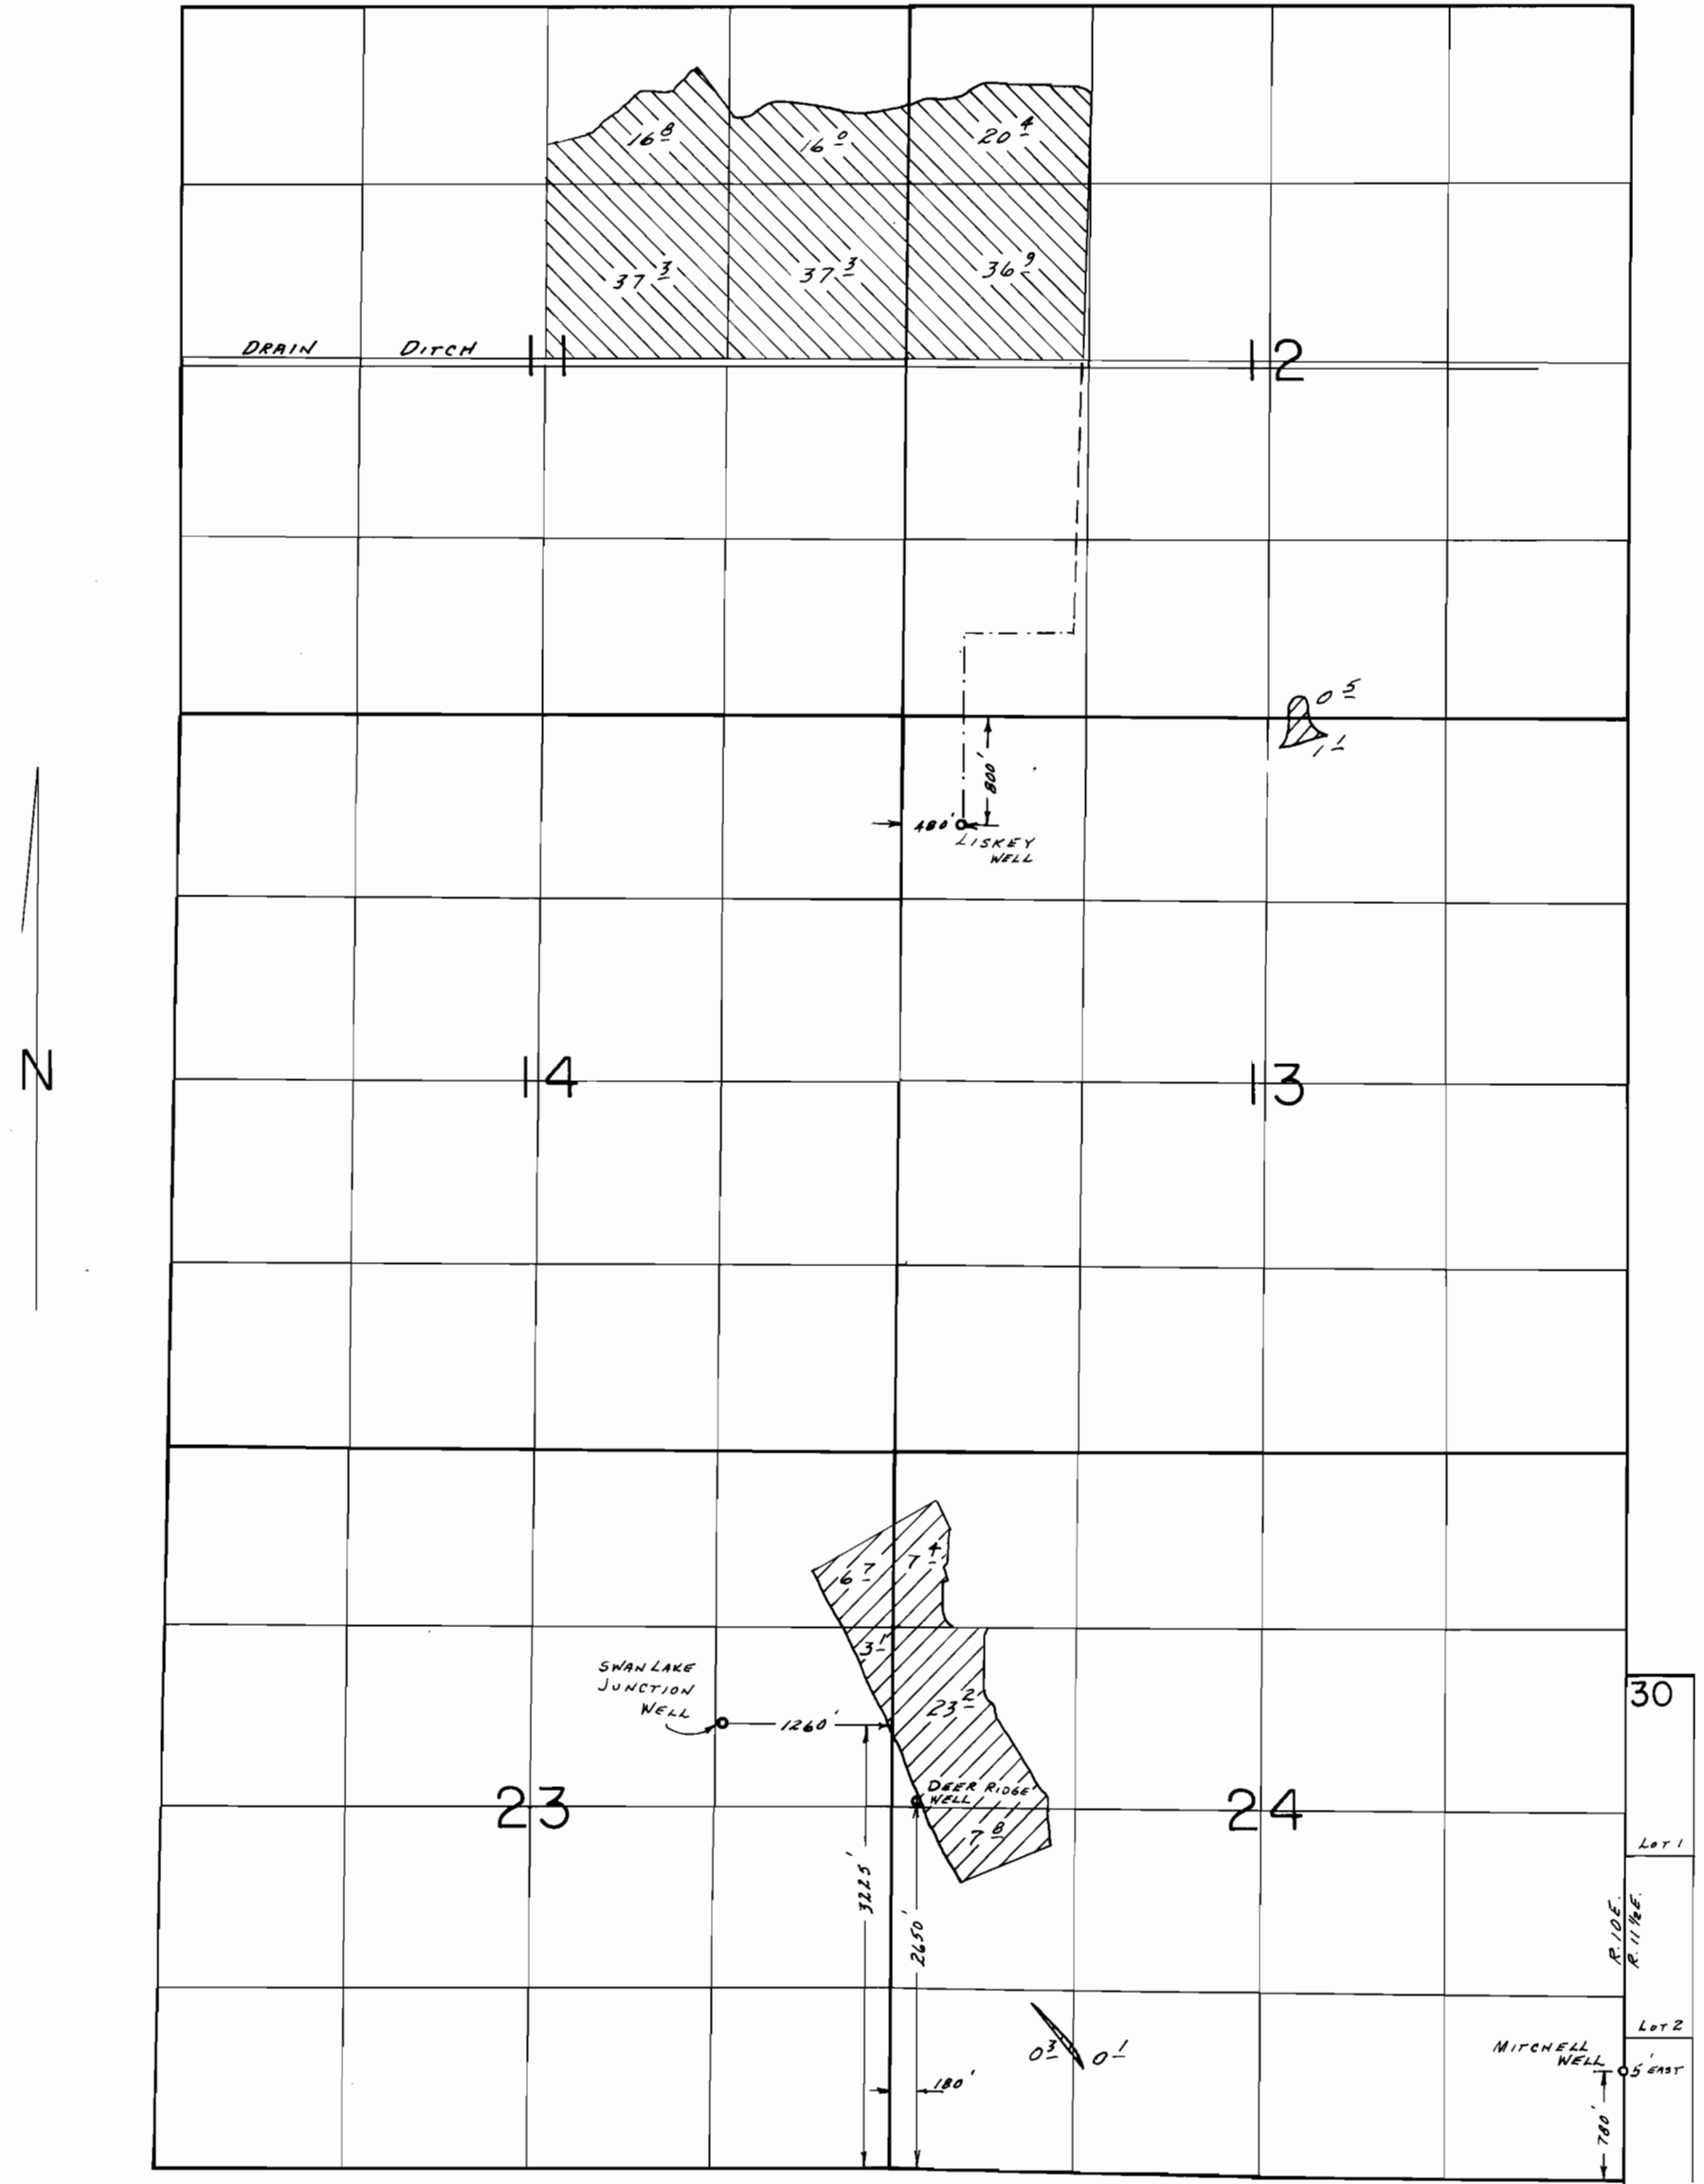

- Permit G-5191 (Liskey Well)
- Permit G-10129 (Liskey Well)
- " " (Deer Ridge Well)
- " " (Mitchell Well)

SCALE: 1" = 1320'

FINAL PROOF SURVEY
UNDER

Transfer No. 4843
G-5390 G-5191
Application No. G-10129 Permit No. G-10129.....
IN NAME OF

NEVIN CATTLE COMPANY

Surveyed Oct. 5, 1988, by B.W. BLSHOP

30
Lot 1
Lot 2
780'
Lot 3
Lot 4
30

C 119