Herb Mosgar

From: Dan Boyden [dboyden@gorge.net]
Sent: Monday, January 03, 2011 11:24 AM
To: Herb Mosgar
Subject: revised map & app
Attachments: ORWRD 002.JPG; ORWRD 001.JPG

RECEIVED
JAN 03 2011
WATER RESOURCES DEPT
SALEM, OREGON

Herb,
Here are the revisions you requested. Let me know if this is clear.
Thanks,
Dan

BMT, LLC
R87673

RECEIVED
JAN 03 2011
WATER RESOURCES DEPT
SALEM, OREGON

HYATT PRAIRIE ROAD

TAX LOT 900
N 1/2 of NE 1/4
SECTION 2
T39S R3E

WILLOW CREEK

POND

100'

160'

N 1/16 COR
SECS 1 & 2

1

2

1" = 100'

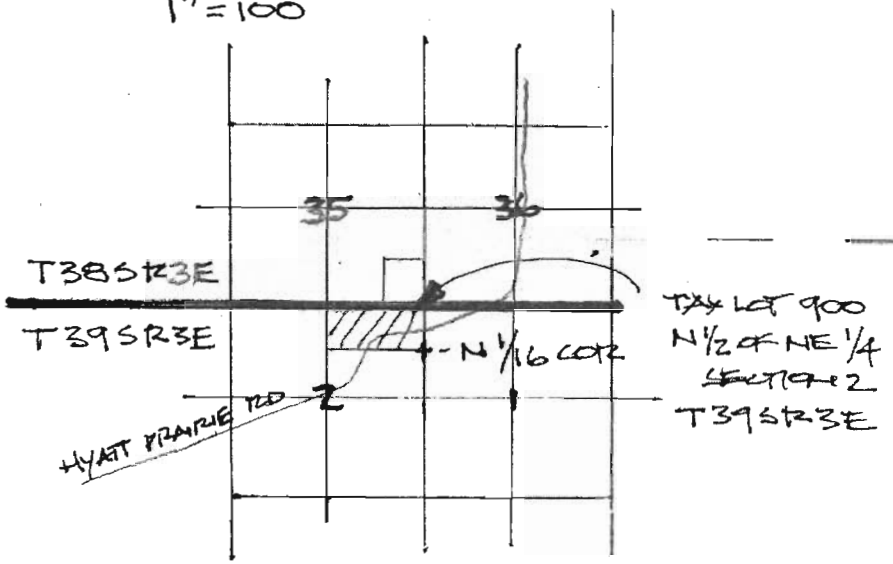

RECEIVED
JAN 03 2010
WATER RESOURCES DEPT
SALEM, OREGON

BMT, LLC
R87673

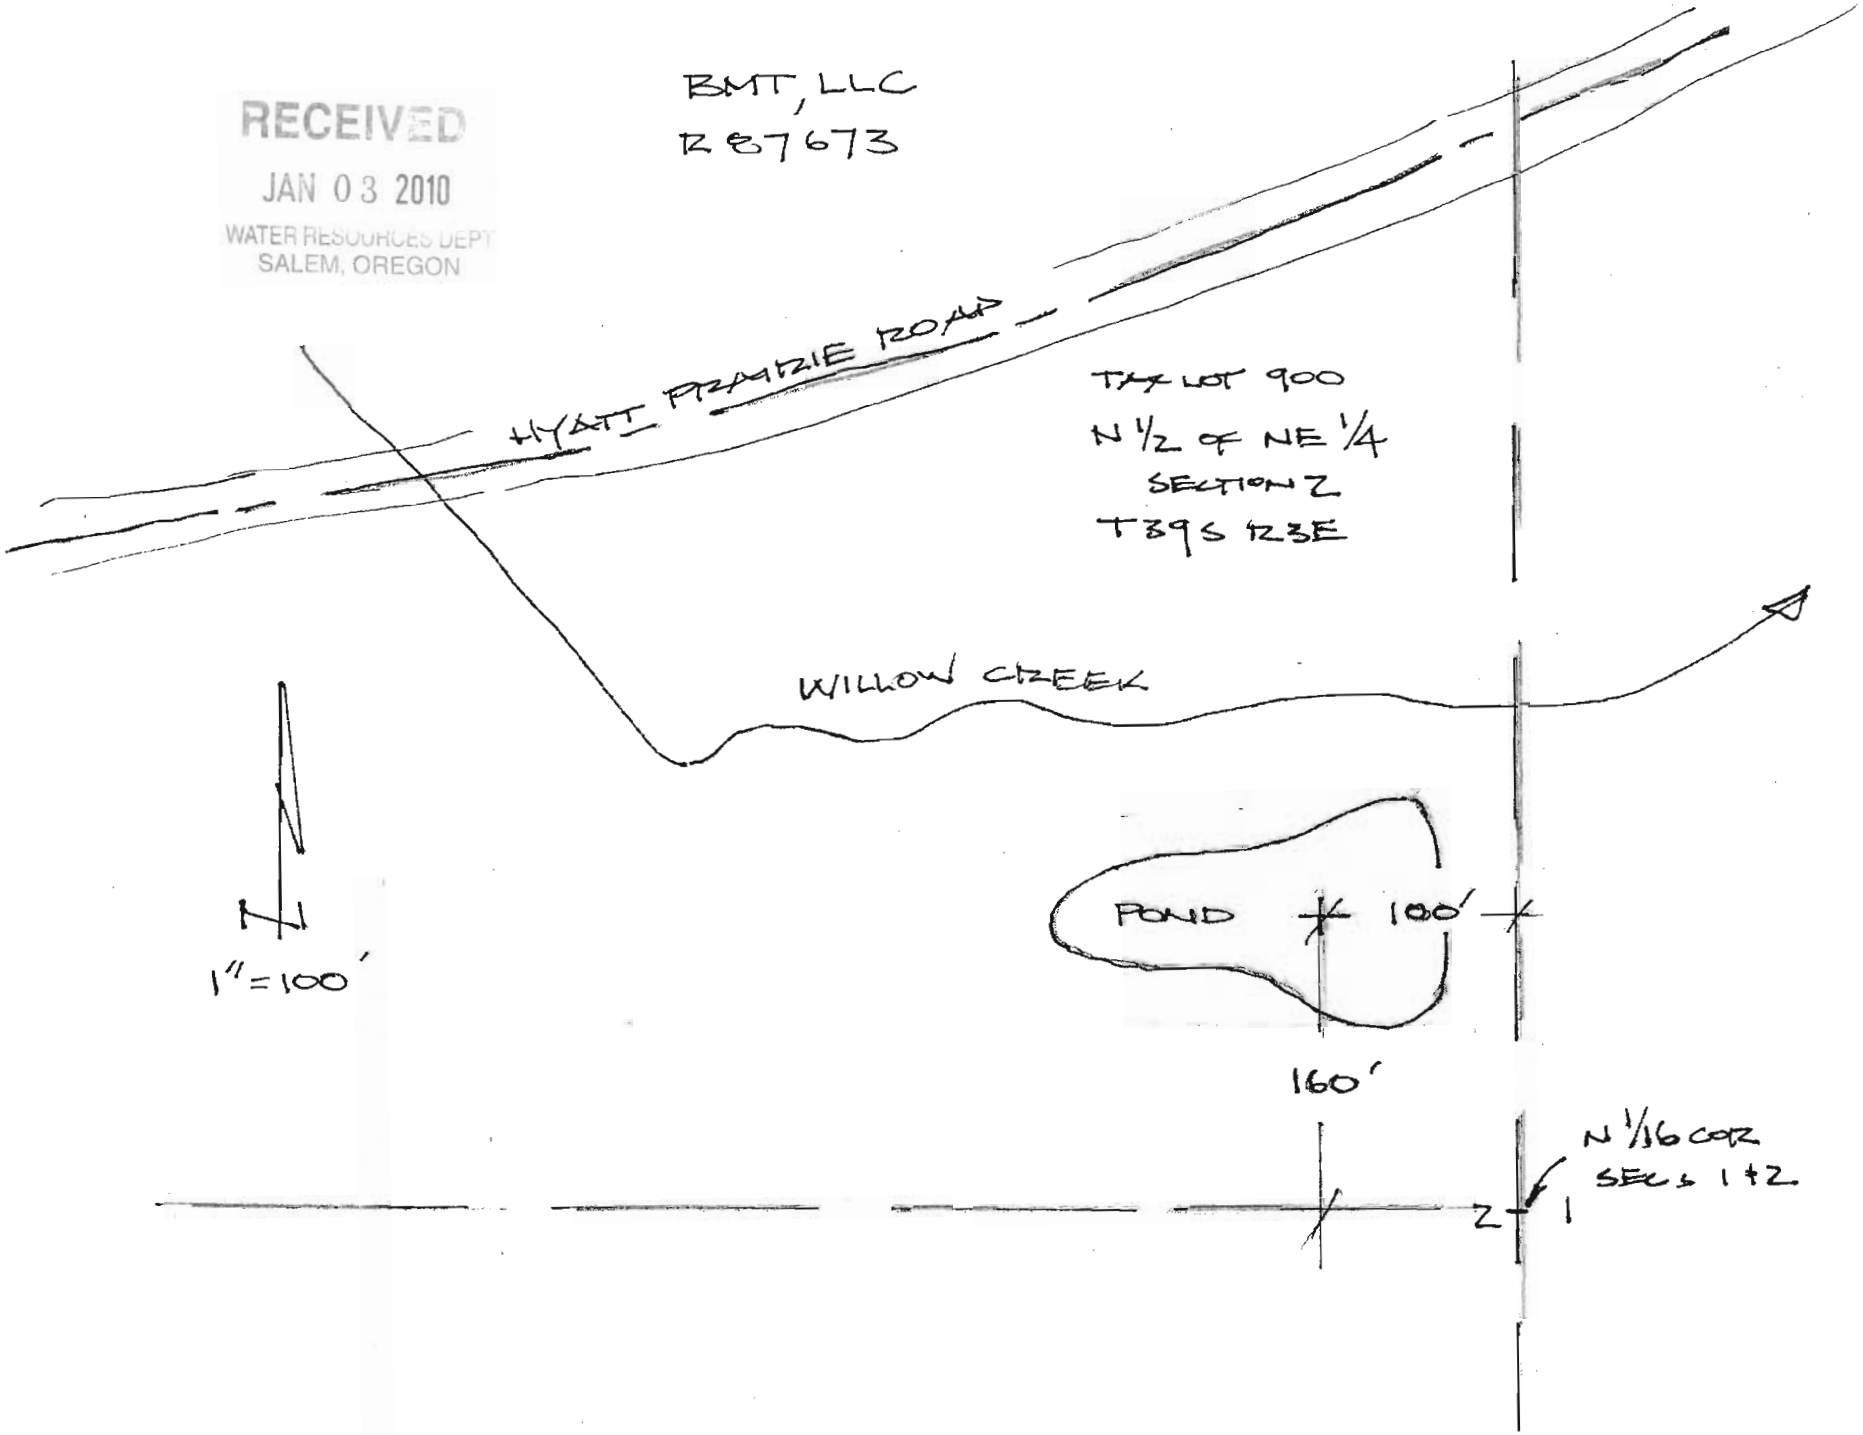

Herb Mosgar

From: Dan Boyden [dboyden@gorge.net]
Sent: Saturday, January 01, 2011 10:35 PM
To: Herb Mosgar
Subject: R87673
Attachments: R87673 001.JPG

Herb,
Here is the revised map for R87673. Let me know if this is clear.
Thanks,
Dan Boyden
BMT, LLC

RECEIVED
JAN 03 2010
WATER RESOURCES DEPT
SALEM, OREGON

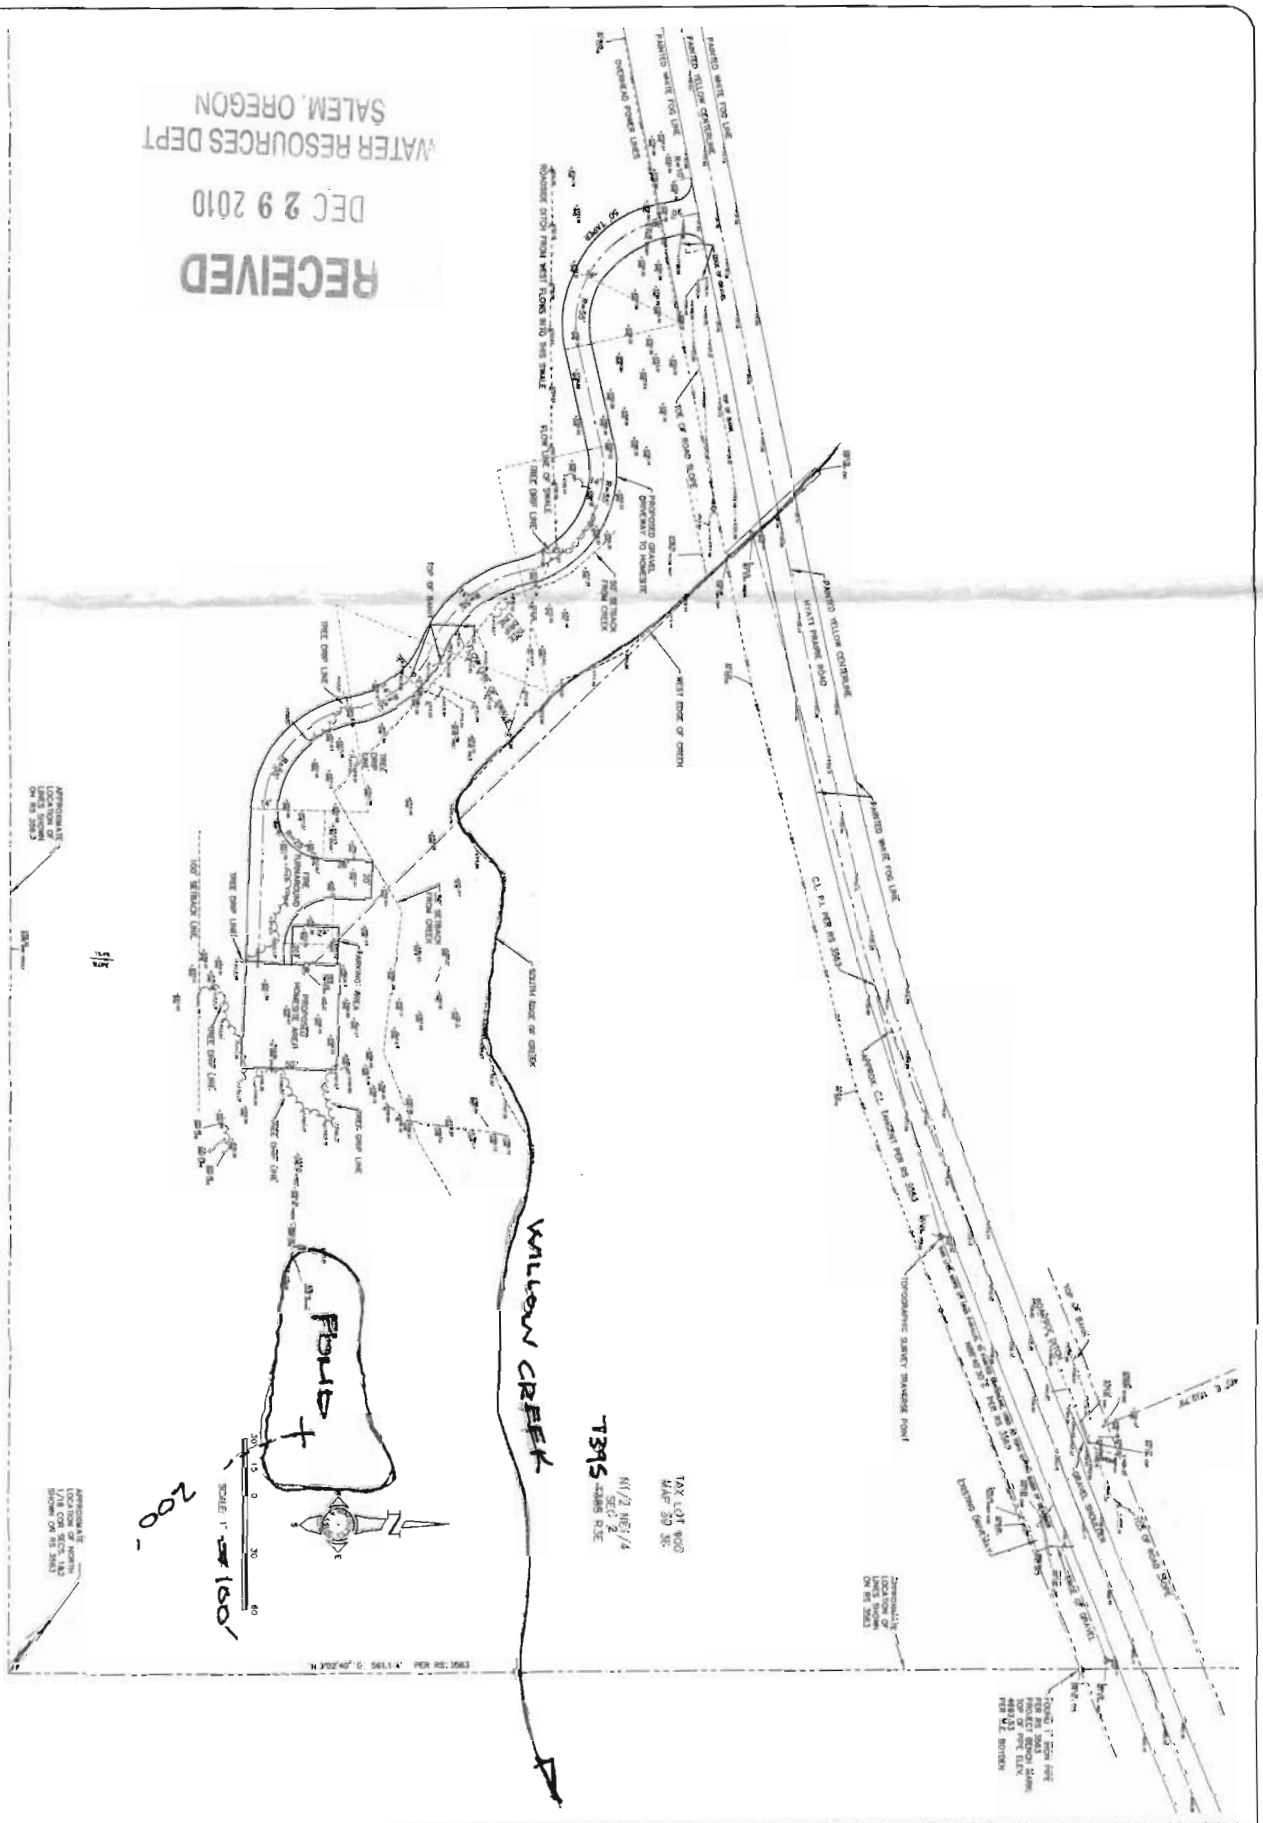

RECEIVED
DEC 29 2010
WATER RESOURCES DEPT
SALEM, OREGON

file document, and the ideas and designs incorporated herein, as an instrument of service, are the property of Marquess & Associates, Inc. and is not to be used in whole or in part for any other project without the written authorization of Marquess & Associates, Inc.

TOPOGRAPHIC SURVEY

BOYDEN PROPERTY

TAX LOT 900 MAP 39 3E

HYATT PRAIRIE ROAD

JACKSON COUNTY OREGON

MARQUESS & ASSOCIATES

YOUR PROFESSIONAL ENGINEERING TEAM SINCE 1957

STRUCTURAL | MECHANICAL | ELECTRICAL

CIVIL | GEOTECHNICAL | SURVEY | CONSTRUCTION TESTING

PRELIMINARY

6-29-07

1 SHEET