

SECTION PLAT

Section 4

Township 24 S

Range 32.5 E. W.M.

County of HARNEY State of Or

NORTH



SCALE 1" = 660'

G-17447

Section 5 Township 24 S. Range 32.5 E.W.M.
County of HARNEY State of OR



G-17447

SECTION PLAT


Section 8 & 9

Township 24 S.

Range 32.5 E.W.M

County of HARNEY

State of OR

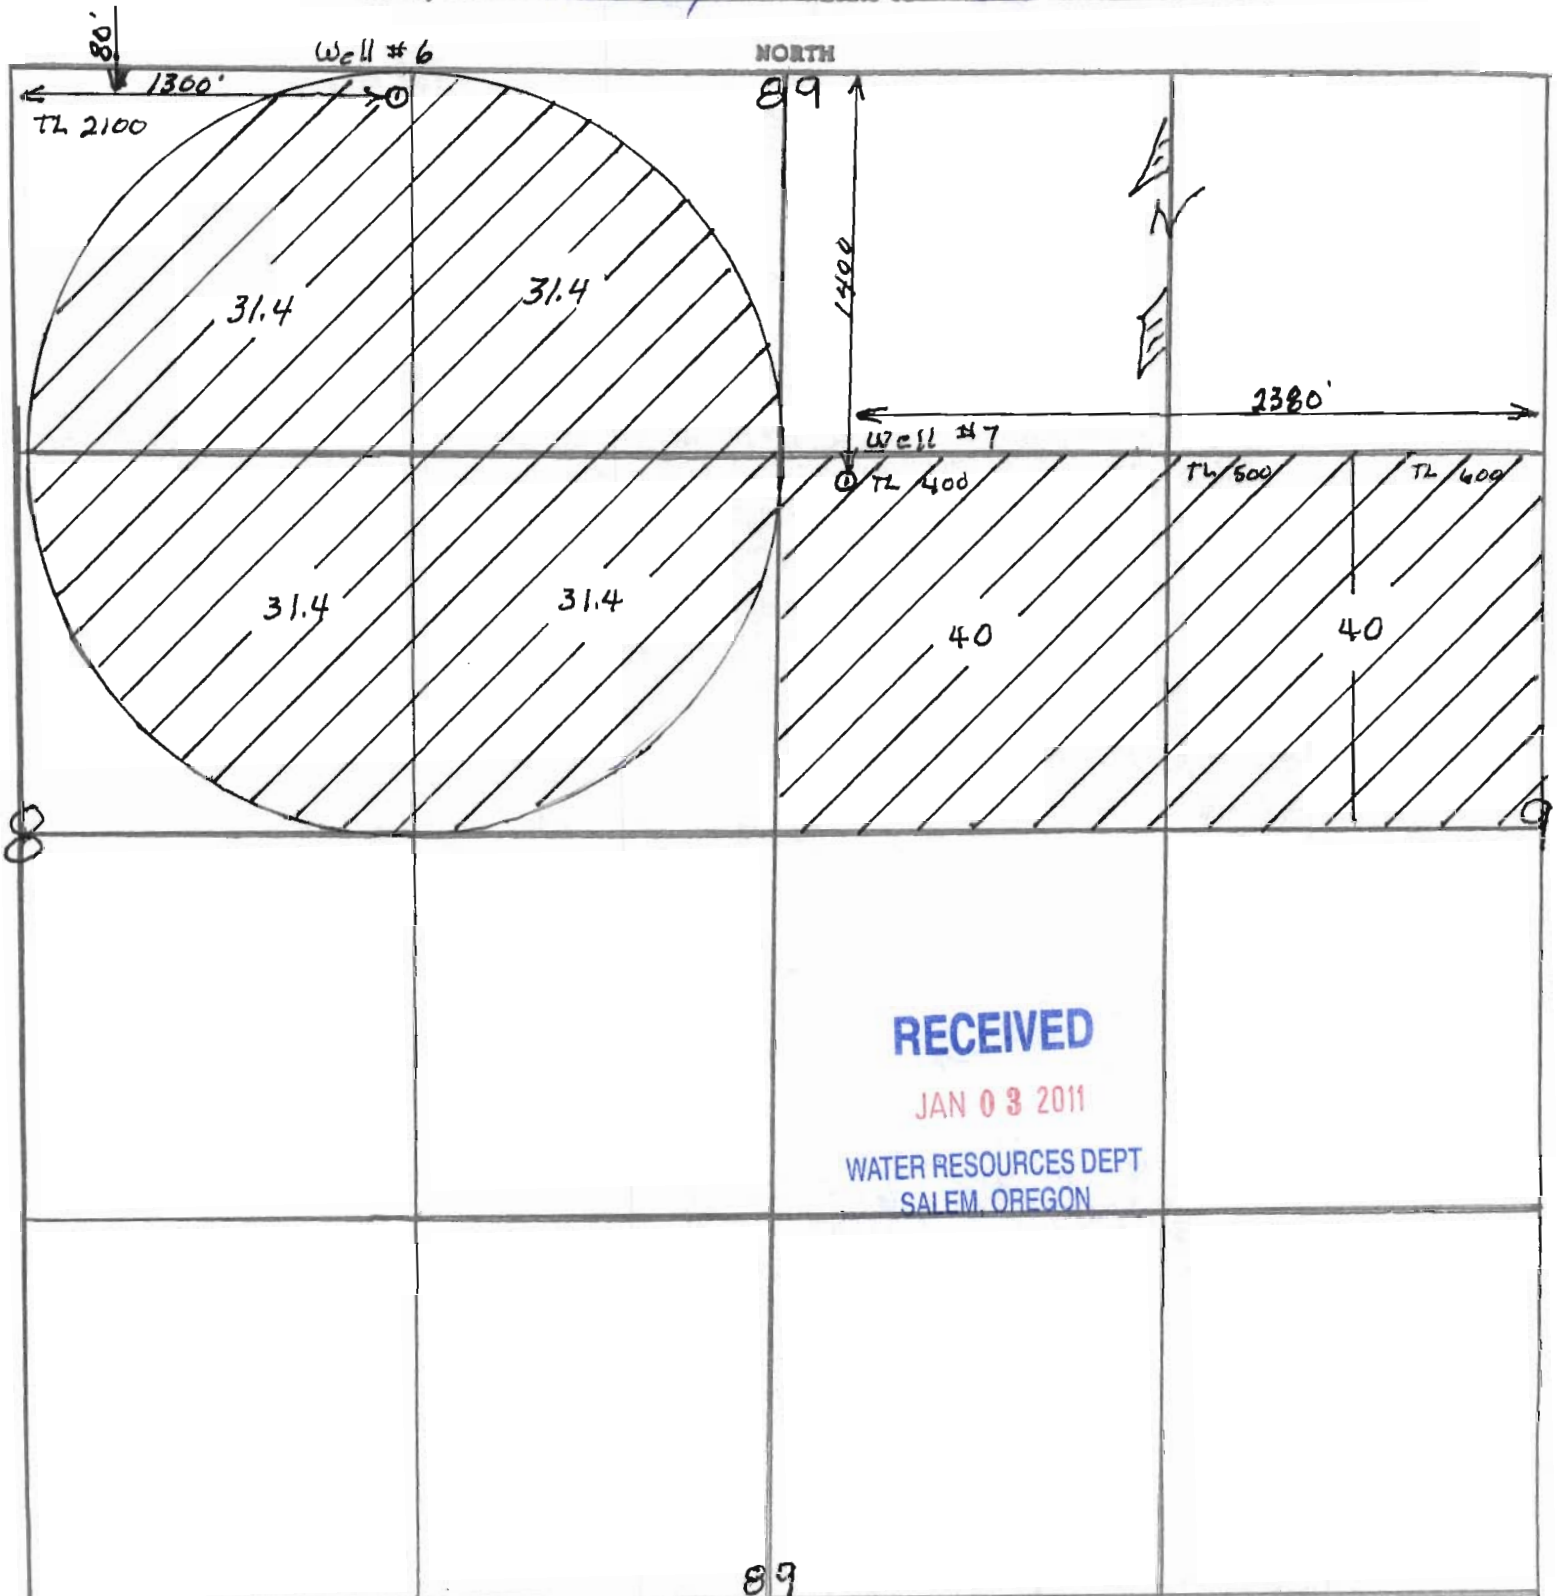

RECEIVED

JAN 03 2011

WATER RESOURCES DEPT
SALEM, OREGON

scale = 1" = 660'

G-17447

SECTION PLAT

Section 33

Township 23 S.

Range 32 S E.W.M.

County of HARNEY State of OR.

NORTH



33

TL 5400

40

1235'

40

82.5'

Well #1


RECEIVED

JAN 03 2011

WATER RESOURCES DEPT
SALEM, OREGON

SCALE 1" = 660'


G-17447

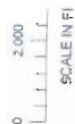

SECTION PLAT

Section 33 Township 23-S Range 32-S E.W.M.
County of HARNEY State of OR

NORTH

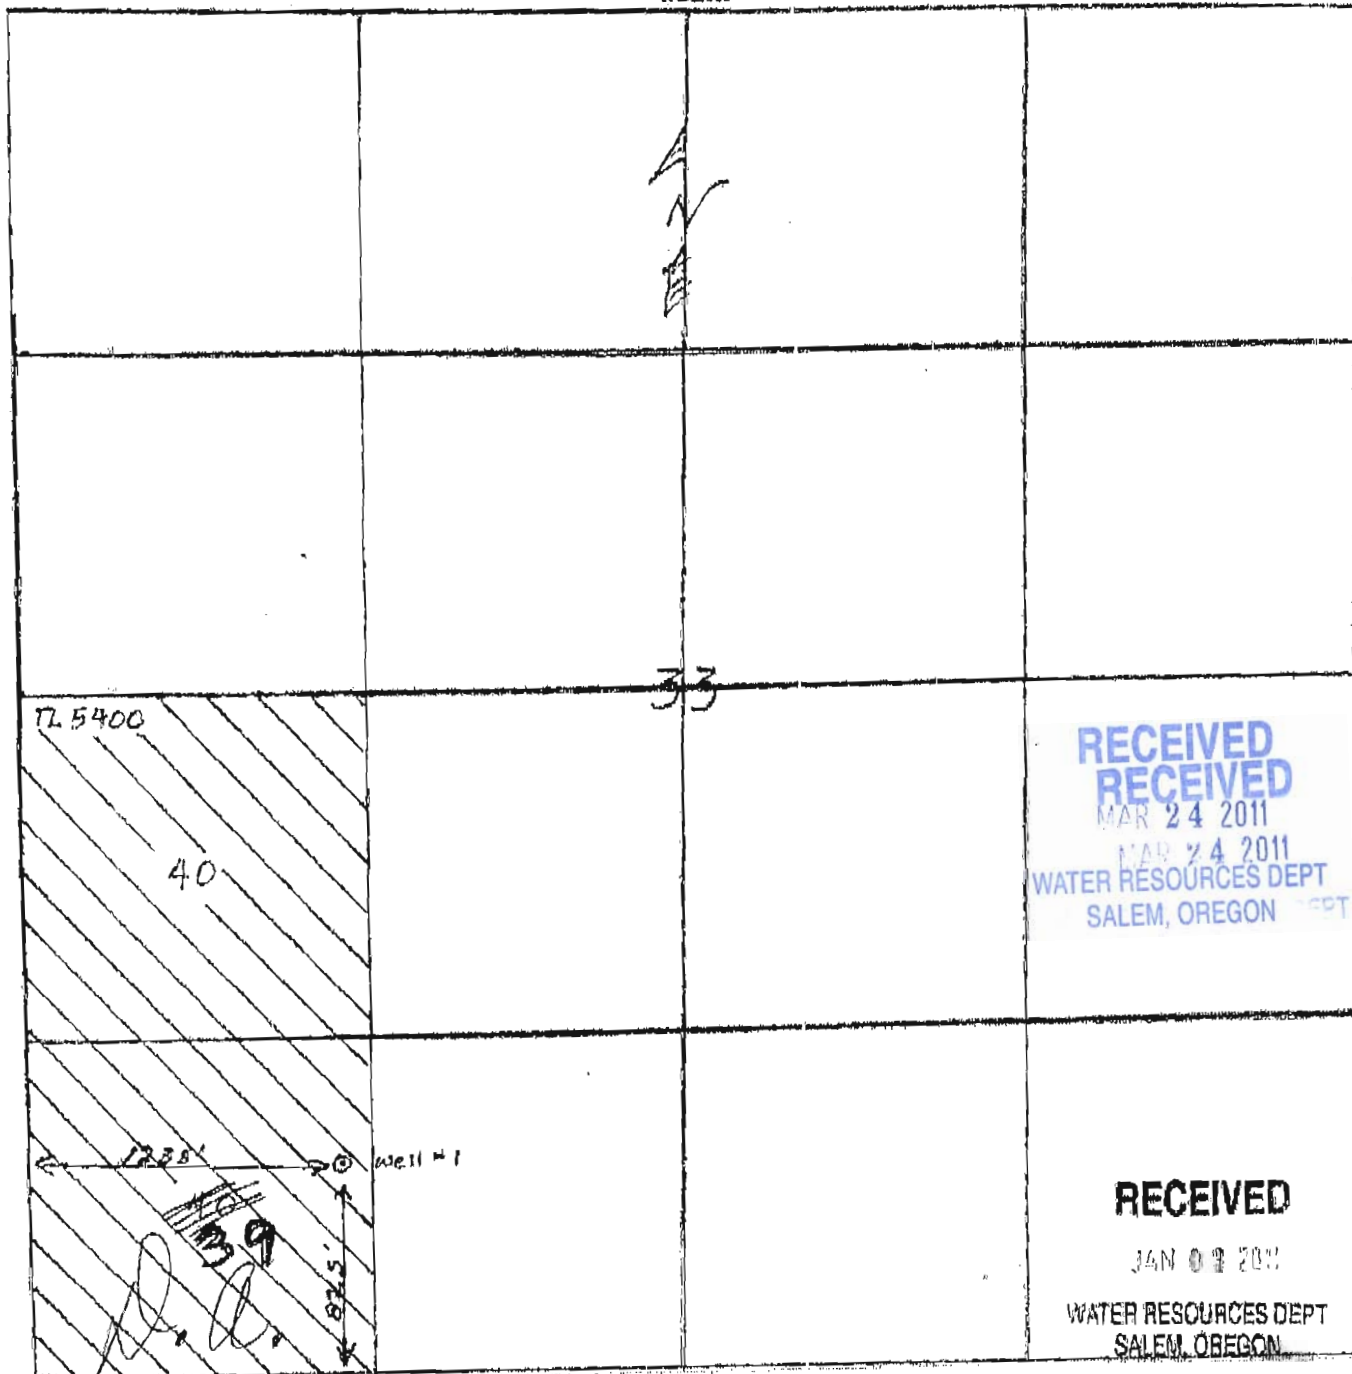

SCALE 1" = 660'

G-17447