



0563

CLAIM OF BENEFICIAL USE AND FINAL PROOF MAP

FOR
GARY RENNE
T41S, R 12E, Sec. 6 & 7, W.M.
& T41S, R11E, Sec. 1, W.M.
KLAMATH COUNTY, OREGON
APPLICATION No. G-15327
PERMIT No. G-15424

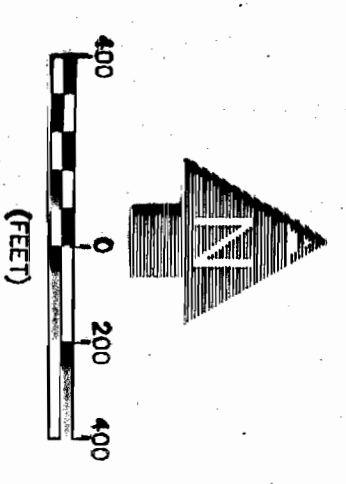

- NOTES:**
1. THIS MAP WAS PREPARED FROM FIELD MEASUREMENTS, MAP 2005 AERIAL PHOTOGRAPH, KLAMATH COUNTY TAX MAPS 411101, 4141206 & 411207 AND OREGON G.I.O. MAPS.
 2. THE PURPOSE OF THIS MAP IS TO IDENTIFY THE LOCATION OF THE WATER RIGHT ONLY, AND IS NOT INTENDED TO PROVIDE DIMENSIONS OR LOCATION OF PROPERTY LINES.
 3. FOR TAX LOT INFORMATION, SEE TAX MAPS INCLUDED WITH THIS APPLICATION.
 4. DATE OF PRIORITY FOR THIS APPLICATION IS FEBRUARY 21, 2001.

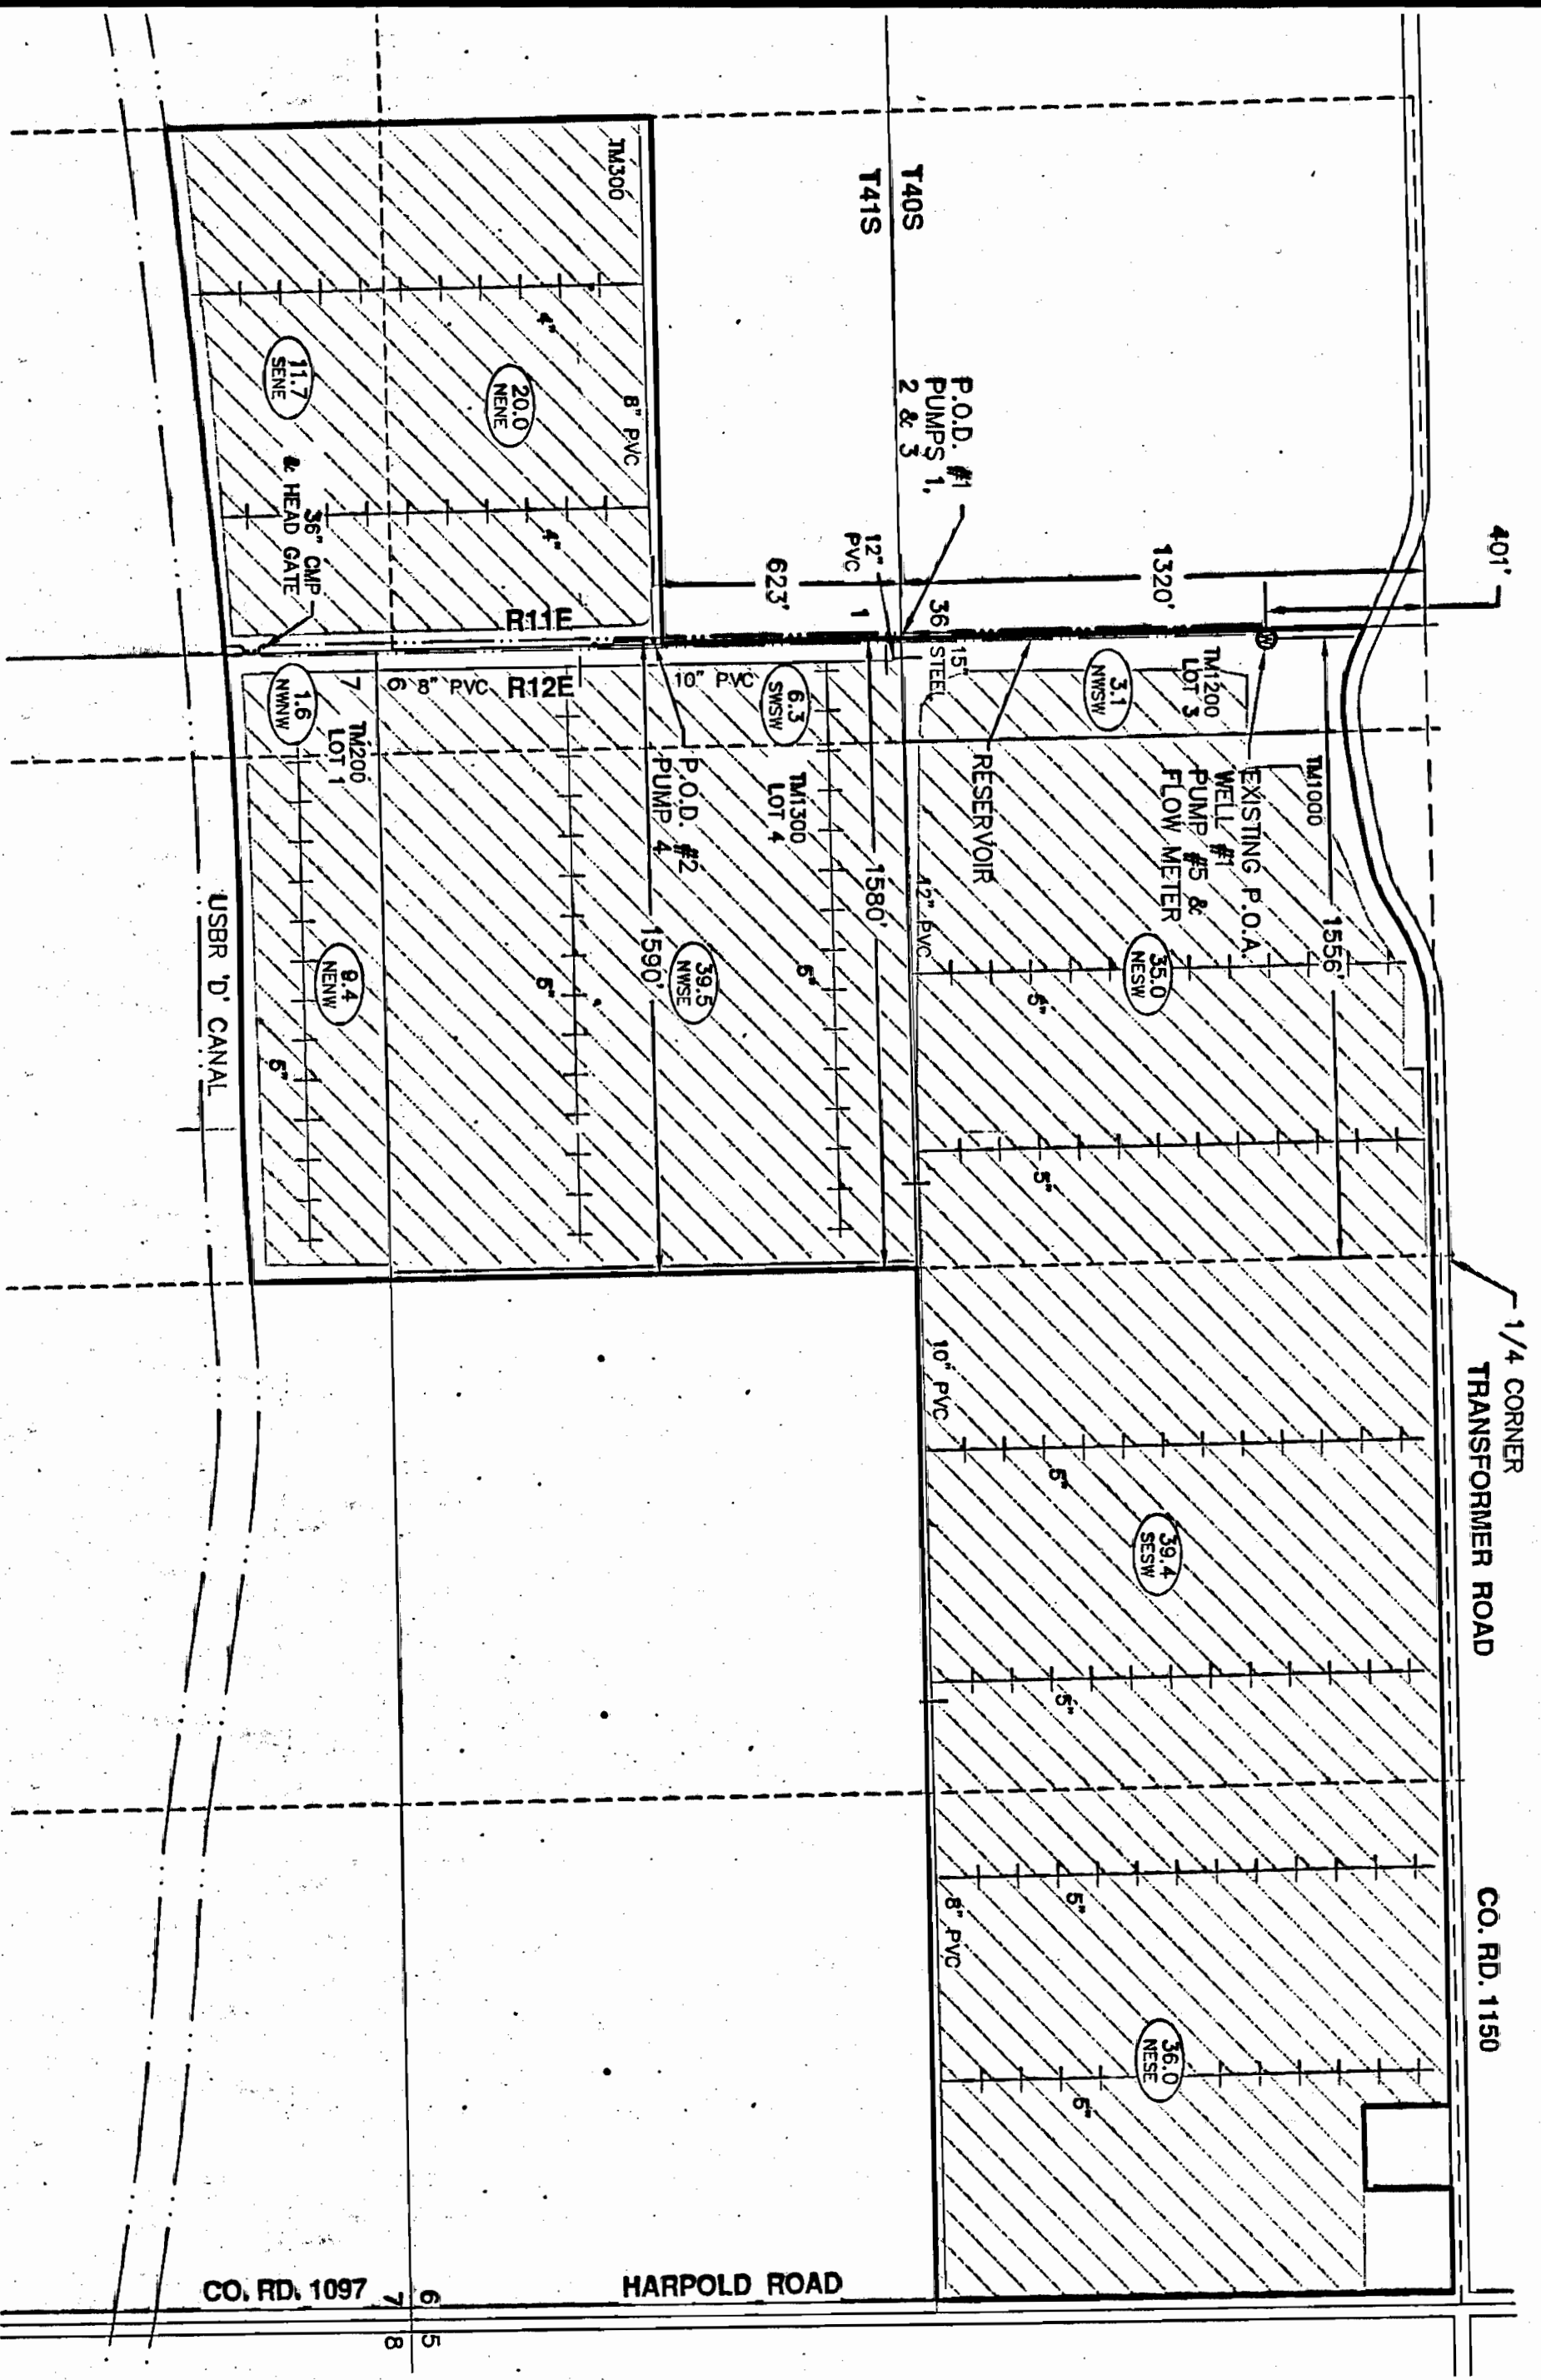

GOV'T LOT	1/4 1/4	SECTION	TOWNSHIP	RANGE	# IRRIGATED ACRES
	NE SE	6	41S	12E	36.0
	NW SE	6	41S	12E	39.4
	NE SW	6	41S	12E	35.0
3	NW SW	6	41S	12E	3.1
4	SW SW	6	41S	12E	6.3
4	SE SW	6	41S	12E	39.5
1	NE NW	7	41S	12E	9.4
1	NW NW	7	41S	12E	1.6
1	NE NE	1	41S	11E	20.0
	SE NE	1	41S	11E	11.7

TOTAL ACRES IRRIGATED: 202.0


LEGEND

- SECTION LINES
- 1/4 1/4 LINES
- ROADS
- PROPERTY BOUNDARY
- RESERVOIR (BULGE IN SYSTEM)
- 7 SECTION DESIGNATION
- TM TAX MAP NUMBER
- LOT 4 GOVERNMENT LOT NUMBER
- EXISTING P.O.A. (WELL)
- WHEEL LINE & PIPE SIZE
- 10" PVC MAIN LINE SIZE (BURIED)
- APPROXIMATE LIMITS USBR BOUNDARY

TOTAL ACRES IRRIGATED PER 1/4 1/4 IRRIGATED LANDS THIS CLAIM OF BENEFICIAL USE 1/4 1/4 SECTION

11.7
30.0
36.0
39.4
39.5
35.0
3.1
6.3
9.4
1.6
20.0
11.7

Gary Renne
Applicant signature

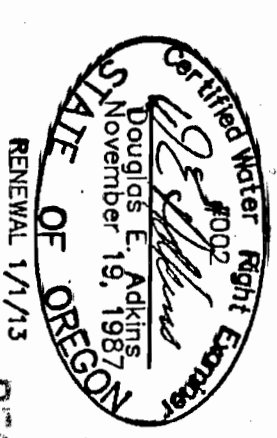

ADKINS
SINCE 1983

CONSULTING ENGINEERS, INC.
2950 Shoista Way · Klamath Falls, Oregon 97603 · (541) 884-4666 · FAX (541) 884-5335
Klamath Falls, OR · Madford, OR · Alturas, CA
RENNE-BASE.DWG
RECEIVED
JAN 19 2011
SALEM, OREGON

COBU MAP # 0563

0563