


Chris Ray - Water Right Application Map

Township 14 South, Range 39 East, W.M.

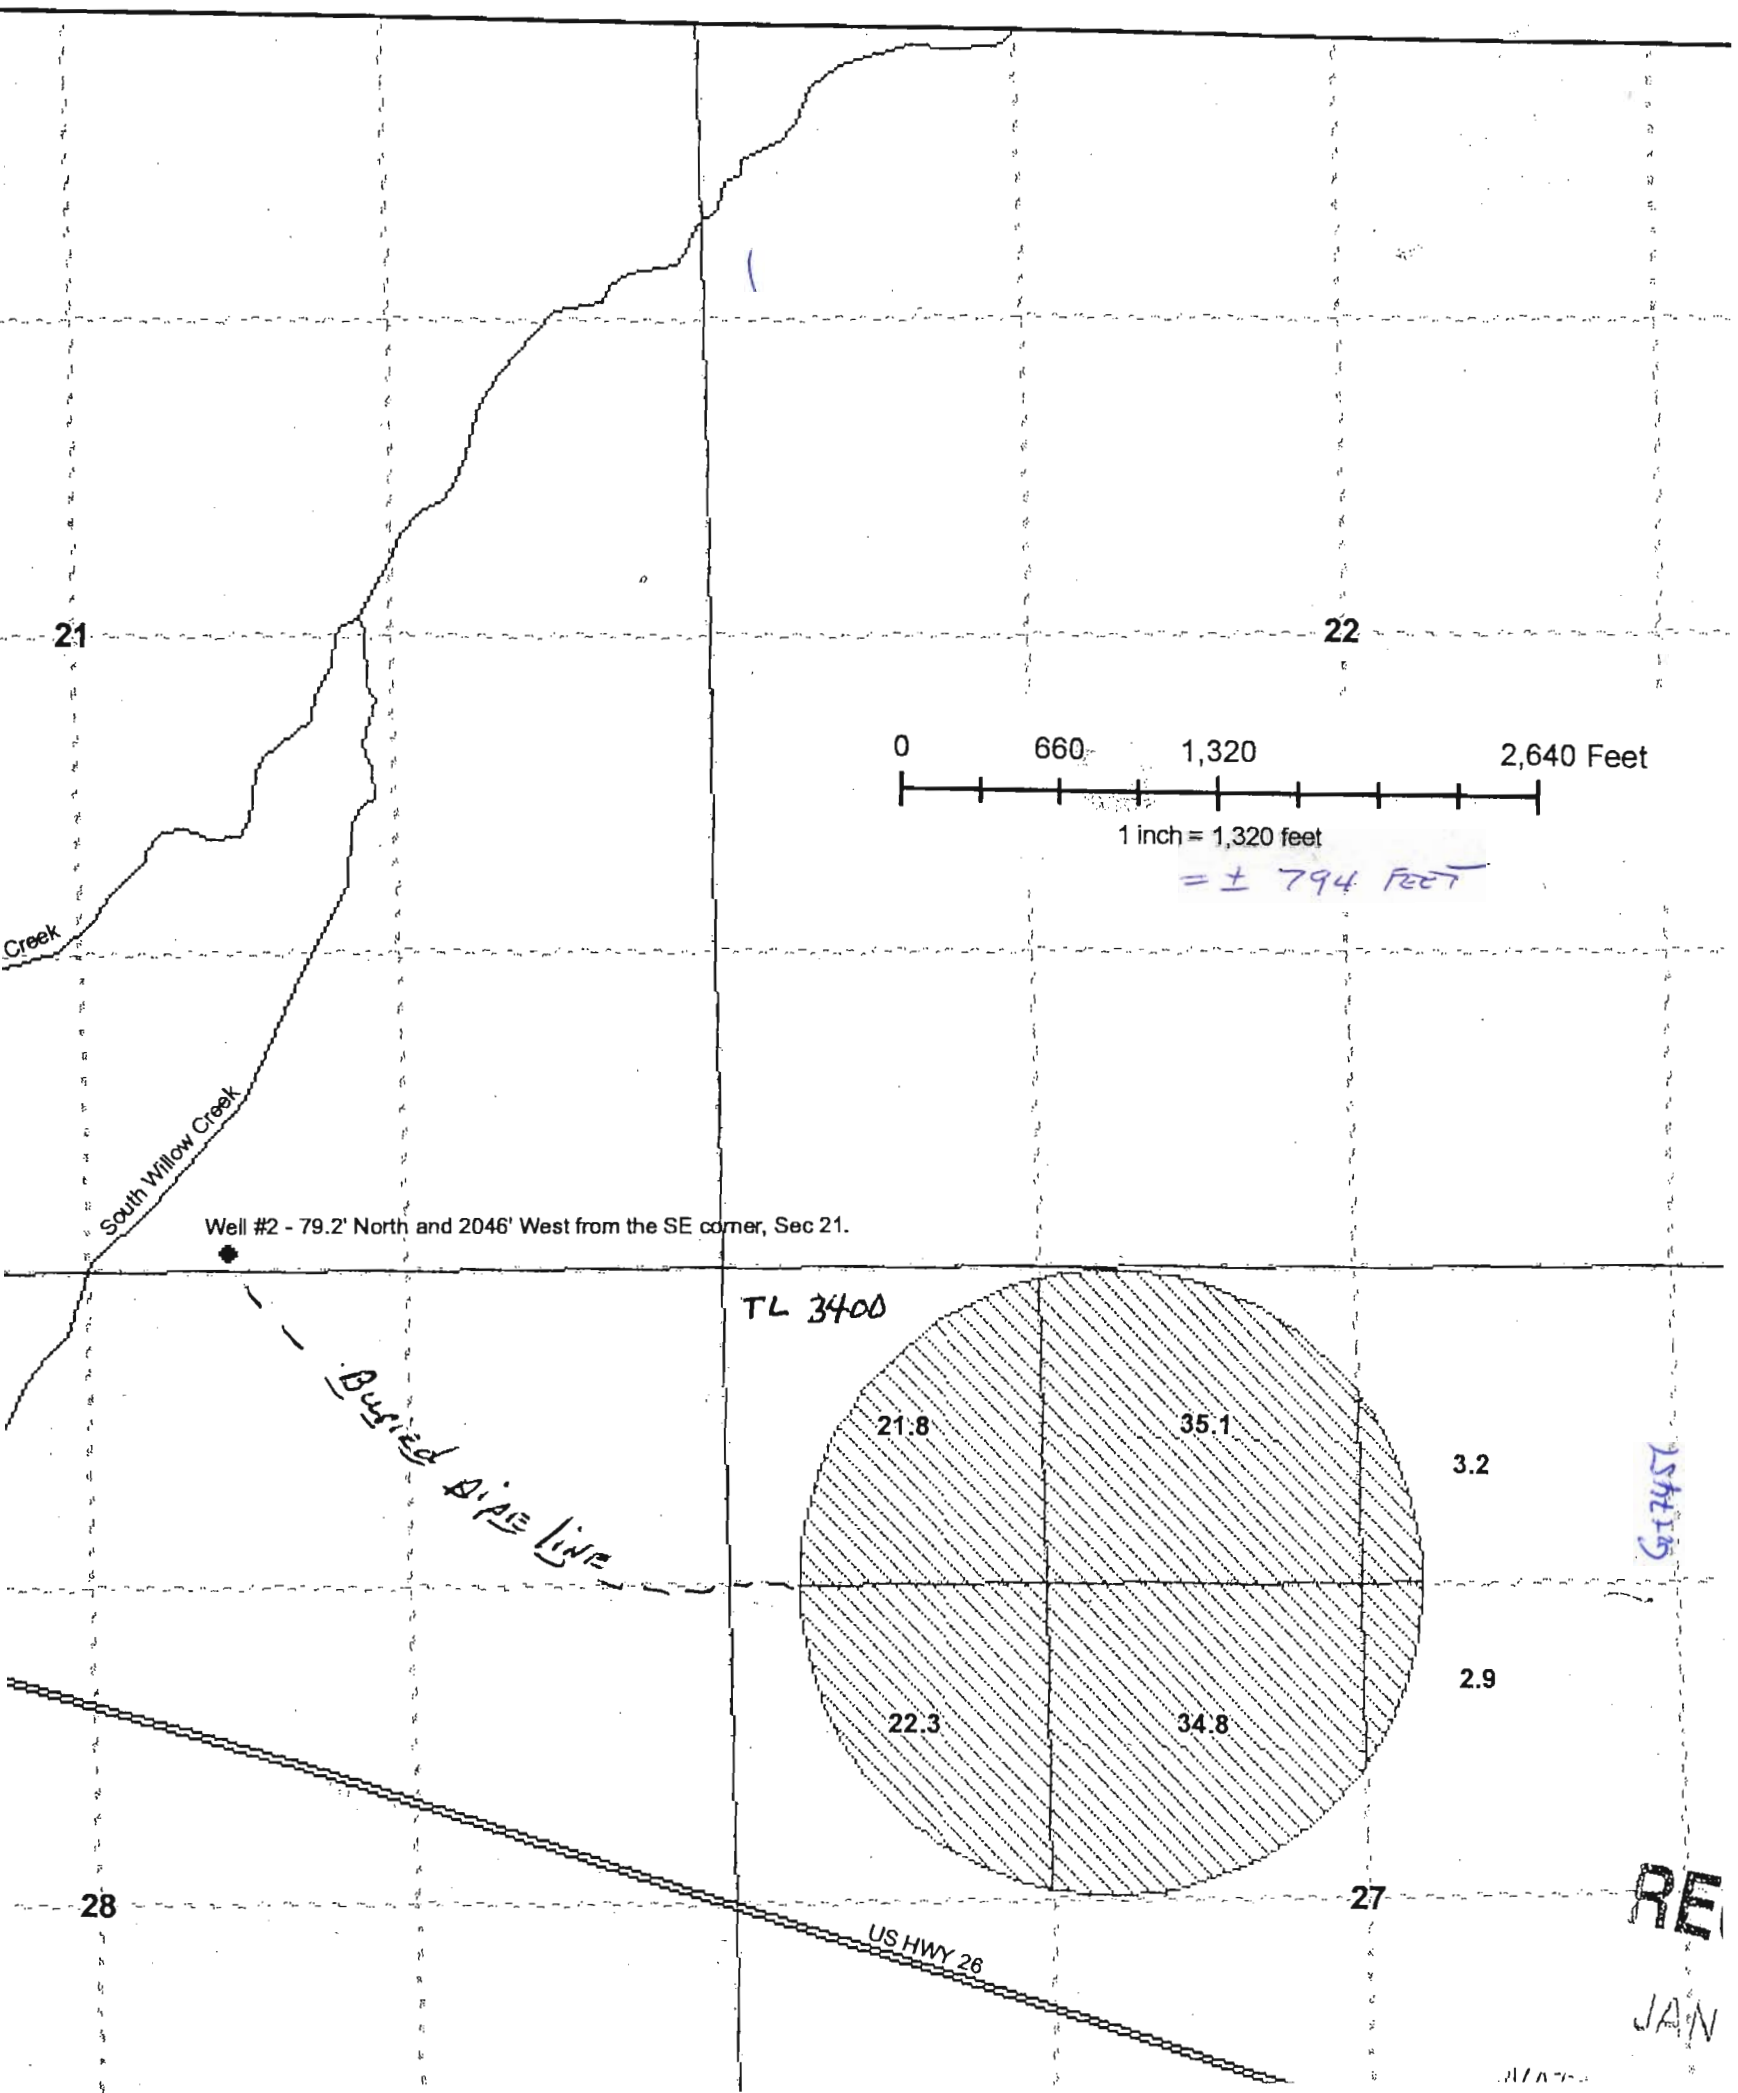

0 660 1,320 2,640 Feet
1 inch = 1,320 feet
= ± 794 FEET

Well #2 - 79.2' North and 2046' West from the SE corner, Sec 21.

Buried PIPE LINE

TL 3400

21.8

35.1

3.2

22.3

34.8

2.9

US HWY 26

15715

RE

JAN

Chris Ray - Water Right Application Map

Township 14 South, Range 39 East, W.M.

