


Neig Harbor
Fischer Casino

RECEIVED
FEB 04 2011
WATER RESOURCES DEPT
SALEM, OREGON

WATER RESOURCES DEPT
SALEM, OREGON

DEC 08 2009


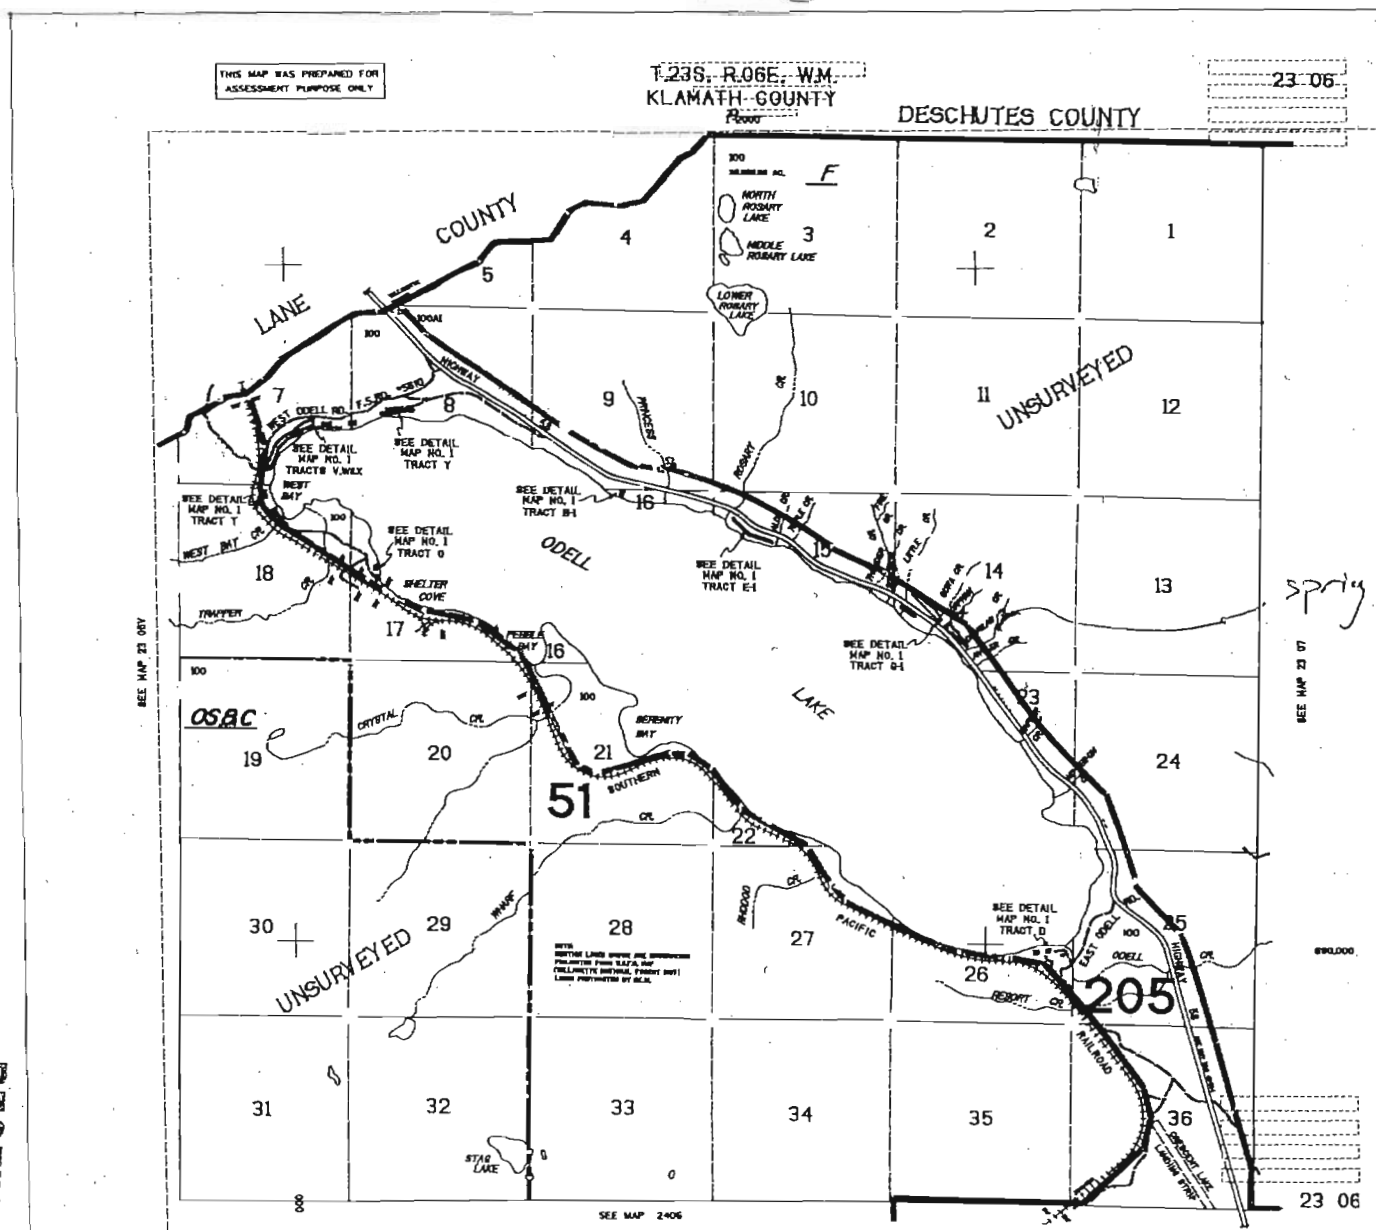

DATE

NOV 30 2009

WATER RESOURCES DEPT
'SALEM, OREGON

spring location

257017

RECEIVED

FEB 04 2011

WATER RESOURCES DEPT
SALEM, OREGON

RECEIVED

DEC 08 2009

WATER RESOURCES DEPT
SALEM, OREGON


WORK
COPY

RECEIVED

NOV 30 2009

WATER RESOURCES DEPT
SALEM, OREGON


38978-5

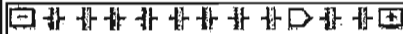

- ☒ OWRD Data
 - ☒ Rule Boundaries
 - ☒ Political Boundaries
 - ☒ Water Availability
 - ☒ Water Rights
 - ☒ Surface water
- ☒ Base Data
 - ☒ Political Boundaries
 - ☒ PLS
 - ☒ Roads
 - ☒ Surface water
 - ☒ Topography
 - ☒ Hillshade (state)
 - ☒ Hillshade (region)
- ☒ Imagery
 - ☒ Aerial Photography
 - ☒ USGSquads

NEIGHBOR'S
fischer Cabin

John fischer
2197 Jeppesen Acres Rd
Eugene OR 97401
jfischer51@gmail.com
541-683-5866

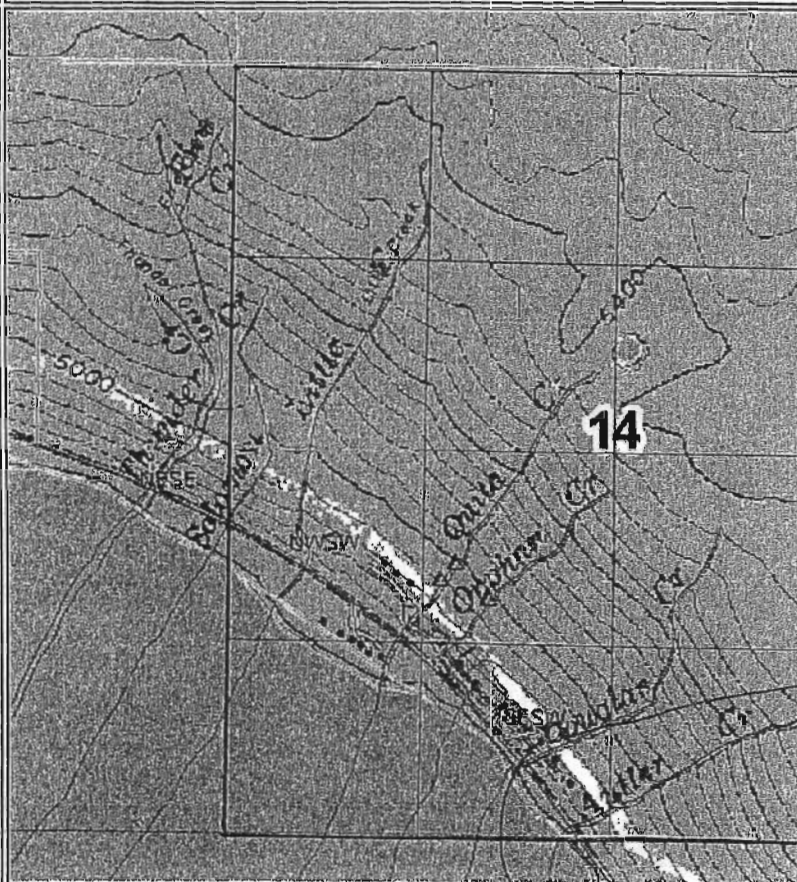

Spring is located:
600 ft N of the S border
of quarter quarter SESW
section 14, T23S, R6E,
and
508 ft W of the E border of
quarter quarter SESW
section 14, T23S, R6E.

Spring Location

cabin location

CORRECTED ADJUSTED
APPROX SCALE
1" = 1320 Feet

T23S R6E Section 14

38978-5

Zoom In

Zoom Out

Pan

Full Extent

NOV 30 2009

S-87558

WATER RESOURCES DEPT
SALEM, OREGON

2 CABINS SAME P.O.D.

Spring is located:
600 ft N of the S border
of quarter quarter SE SW
section 14, T23S, R6E,
and
508 ft W of the E border of
quarter quarter SE SW
section 14, T23S, R6E.

RECEIVED

FEB 04 2011

WATER RESOURCES DEPT
SALEM, OREGON

Spring Location

RECEIVED

DEC 08 2009

WATER RESOURCES DEPT
SALEM, OREGON
☒ OWRD Data

- ☒ Rule Boundaries
- ☒ Political Boundaries
- ☒ Water Availability
- ☒ Water Rights
- ☒ Surface water

☒ Base Data


- ☒ Political Boundaries
- ☒ PLS
- ☒ Roads
- ☒ Surface water
- ☒ Topography
 - ☒ Hillshade (state)
 - ☒ Hillshade (region)

☒ Imagery

- ☒ Aerial Photography
- ☒ USGSquads

CABIN NEXT DOOR
fischer Cabin

John fischer
2197 Jeppesen Acres Rd
Eugene OR 97401
jfischer51@gmail.com
541-683-5866

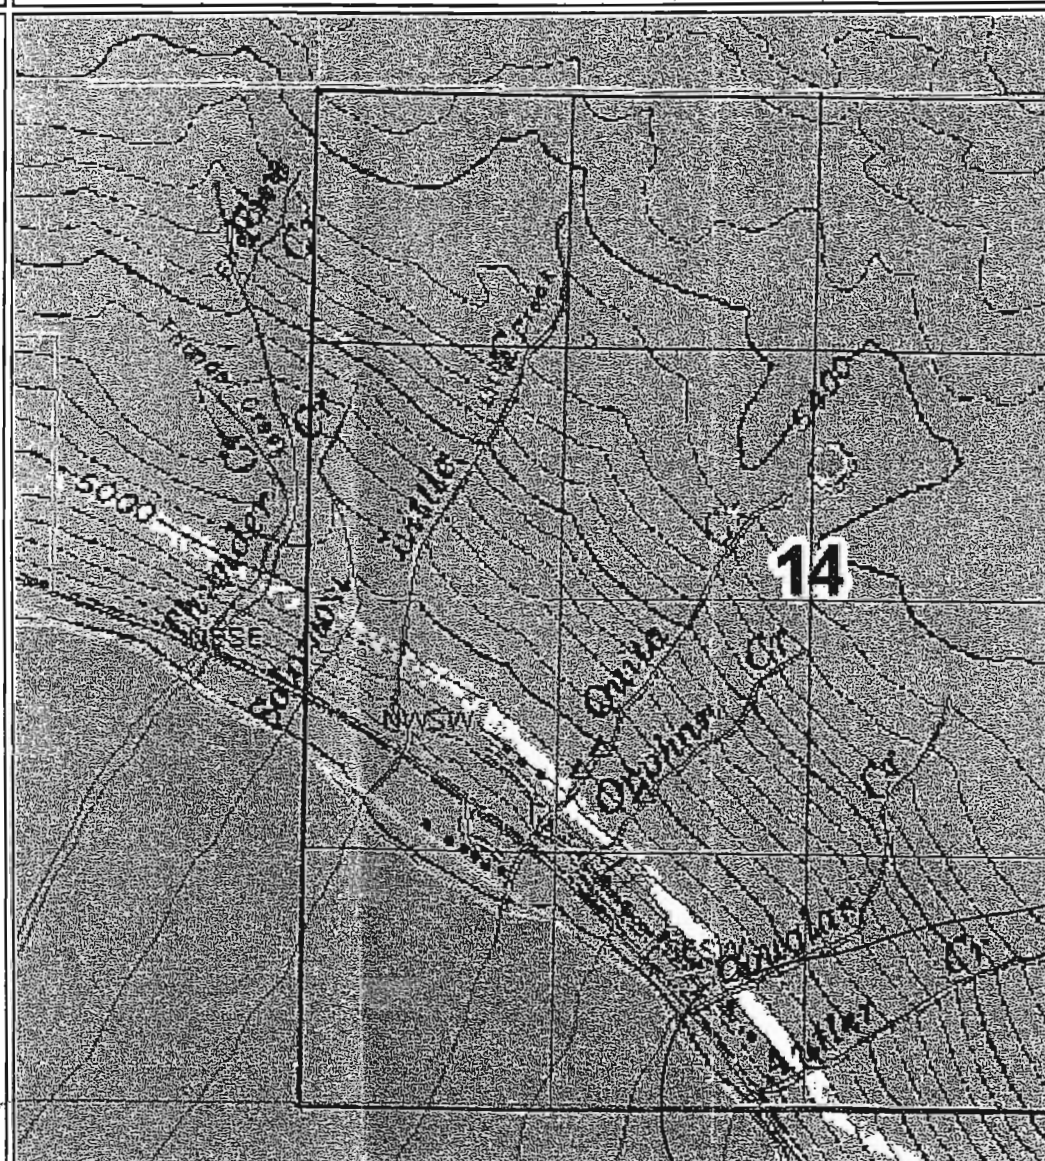

CORRECTED APPROX. ADJUSTED SCALE

1" = 1000 Feet

Cabin location

WORK
COPY

T23S R6E Section 14

S-87688