


MEANDER CORNER

SECTION 18
SECTION 19

SECTION 18
SECTION 19

1/4 CORNER

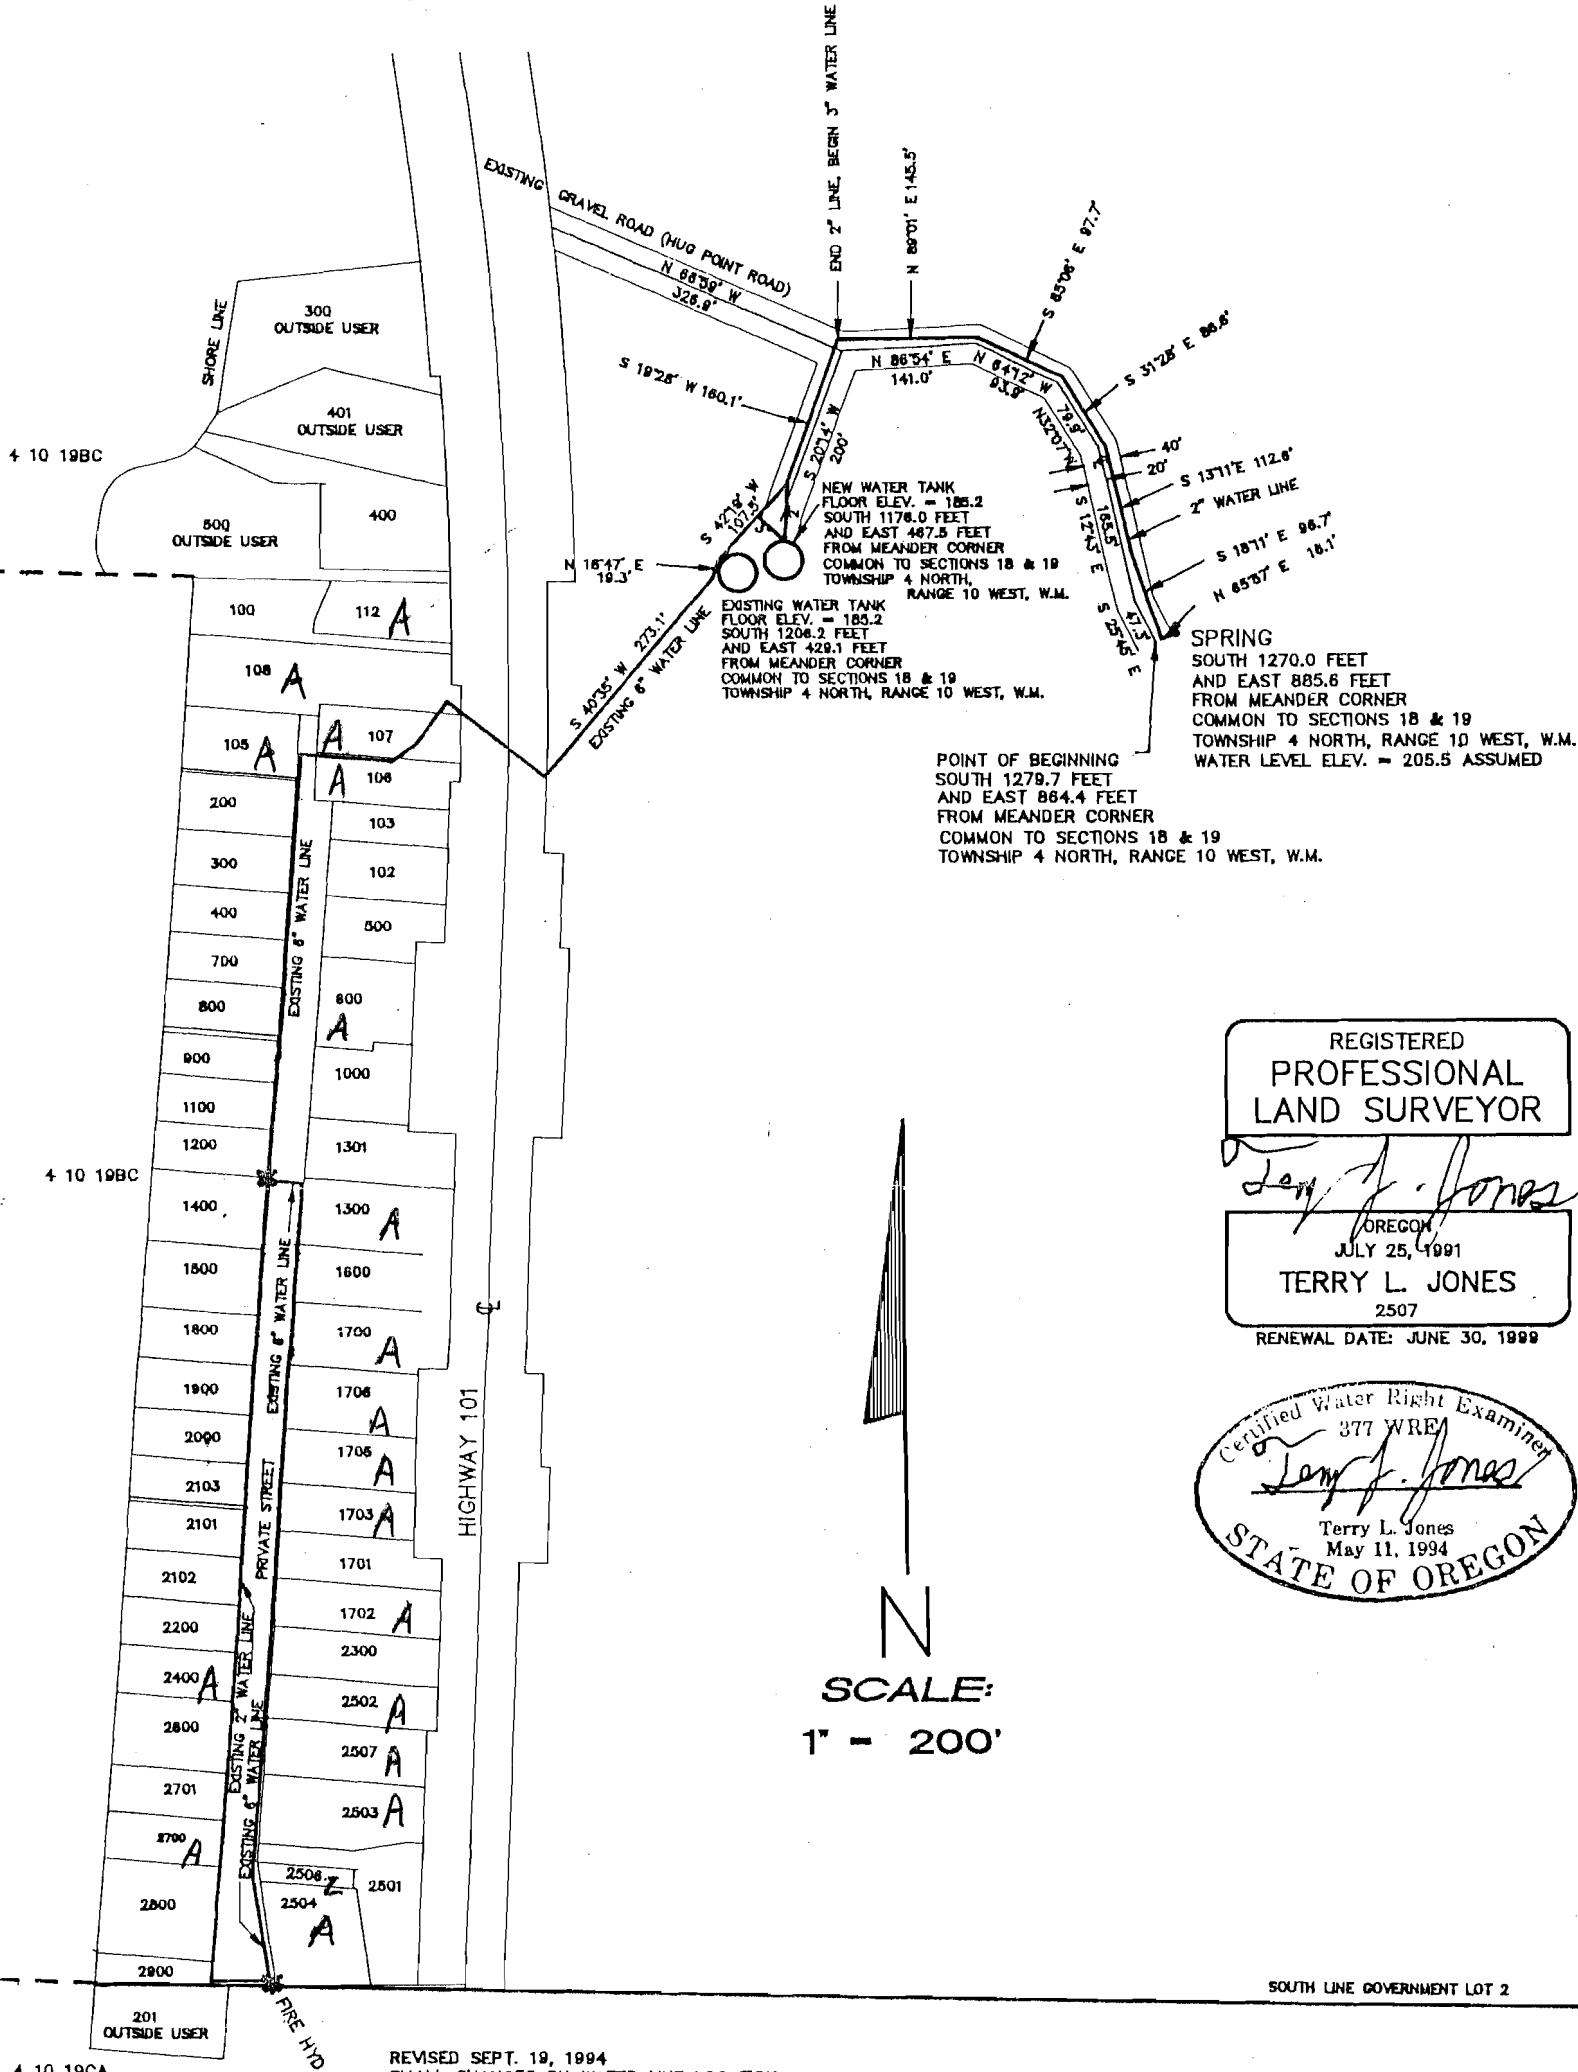

REGISTERED
PROFESSIONAL
LAND SURVEYOR
Terry L. Jones
OREGON
JULY 25, 1991
TERRY L. JONES
2507
RENEWAL DATE: JUNE 30, 1999

Certified Water Right Examiner
377 WRE
Terry L. Jones
Terry L. Jones
May 11, 1994
STATE OF OREGON

N
SCALE:
1" = 200'

REVISED SEPT. 19, 1994
SMALL CHANGES ON WATER LINE LOCATION
AND LABEL ROAD CENTERLINE.
REVISED OCT. 17, 1994
ADDED OUTSIDE USER'S
REVISED SEPT. 29, 1998
INDICATED NEW WATER TANK

FINAL PROOF SURVEY FOR
APPLICATION FILE No. 73068
PERMIT No. 51550

SITE\CVPWD-SV.DWG
CVPWD.CR5

SURVEY BY:
BAYSIDE SURVEYING
11765 HWY 101 SOUTH
TILLAMOOK, OR. 97141
(503) 842-5551

SURVEY FOR:
CANNON VIEW PARK
WATER DISTRICT
SECTION 19, T4N, R10W, W.M.
CLATSOP COUNTY, OR

DATE	EQUIPMENT	FIELD	DRAWN	CHECKED	JOB NO.
SEPT. 29, 1998	TOPCON GTS-303 TDS 480	TLJ/CJH	CJH	TLJ	

RECEIVED
OCT 07 1998
WATER RESOURCES DEPT.
SALEM, OREGON