
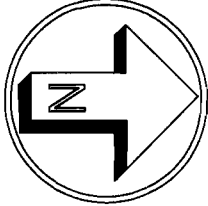


FINAL PROOF MAP – PERMIT G-12853

LOCATED IN
SECTIONS 27 & 28, T. 19 S., R. 22 E., W.M.
CROOK COUNTY, OREGON

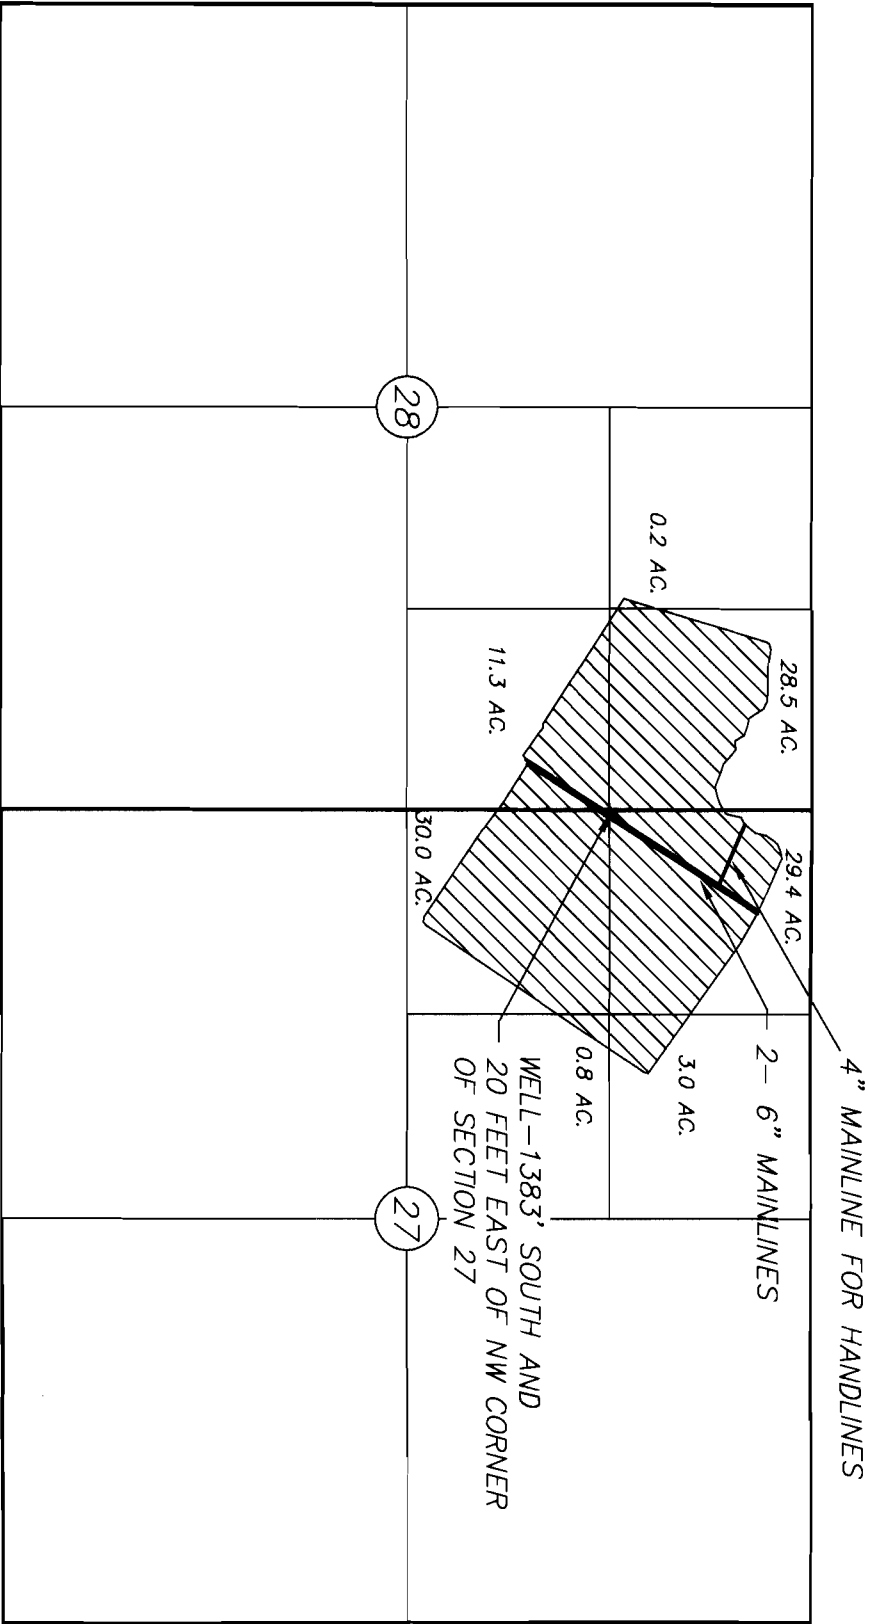

 = IRRIGATED AREA

I, ROBERT E. BAXTER, CERTIFIED WATER RIGHT EXAMINER
IN THE STATE OF OREGON, HEREBY CERTIFY THAT THIS
WATER RIGHT SURVEY MAP WAS PREPARED BY ME.

THE PREPARATION OF THIS MAP IS FOR THE PURPOSE
OF IDENTIFYING THE LOCATION OF THE WATER RIGHT
ONLY AND HAS NO INTENT TO PROVIDE DIMENSIONS OR
LOCATIONS OF PROPERTY OWNERSHIP LINES.



RECEIVED
APR 20 2000
WATER RESOURCES DEPT.
SALEM, OREGON

PREPARED BY
BAXTER LAND SURVEYING, INC.
20370 EMPIRE AVE. SUITE C3
BEND, ORE. 97701 (541) 382-1962

FINAL PROOF MAP
FOR
NORM HYATT

PREPARED FOR: NORM HYATT
HC 67, BOX 550
PRINEVILLE, OREGON 97754 (541)-477-3533
SCALE: 1" = 1320'
DATE: 4-12-00