
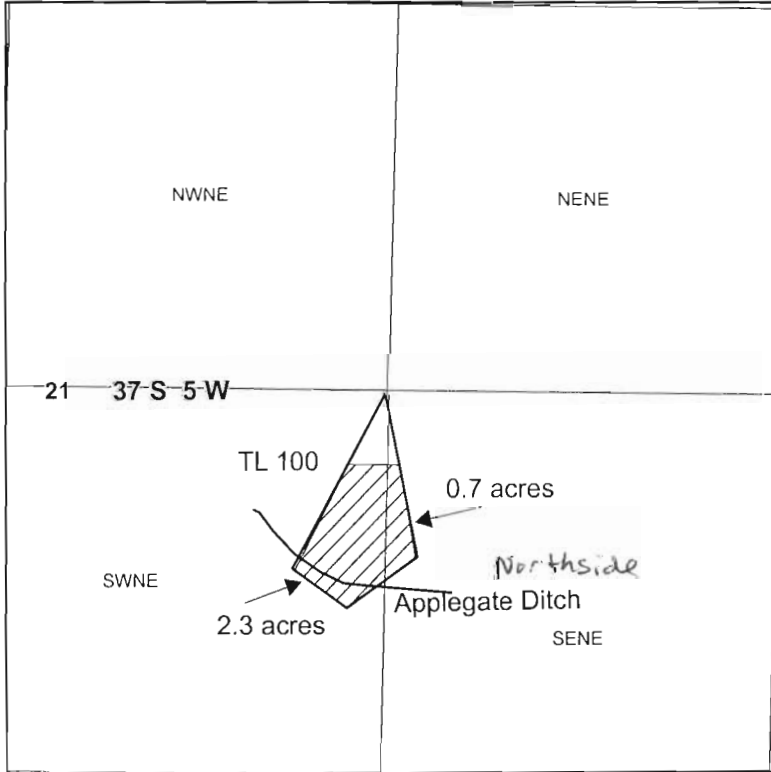



T37S R5W Sec 21

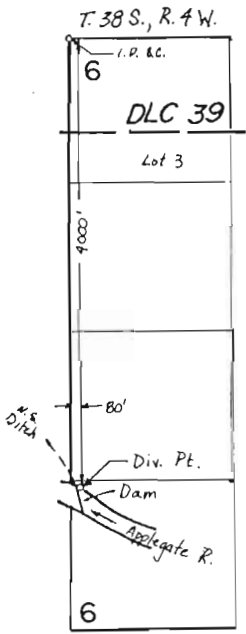

1 inch = 660 feet

RECEIVED
 FEB 07 2011
 WATER RESOURCES DEPT
 SALEM, OREGON

T. 38 S., R. 4 W.

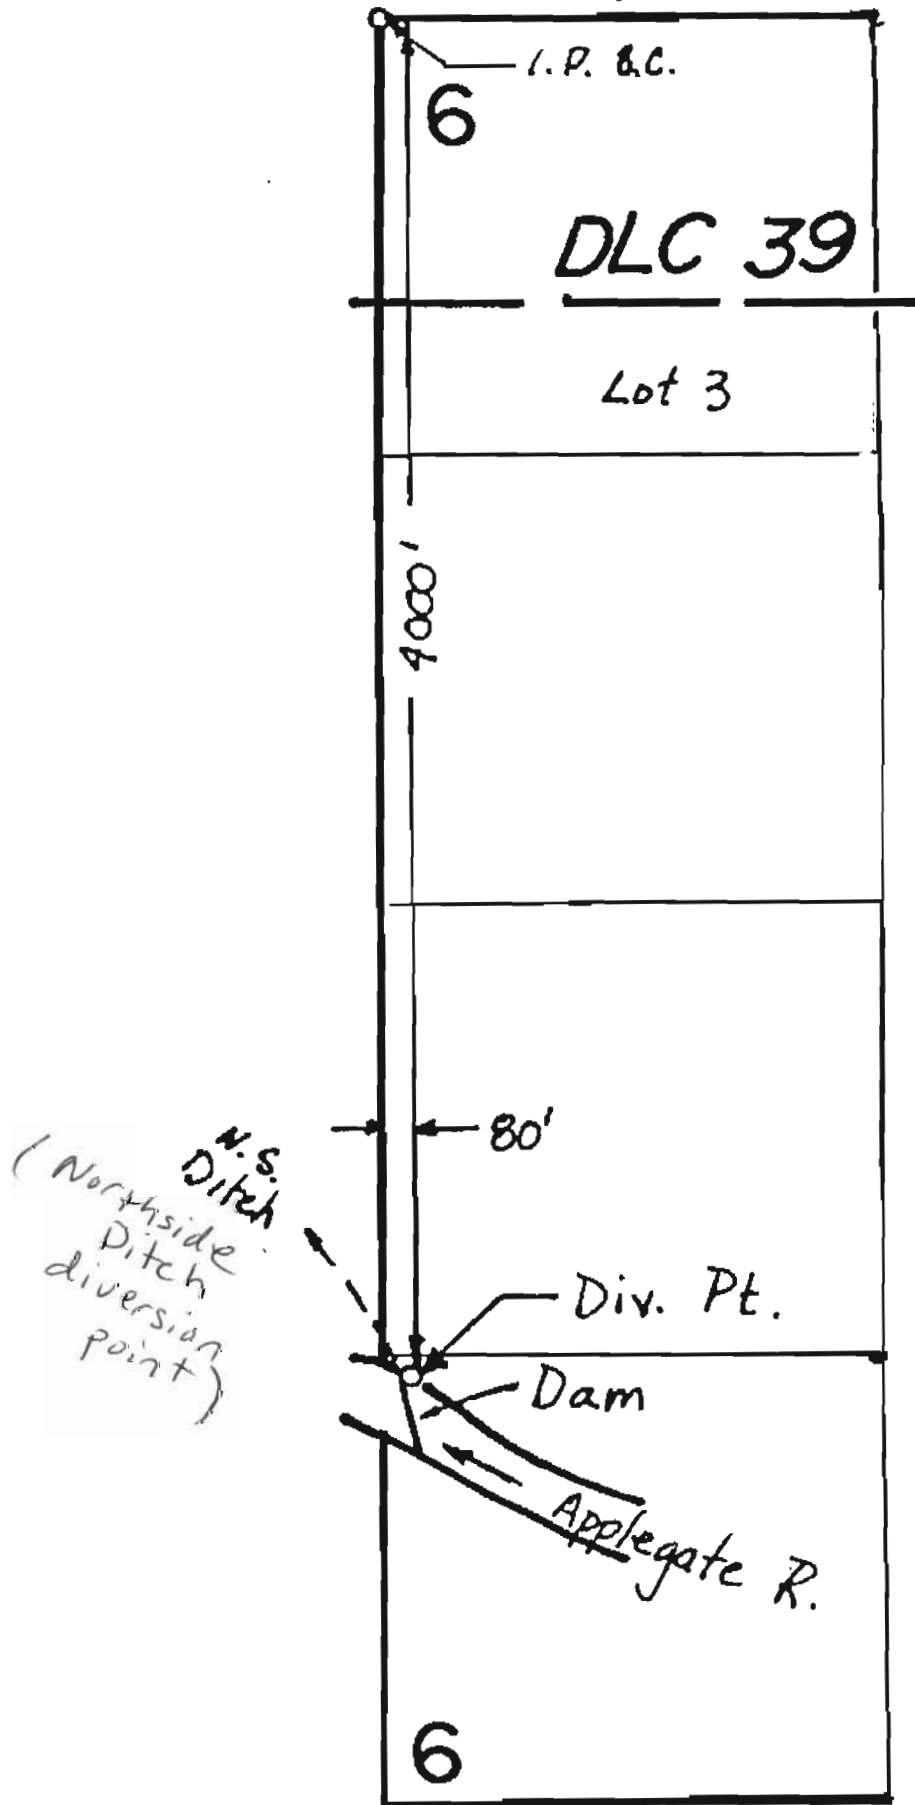

RECEIVED

FEB 07 2011

WATER RESOURCES DEPT
SALEM, OREGON