


SEC.27 T.26S. R.6W. W.M.  
DOUGLAS COUNTY  
Scale 1" = 500'

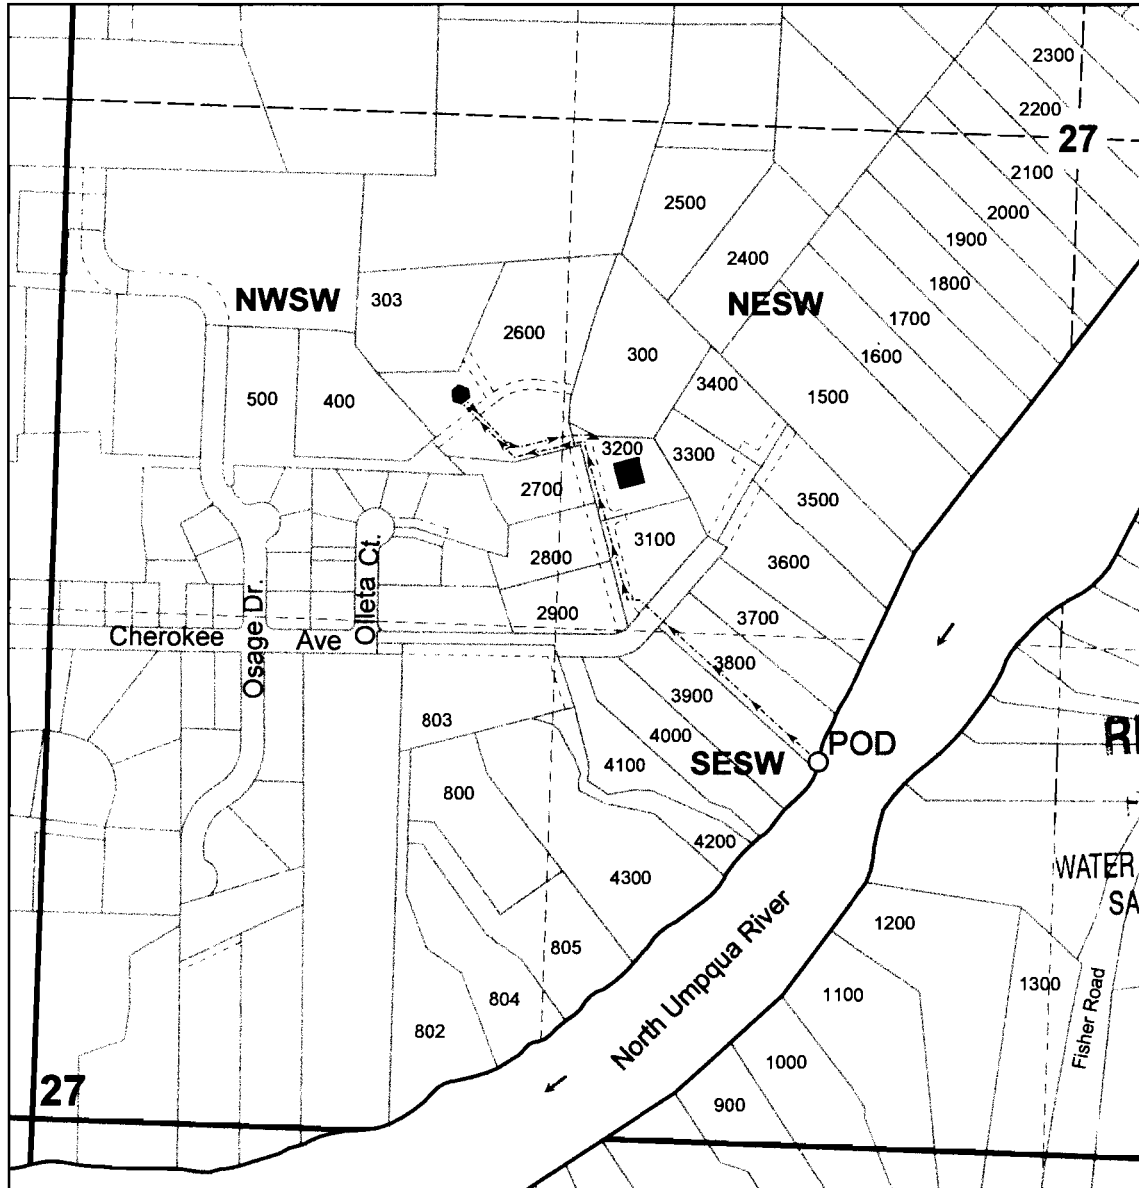

**RECEIVED**

FEB 11 2011

WATER RESOURCES DEPT  
SALEM, OREGON

POD is 1640' south and 635' west from the center of Section 27.