

72494

APPLICATION MAP


IN THE NAME OF: CRESTON BOSTON & GRACE OSTREM
SEC 35 T16S R2E WM

SCALE: 1" = 400'

RECEIVED
JUN 29 1987
WATER RESOURCES DIVISION
UNCES DEPT
STATE OF OREGON

Application No. 72494
Permit No. 51989

DIVERSION POINT IS
LOCATED 1460' NORTH
200' WEST OF THE SW 1/4
CORNER, SEC 35

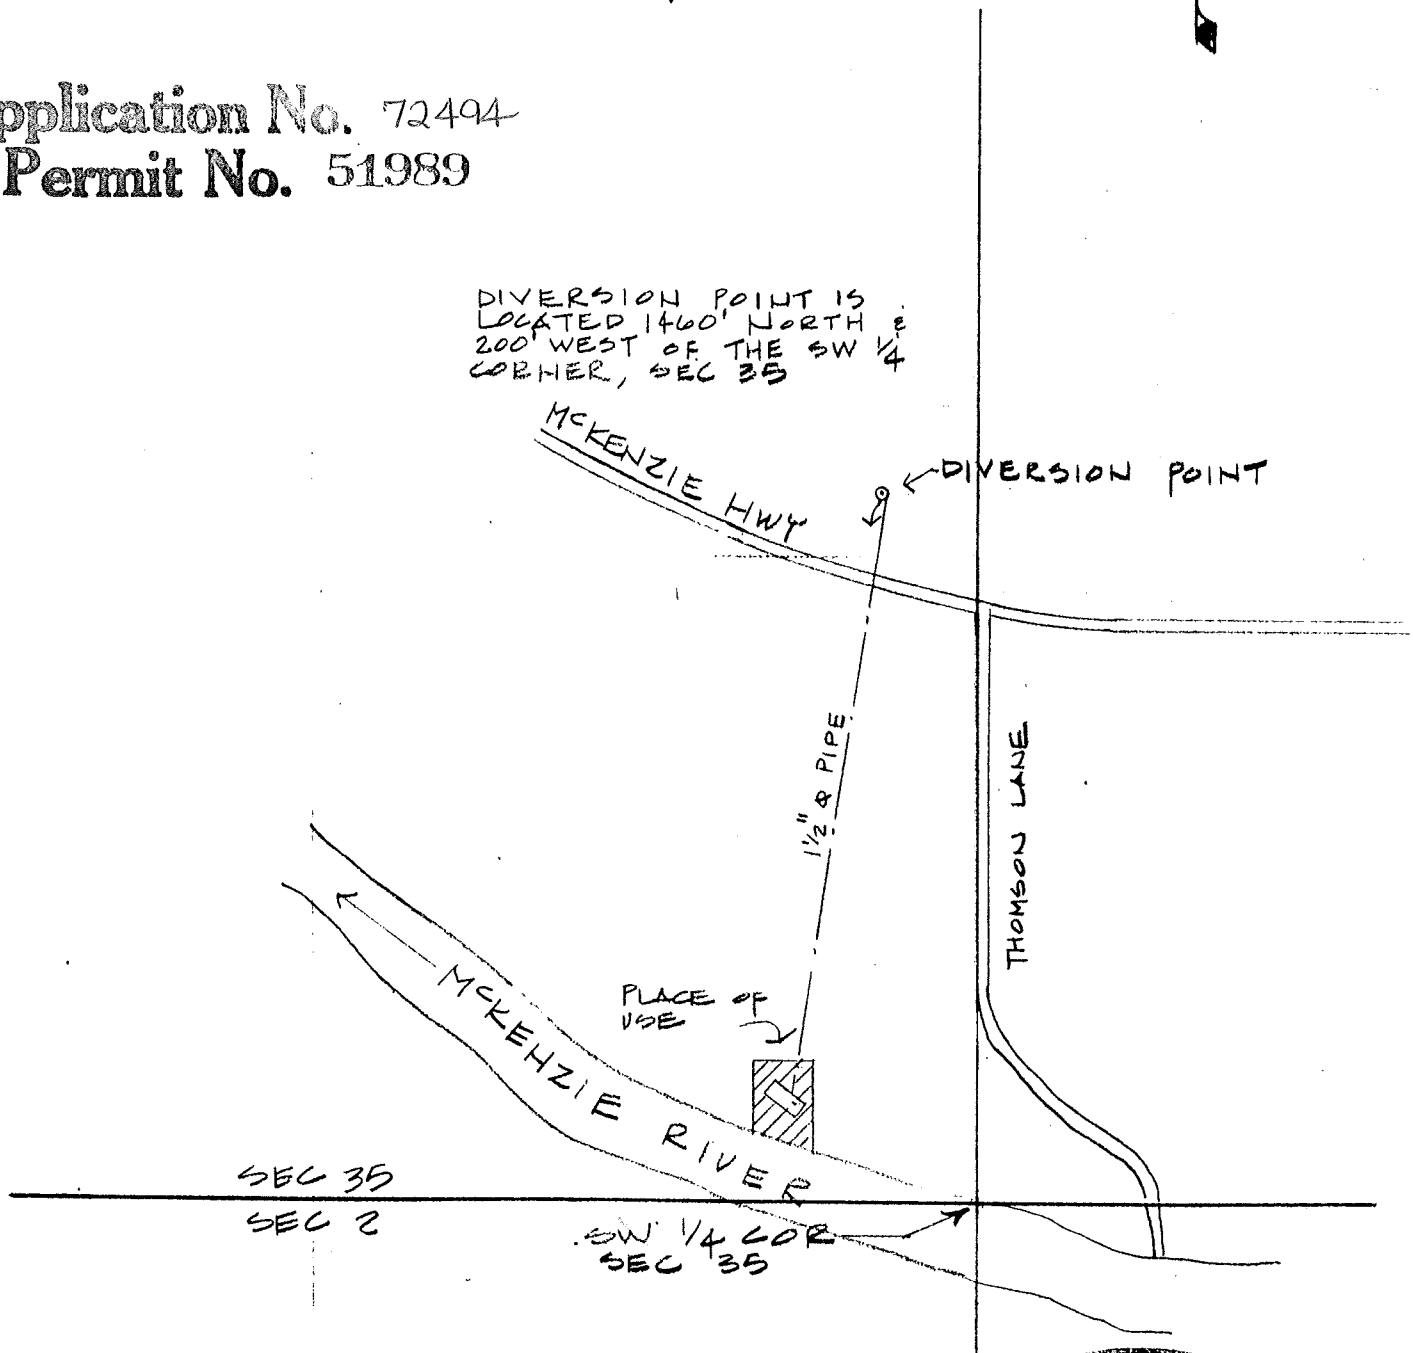

THE PURPOSE OF THIS MAP IS TO IDENTIFY THE LOCATION OF THE WATER RIGHT. IT IS NOT INTENDED TO PROVIDE INFORMATION RELATIVE TO THE LOCATION OF PROPERTY OWNERSHIP LINES.

Certified Water Right Examiner
#093
Emile Mortier
Emile Mortier
Nov. 19, 1987
STATE OF OREGON
6/4/87

Mortier Engineering, PC
PO Box 139, 474 Willamette
Eugene, OR 97440
503/484-9080 FAX 484-6859