


CERTIFICATE NO.

71504


RECEIVED
DEC 27 1994
WATER RESOURCES DIV.
SALEM, OREGON

APPLICATION MAP FOR EXISTING POND UNDER HB 2153

SW 1/4, SW 1/4, SEC 32, T 25 S, R 8 W

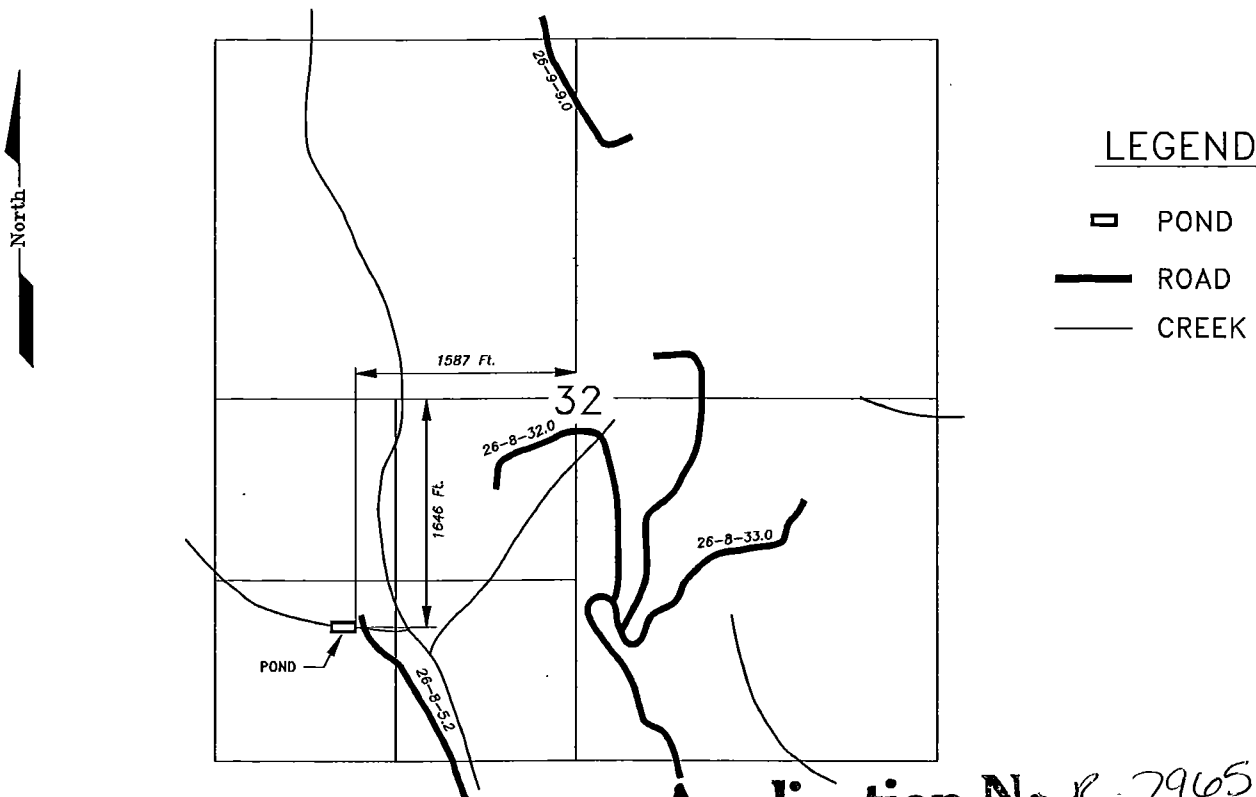

Application No. *R-79657*
Permit No.

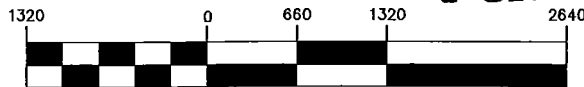

(IN FEET)
1 inch = 1320 ft.

THIS MAP IS FOR THE PURPOSE OF LOCATING
A WATER RIGHT, AND IS NOT INTENDED TO
PROVIDE LEGAL DIMENSIONS FOR LOCATION OF
PROPERTY BOUNDARIES.

U. S. DEPARTMENT OF THE INTERIOR
BUREAU OF LAND MANAGEMENT
COOS BAY DISTRICT OREGON

SLIDE CREEK AERIAL
WATERHOLE

DESIGNED JOSEPH T. EVRARD
REVIEWED JOHN A. FARMER
APPROVED BOYD W. PETERSON

DRAWN <u>T.Clark</u>	SCALE <u>1"=1320'</u>
DATE <u>10/25/94</u>	SHEET <u>1 OF 1</u>
FILE NAME: <u>SLIDE.DWG</u>	