


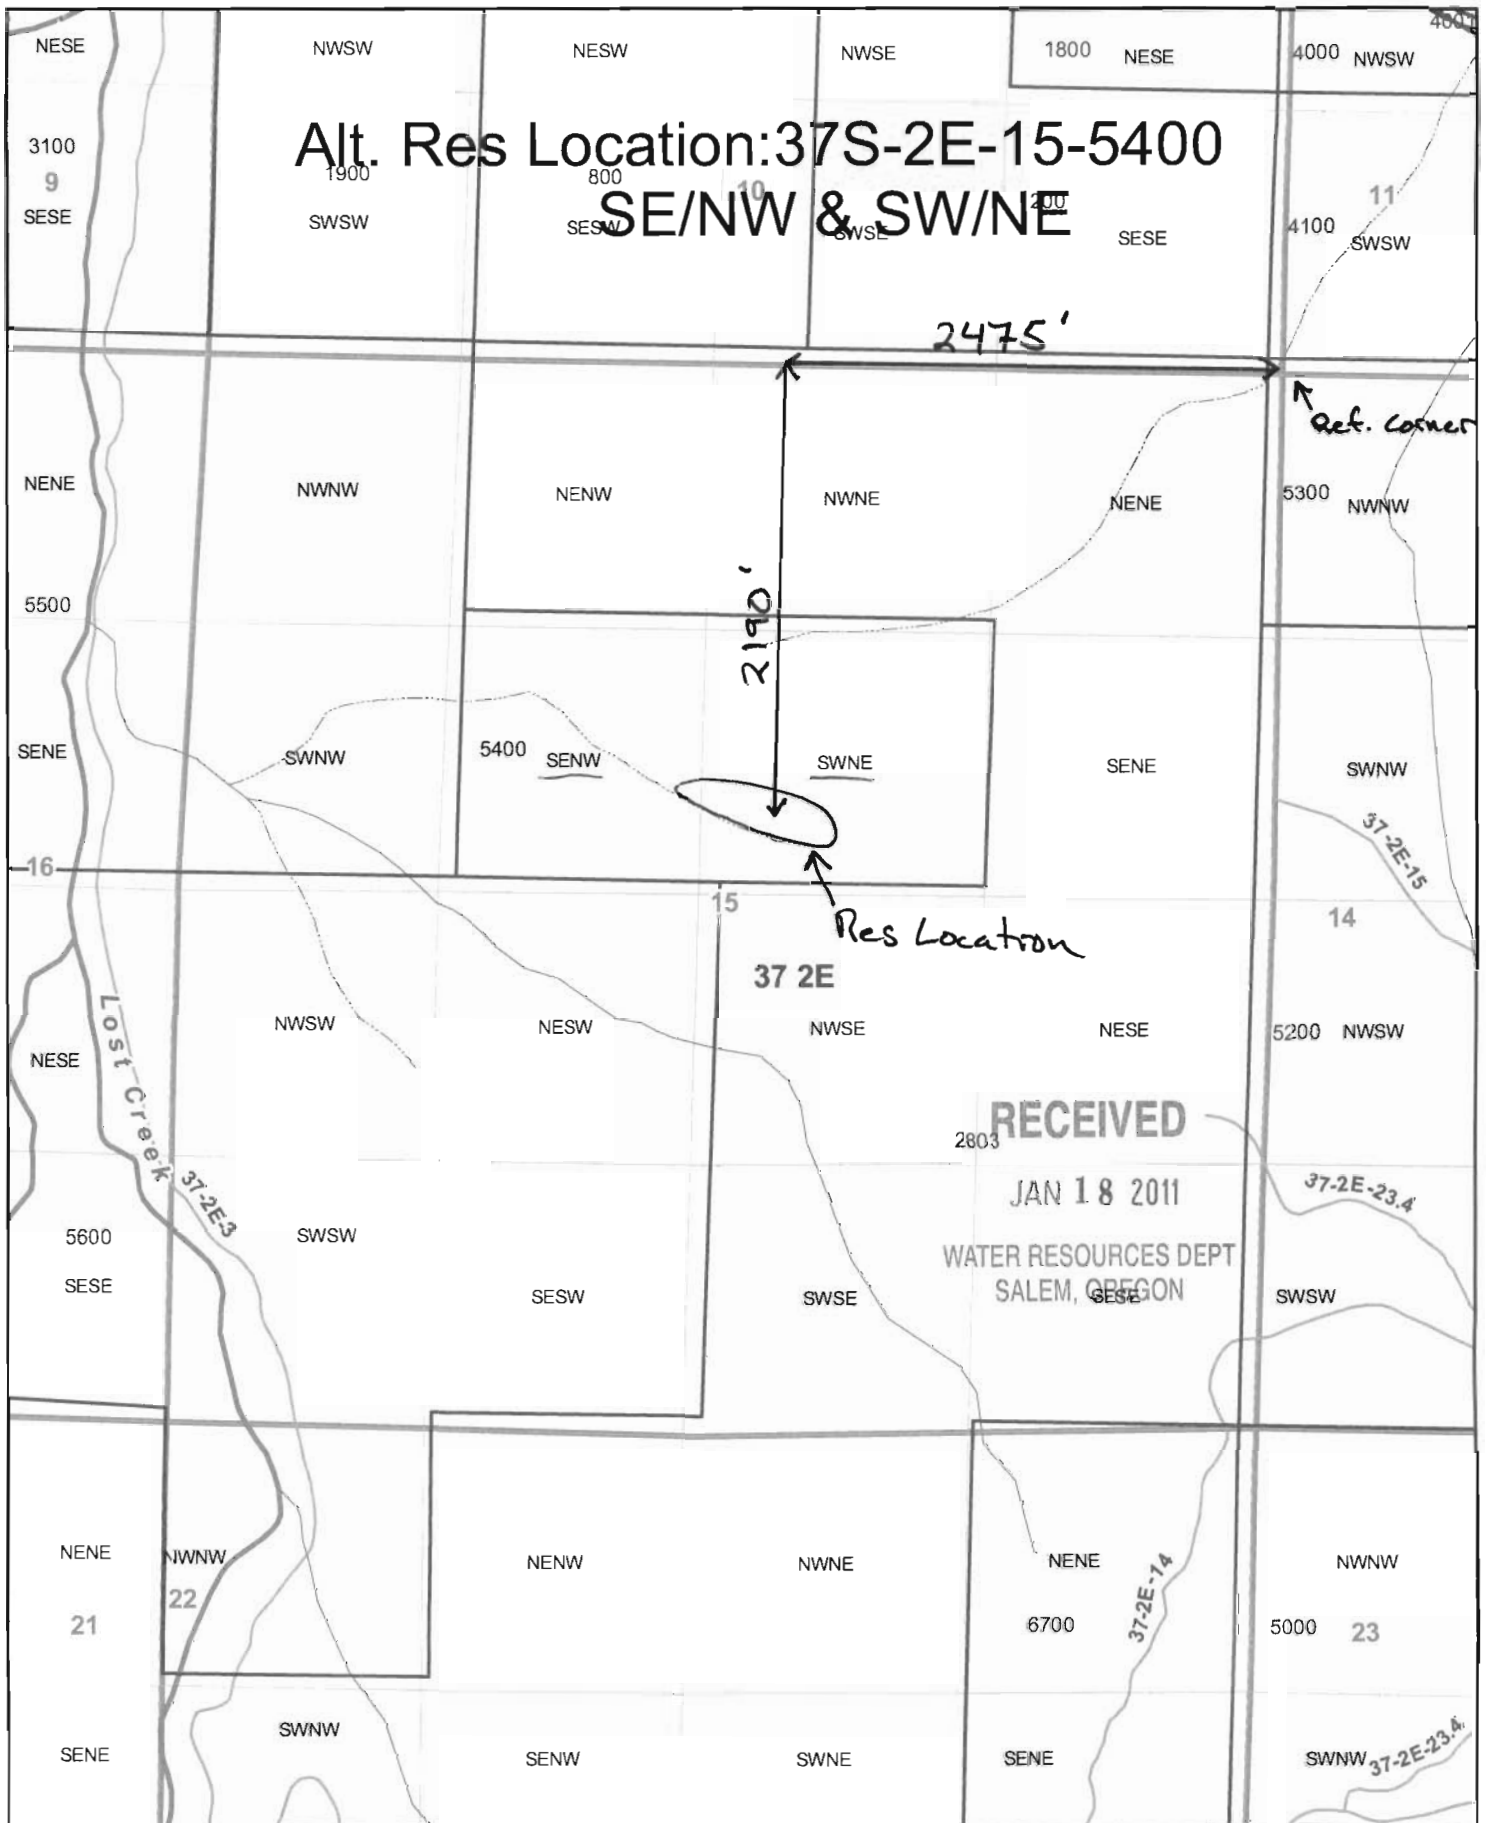

Legend

- Tax Lots
- quarter quarters
- Sections
- Townships

R-87682

1 inch = 952 feet

0 325 650 1,300 1,950 2,600 Feet




FOR ASSESSMENT AND
TAXATION ONLY

T.37S., R.2E., W.M.
JACKSON COUNTY
1" = 2000'

RECEIVED


JAN 18 2011

WATER RESOURCES DEPT
SALEM, OREGON

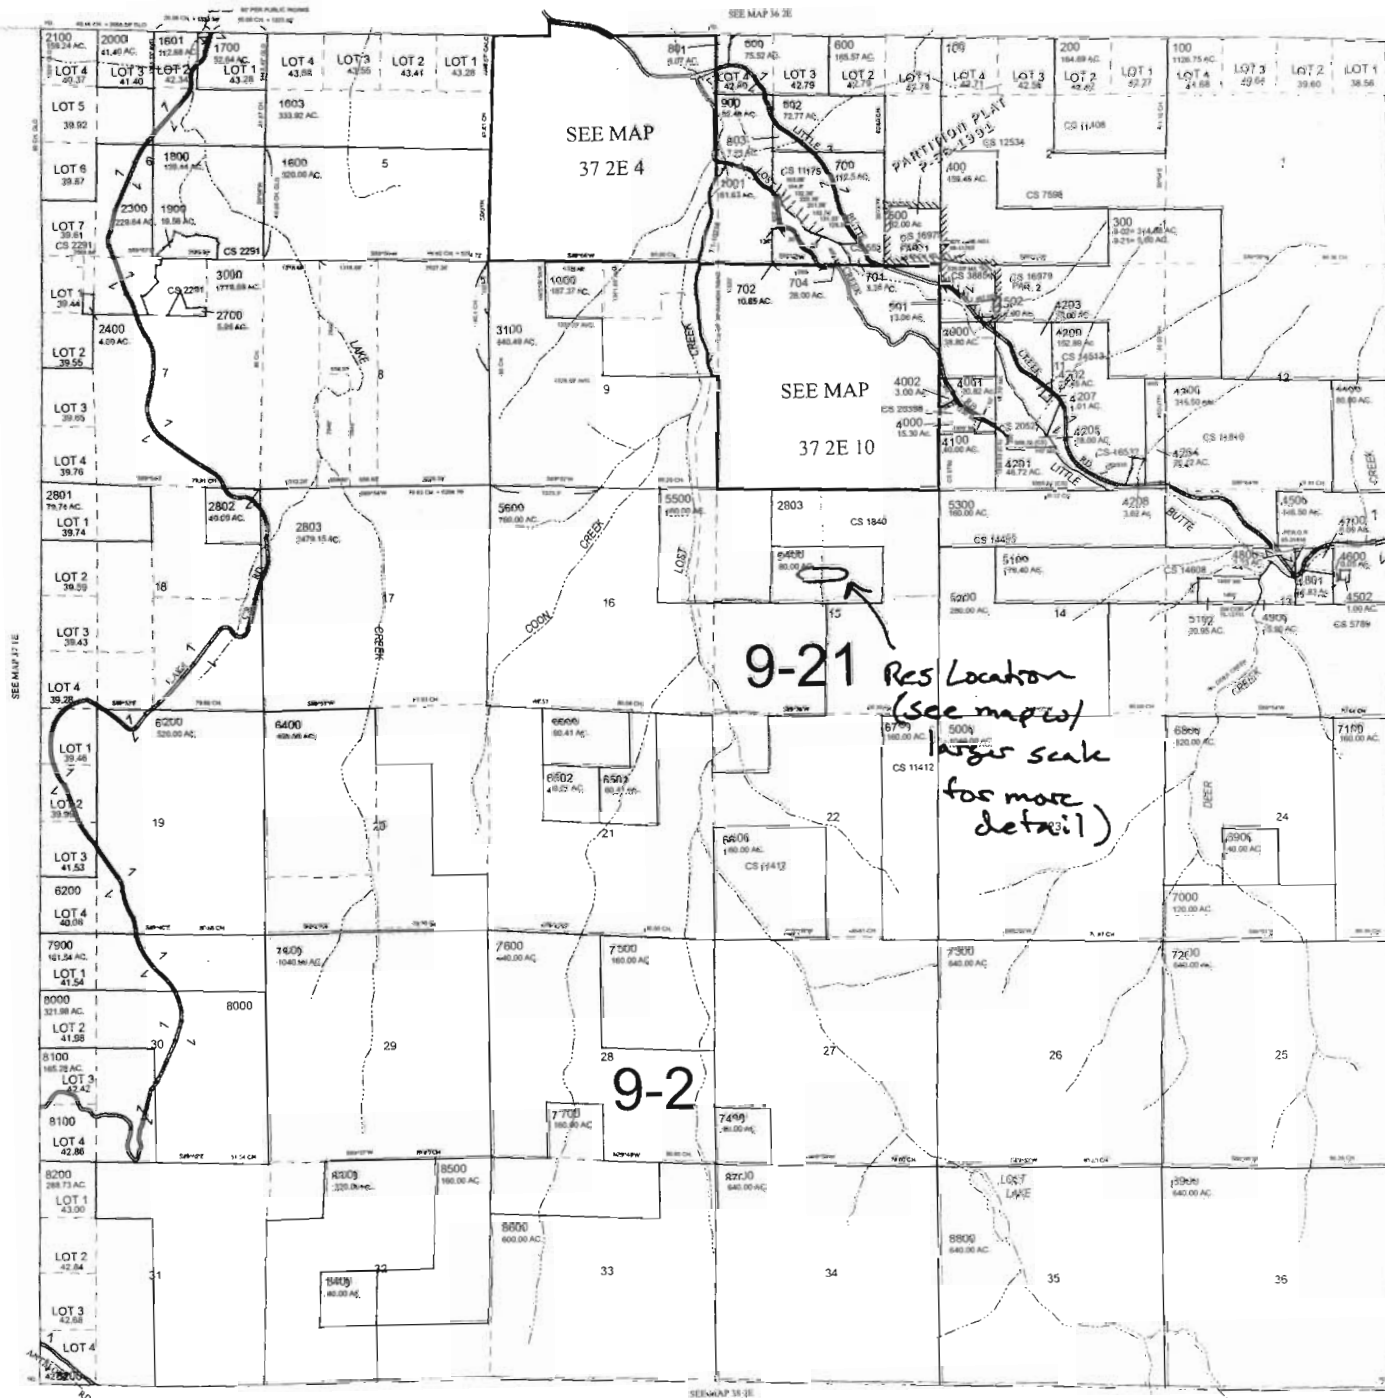

CANCELLED TAX
LOT NUMBERS

1100
1145
1200
1200
1300
1500
1500
1600
1600
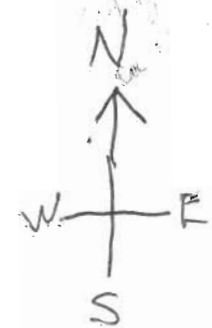



37 2E

DO NOT COPY OR REPRODUCE WITHOUT PERMISSION
REV. 1/9/2010


ation: 37S-2E-15-5400

SE/NW & SW/NE

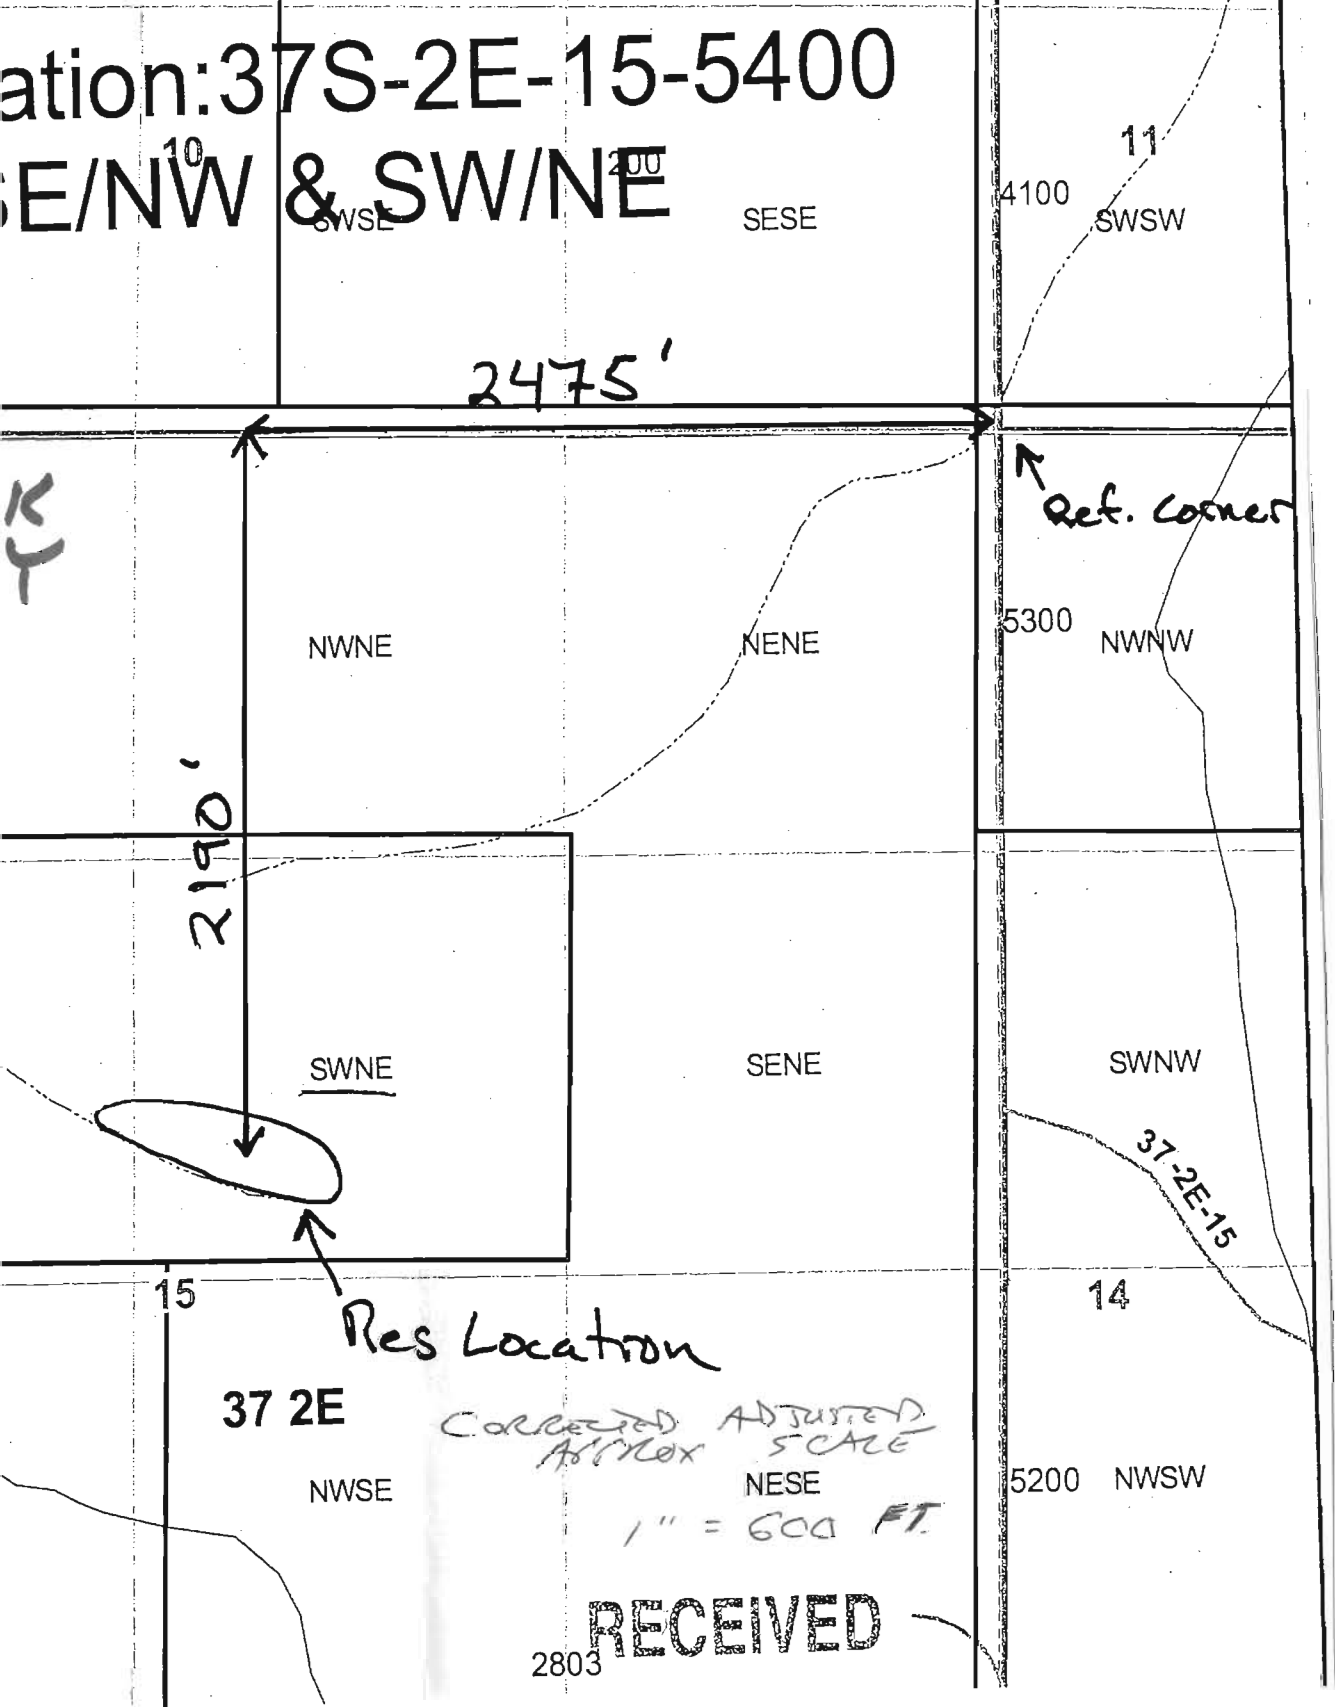

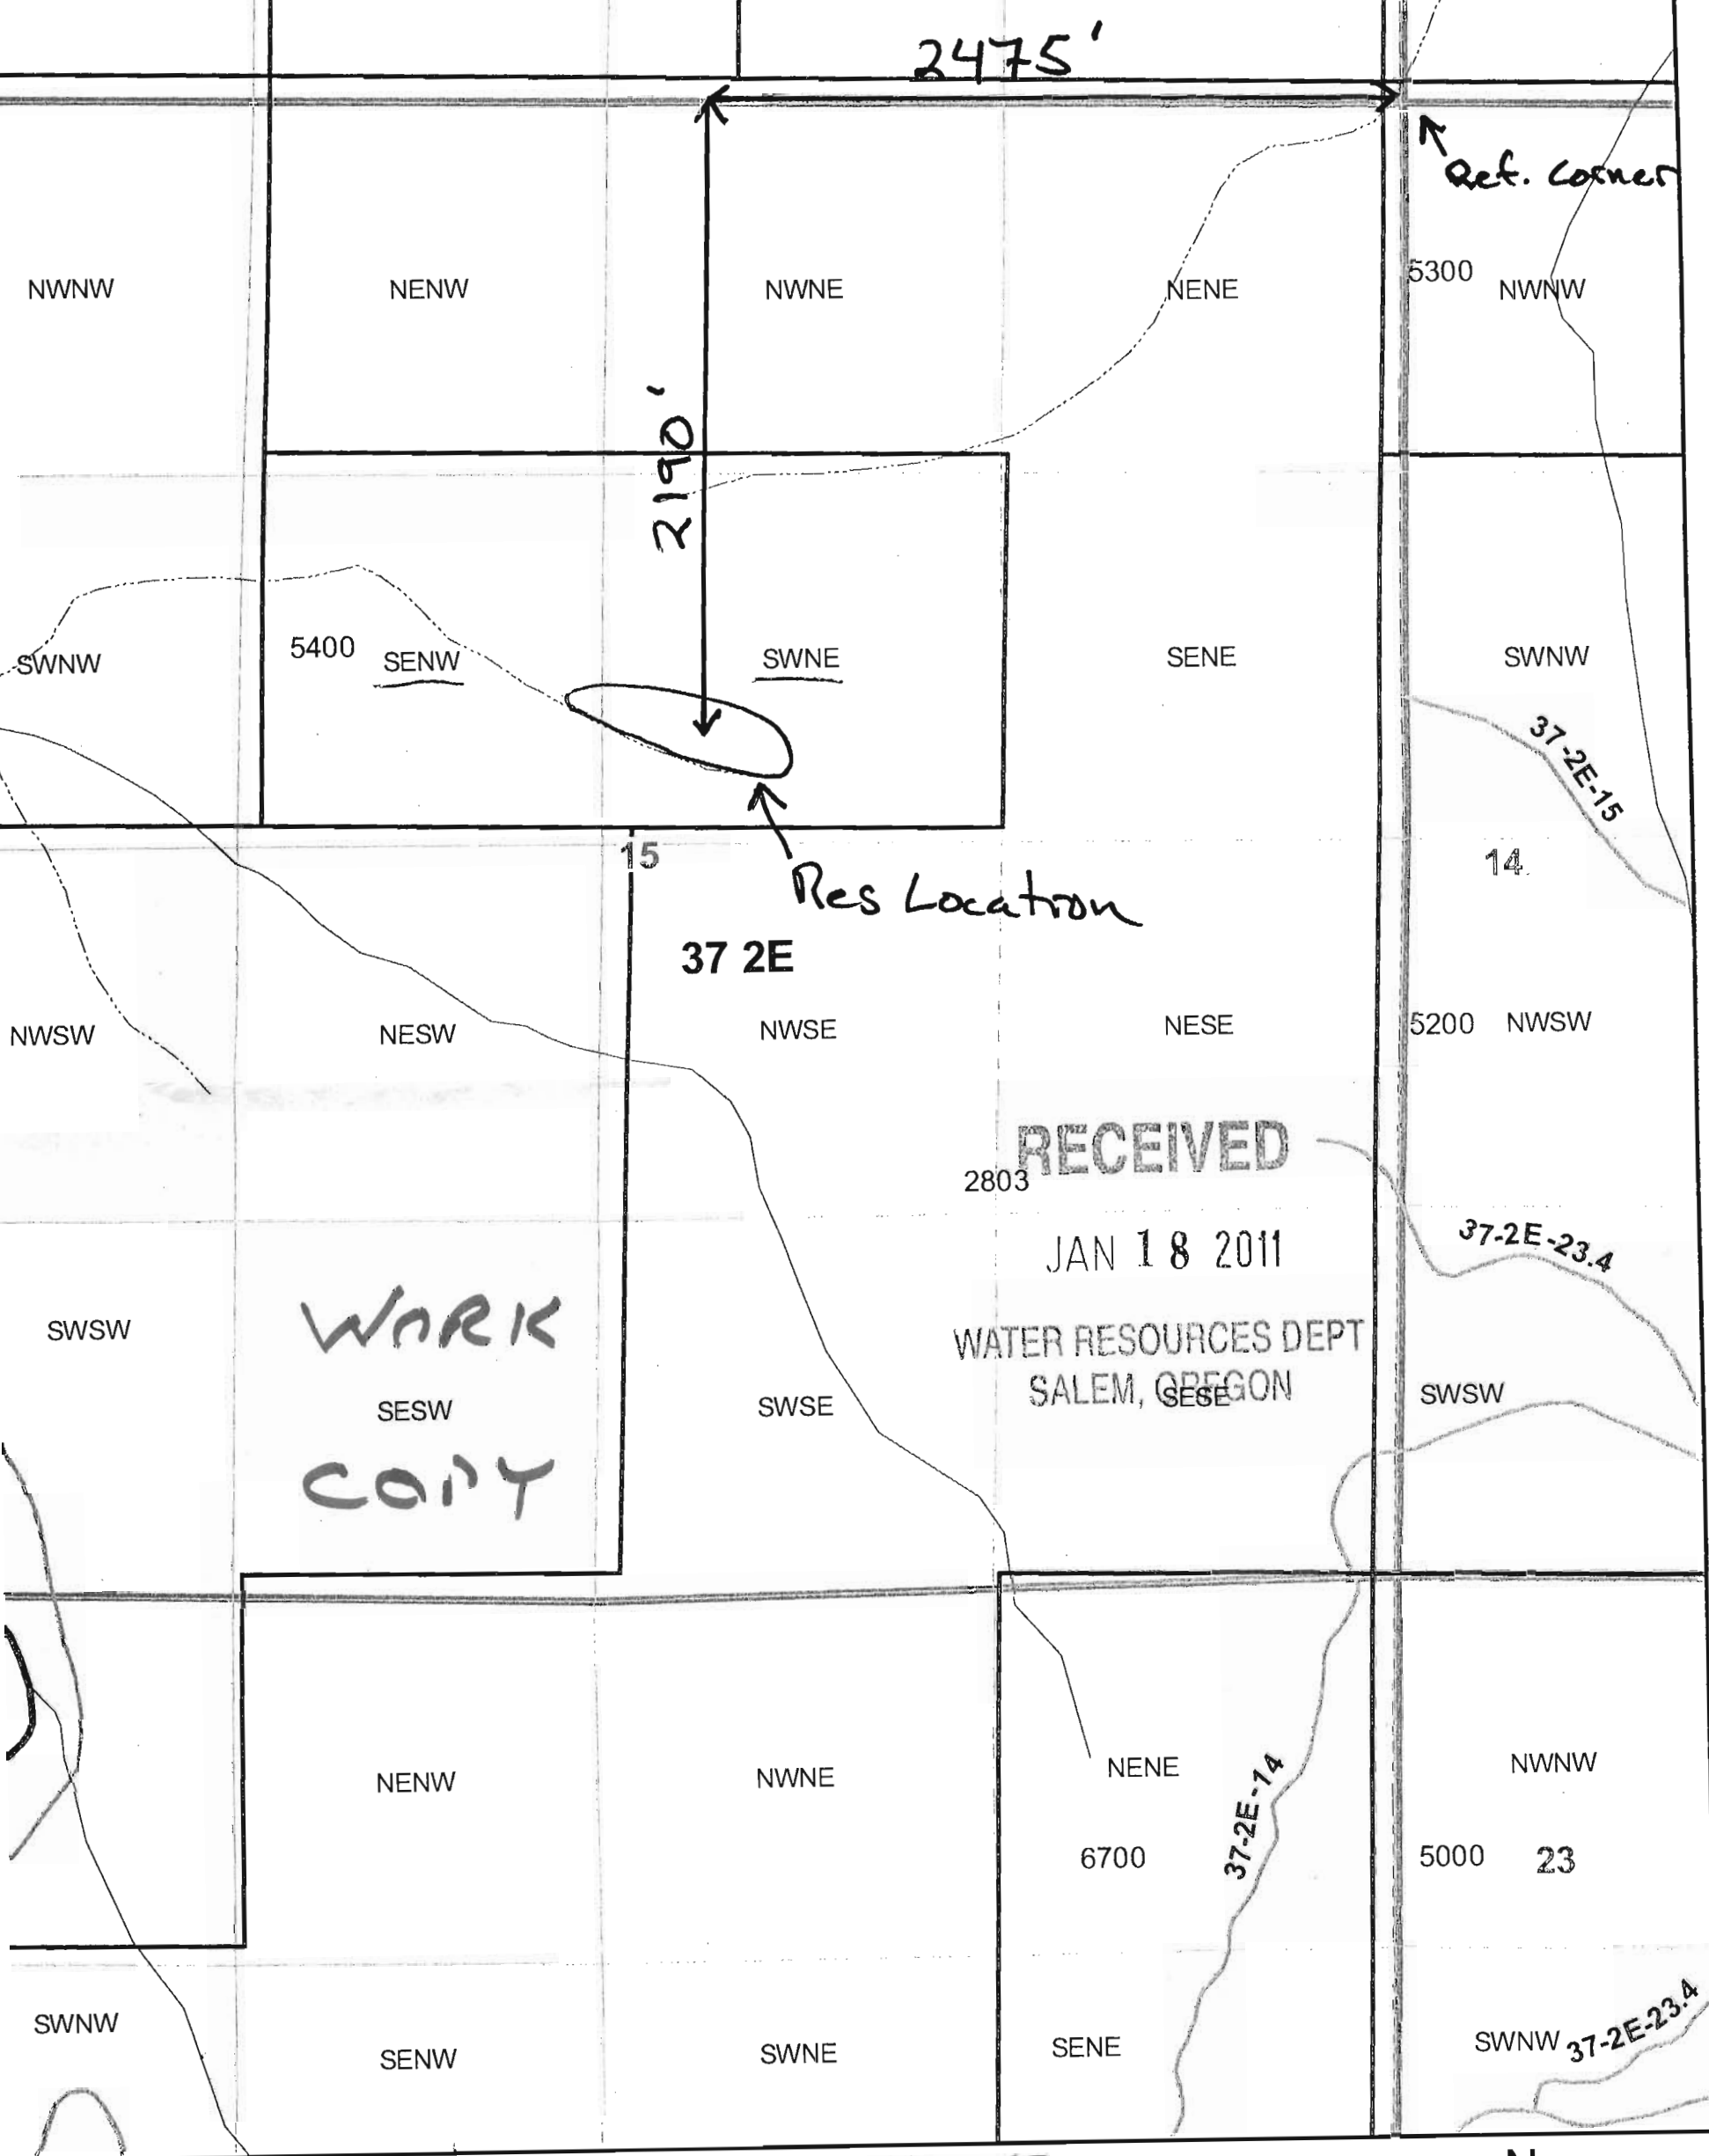

SCALED TO
RETREAT
CORRECT
SCALE BAR

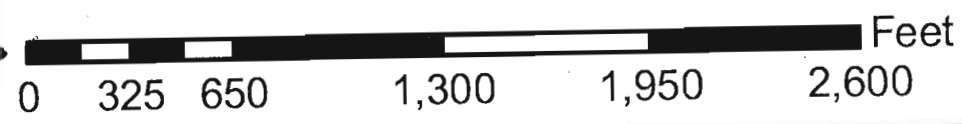

287602