# Horseshoe Rim Reservoir
# T32S, R25E, Sec 16, SE1/4 SW1/4

RECEIVED
JAN 28 2011
WATER RESOURCES DEPT
SALEM, OREGON

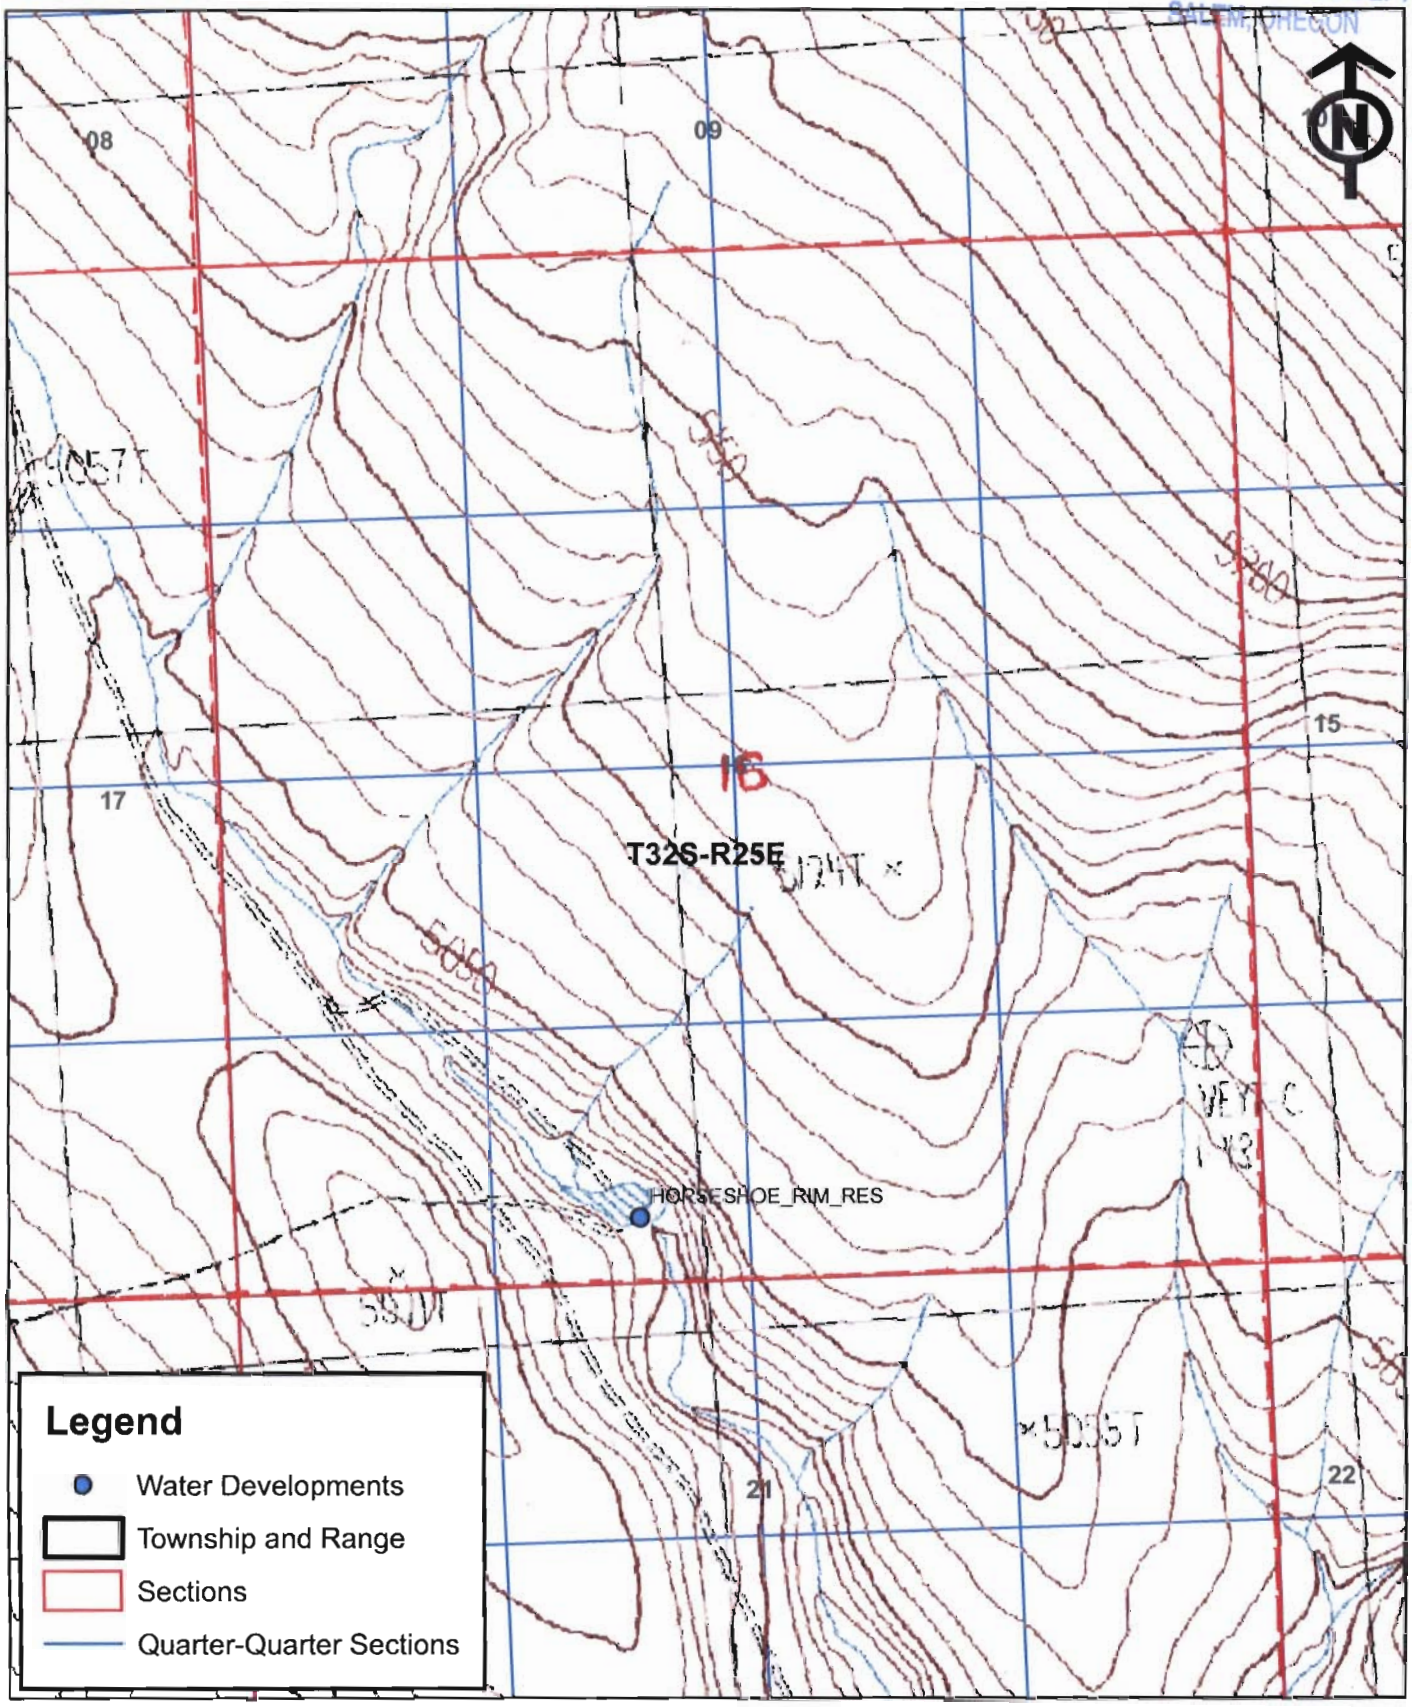


0 0.1 0.2 0.4 Miles

No warranty is made by the Bureau of Land Management as to the accuracy, reliability, or completeness of these data for individual or aggregate use with other data. Original data were compiled from various sources. This information may not meet National Map Accuracy Standards. This product was developed throught digital means and may be updated without notification.

R-87686

# Horseshoe Rim Reservoir
# T32S, R25E, Sec 16, SE1/4SW1/4
# Application #R87686

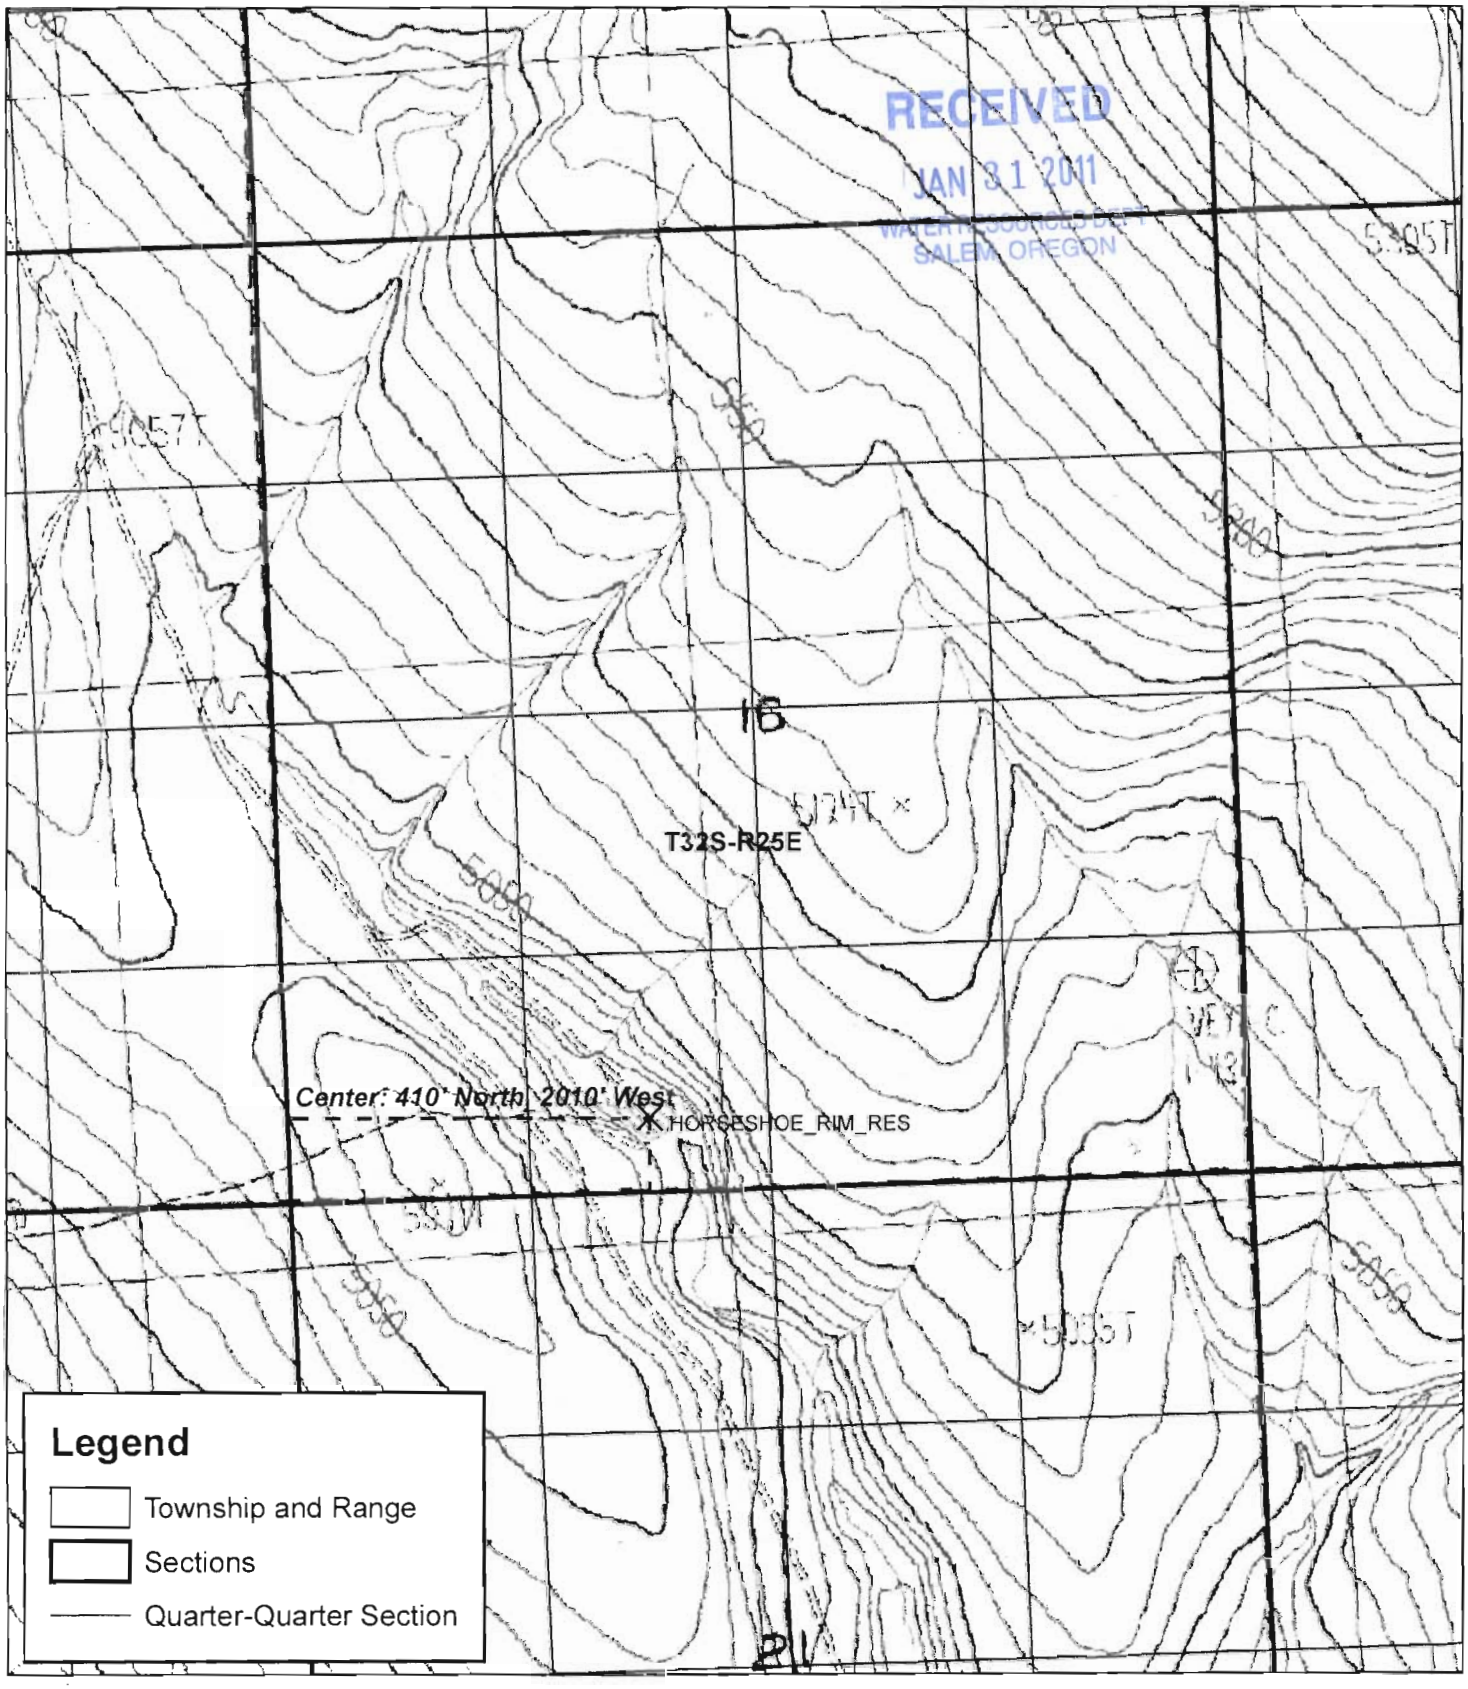


1 inch = 1,063 feet

R-87686

No warranty is made by the Bureau of Land Management as to the accuracy, reliability, or completeness of these data for individual or aggregate use with other data. Original data were compiled from various sources. This information may not meet National Map Accuracy Standards. This product was developed throught digital means and may be updated without notification.

RECEIVED
JAN 28 2011
WATER RESOURCES DEPT
SALEM, OREGON

# Horseshoe Rim Reservoir
## T32S, R25E, Sec 16, SE1/4 SW1/4

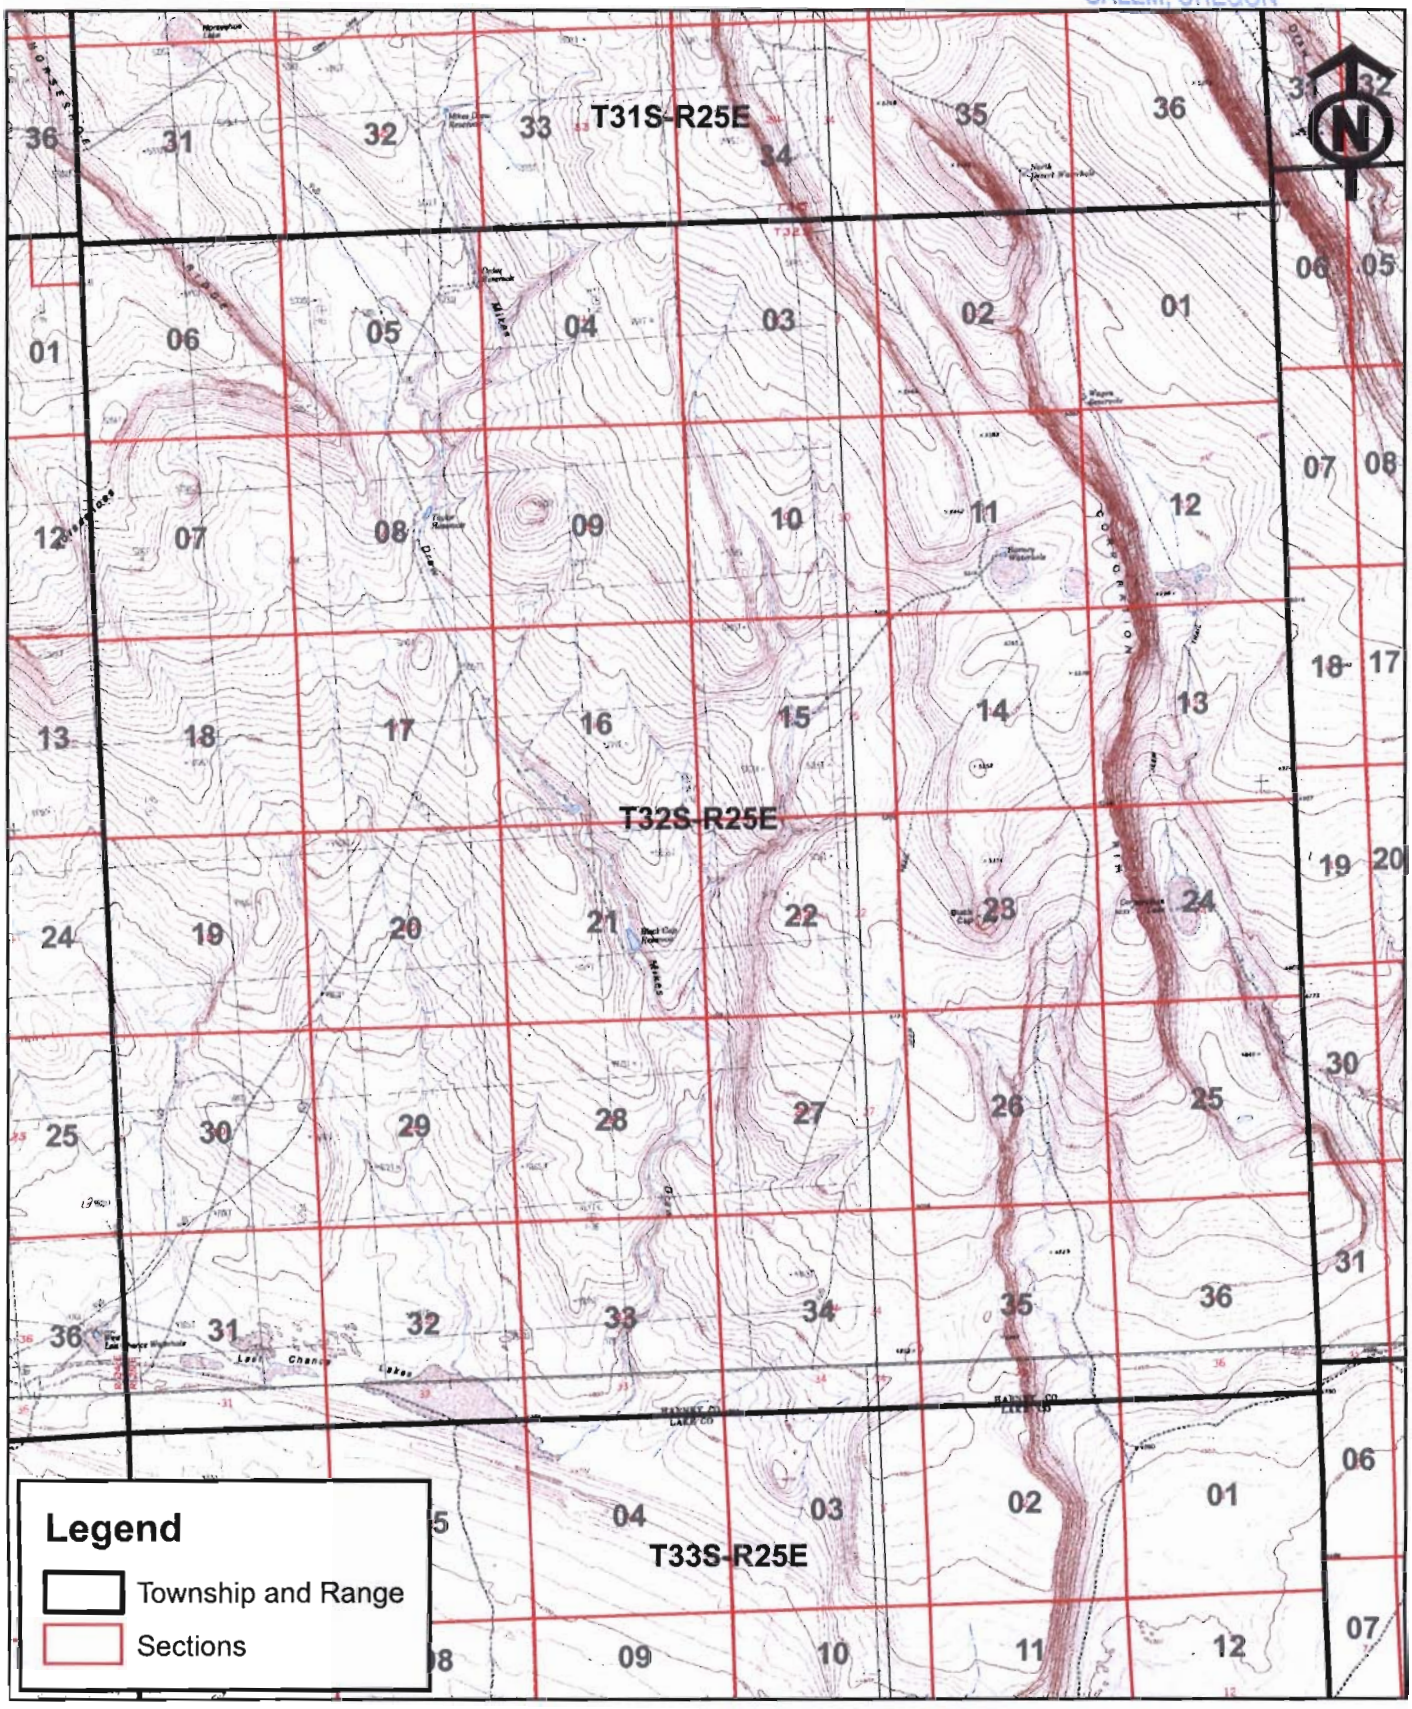


R-87686

No warranty is made by the Bureau of Land Management as to the accuracy, reliability, or completeness of these data for individual or aggregate use with other data. Original data were compiled from various sources. This information may not meet National Map Accuracy Standards. This product was developed throught digital means and may be updated without notification.

# Horseshoe Rim Reservoir
# T32S, R25E, Sec 16, SE1/4 SW1/4

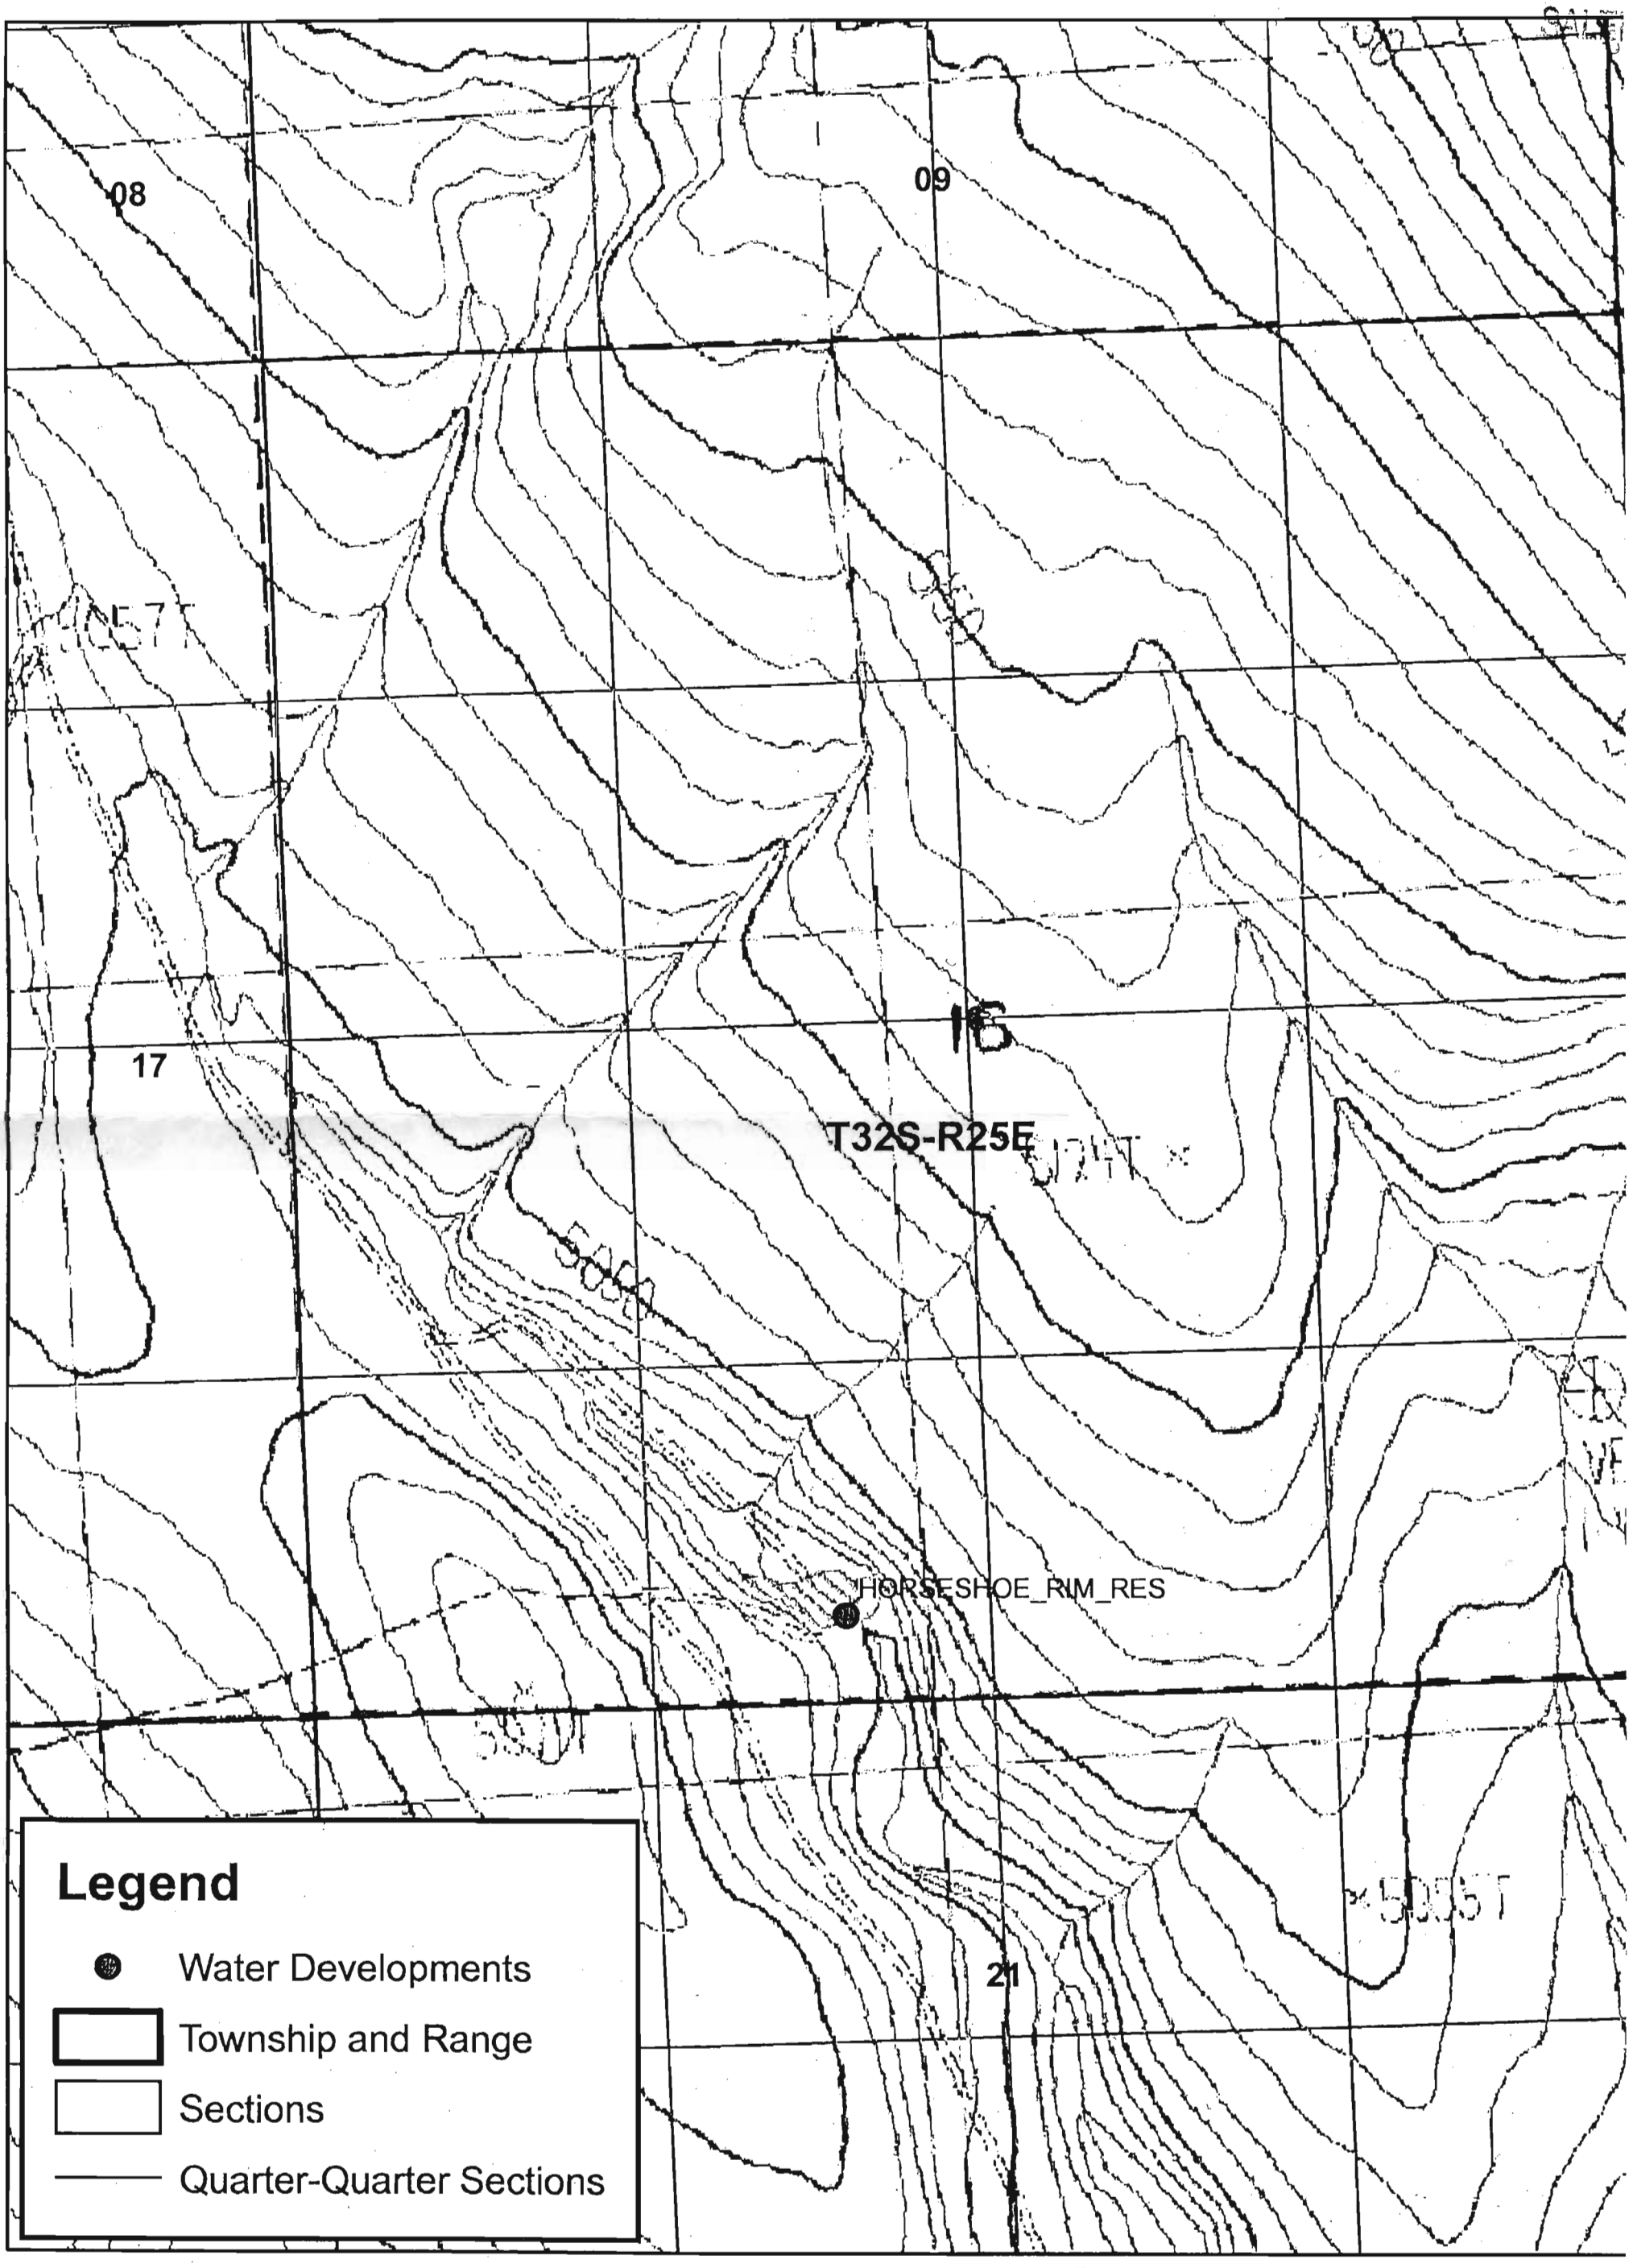


CORRECTED ADJUSTED
APPROX SCALE
1" = 600 FEET

No warranty is made by the Bureau of Land Management
reliability, or completeness of these data for individual or
with other data. Original data were compiled from variou
information may not meet National Map Accuracy Standa
was developed through digital means and may be upda