





COLUMBIA

RIVER

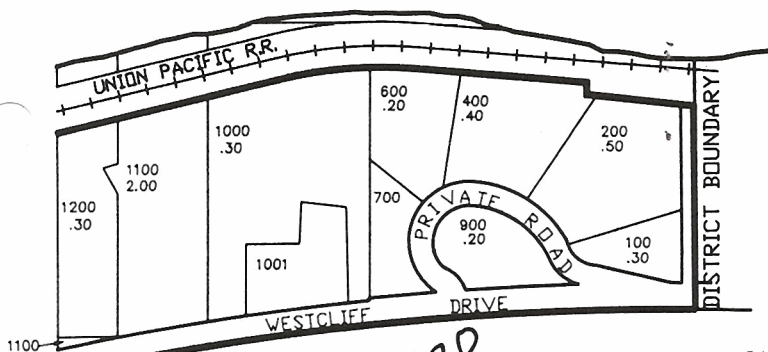

Primary

Supplemental

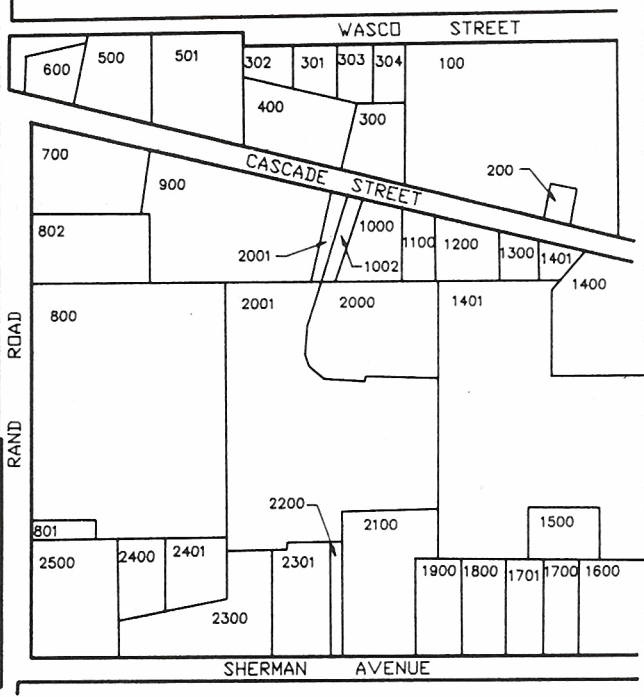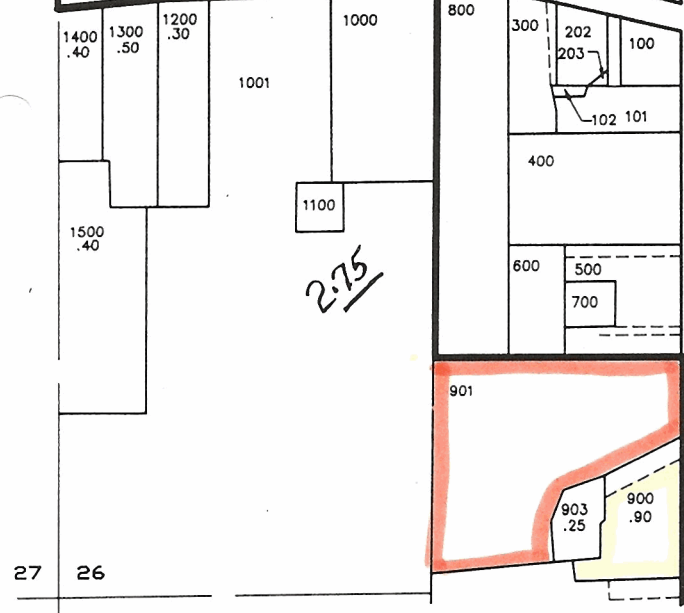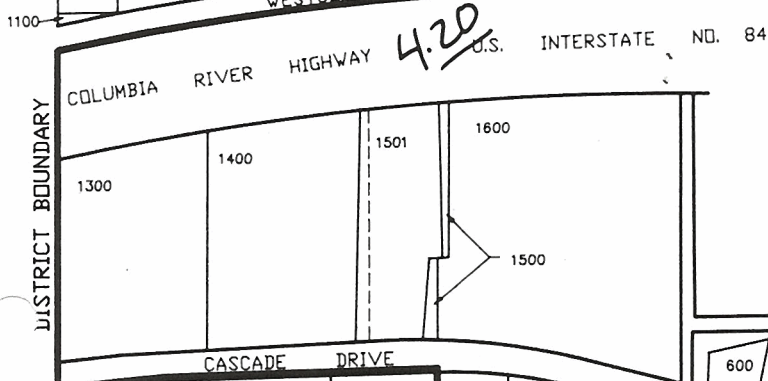

27 26

34 35

27 26

34 35 4.00  
4.00

Primary  
Supplements  
9.20  
1/1

