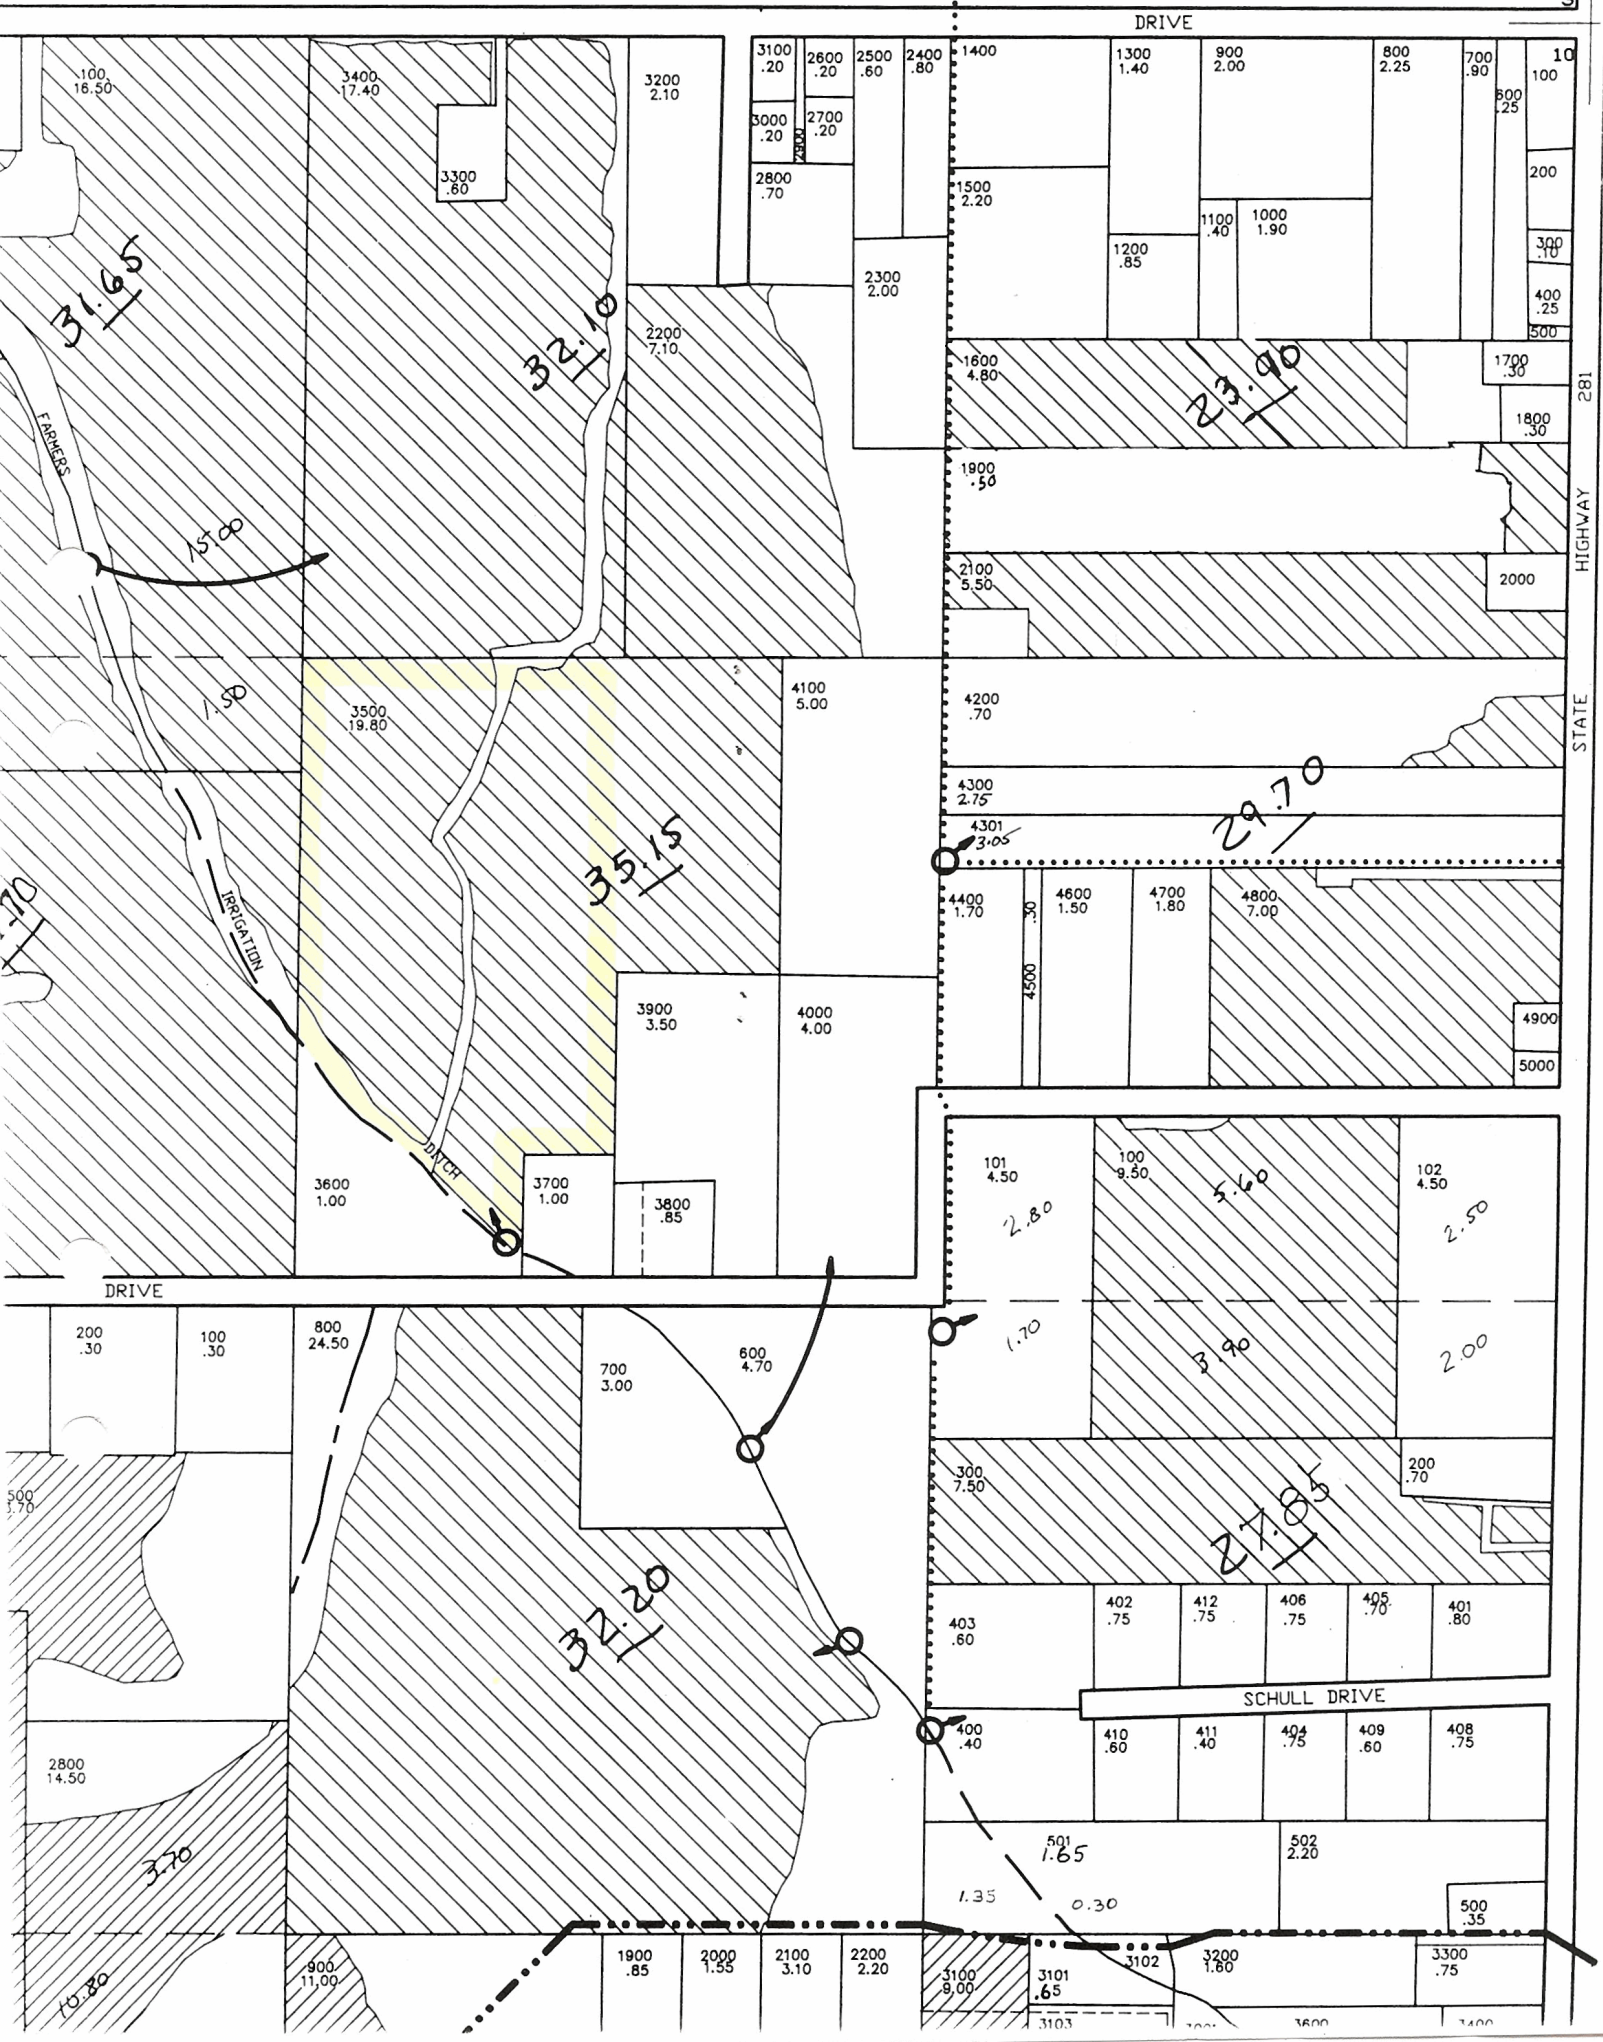
DRIVE
HIGHWAY 281
STATE
FARMERS
IRRIGATION
DITCH
DRIVE
SCHULL DRIVE
31.65
32.10
23.90
29.70
35.15
27.85
3.70
15.00
1.50
5.60
3.90
1.70
2.80
2.50
2.00
1.65
1.35
0.30
10.80
100 16.50
3400 17.40
3300 .60
3200 2.10
2200 7.10
3100 .20
2600 .20
2500 .60
2400 .80
3000 .20
2700 .20
2800 .70
2300 2.00
1400
1300 1.40
900 2.00
800 2.25
700 .90
600 .25
1500 2.20
1100 .40
1000 1.90
1200 .85
10
100
200
300 .10
400 .25
500
1600 4.80
1700 .30
1800 .30
1900 .50
2100 5.50
2000
4100 5.00
4200 .70
4300 2.75
4301 3.05
4400 1.70
4500
4600 1.50
4700 1.80
4800 7.00
4900
5000
3500 19.80
3900 3.50
4000 4.00
3600 1.00
3700 1.00
3800 .85
101 4.50
100 9.50
102 4.50
200 .30
100 .30
800 24.50
700 3.00
600 4.70
300 7.50
200 .70
403 .60
402 .75
412 .75
406 .75
405 .70
401 .80
400 .40
410 .60
411 .40
404 .75
409 .60
408 .75
2800 14.50
501 1.65
502 2.20
500 .35
900 11.00
1900 .85
2000 1.55
2100 3.10
2200 2.20
3100 9.00
3101 .65
3102
3200 1.60
3300 .75
3103