


BARRETT

HAYS DRIVE

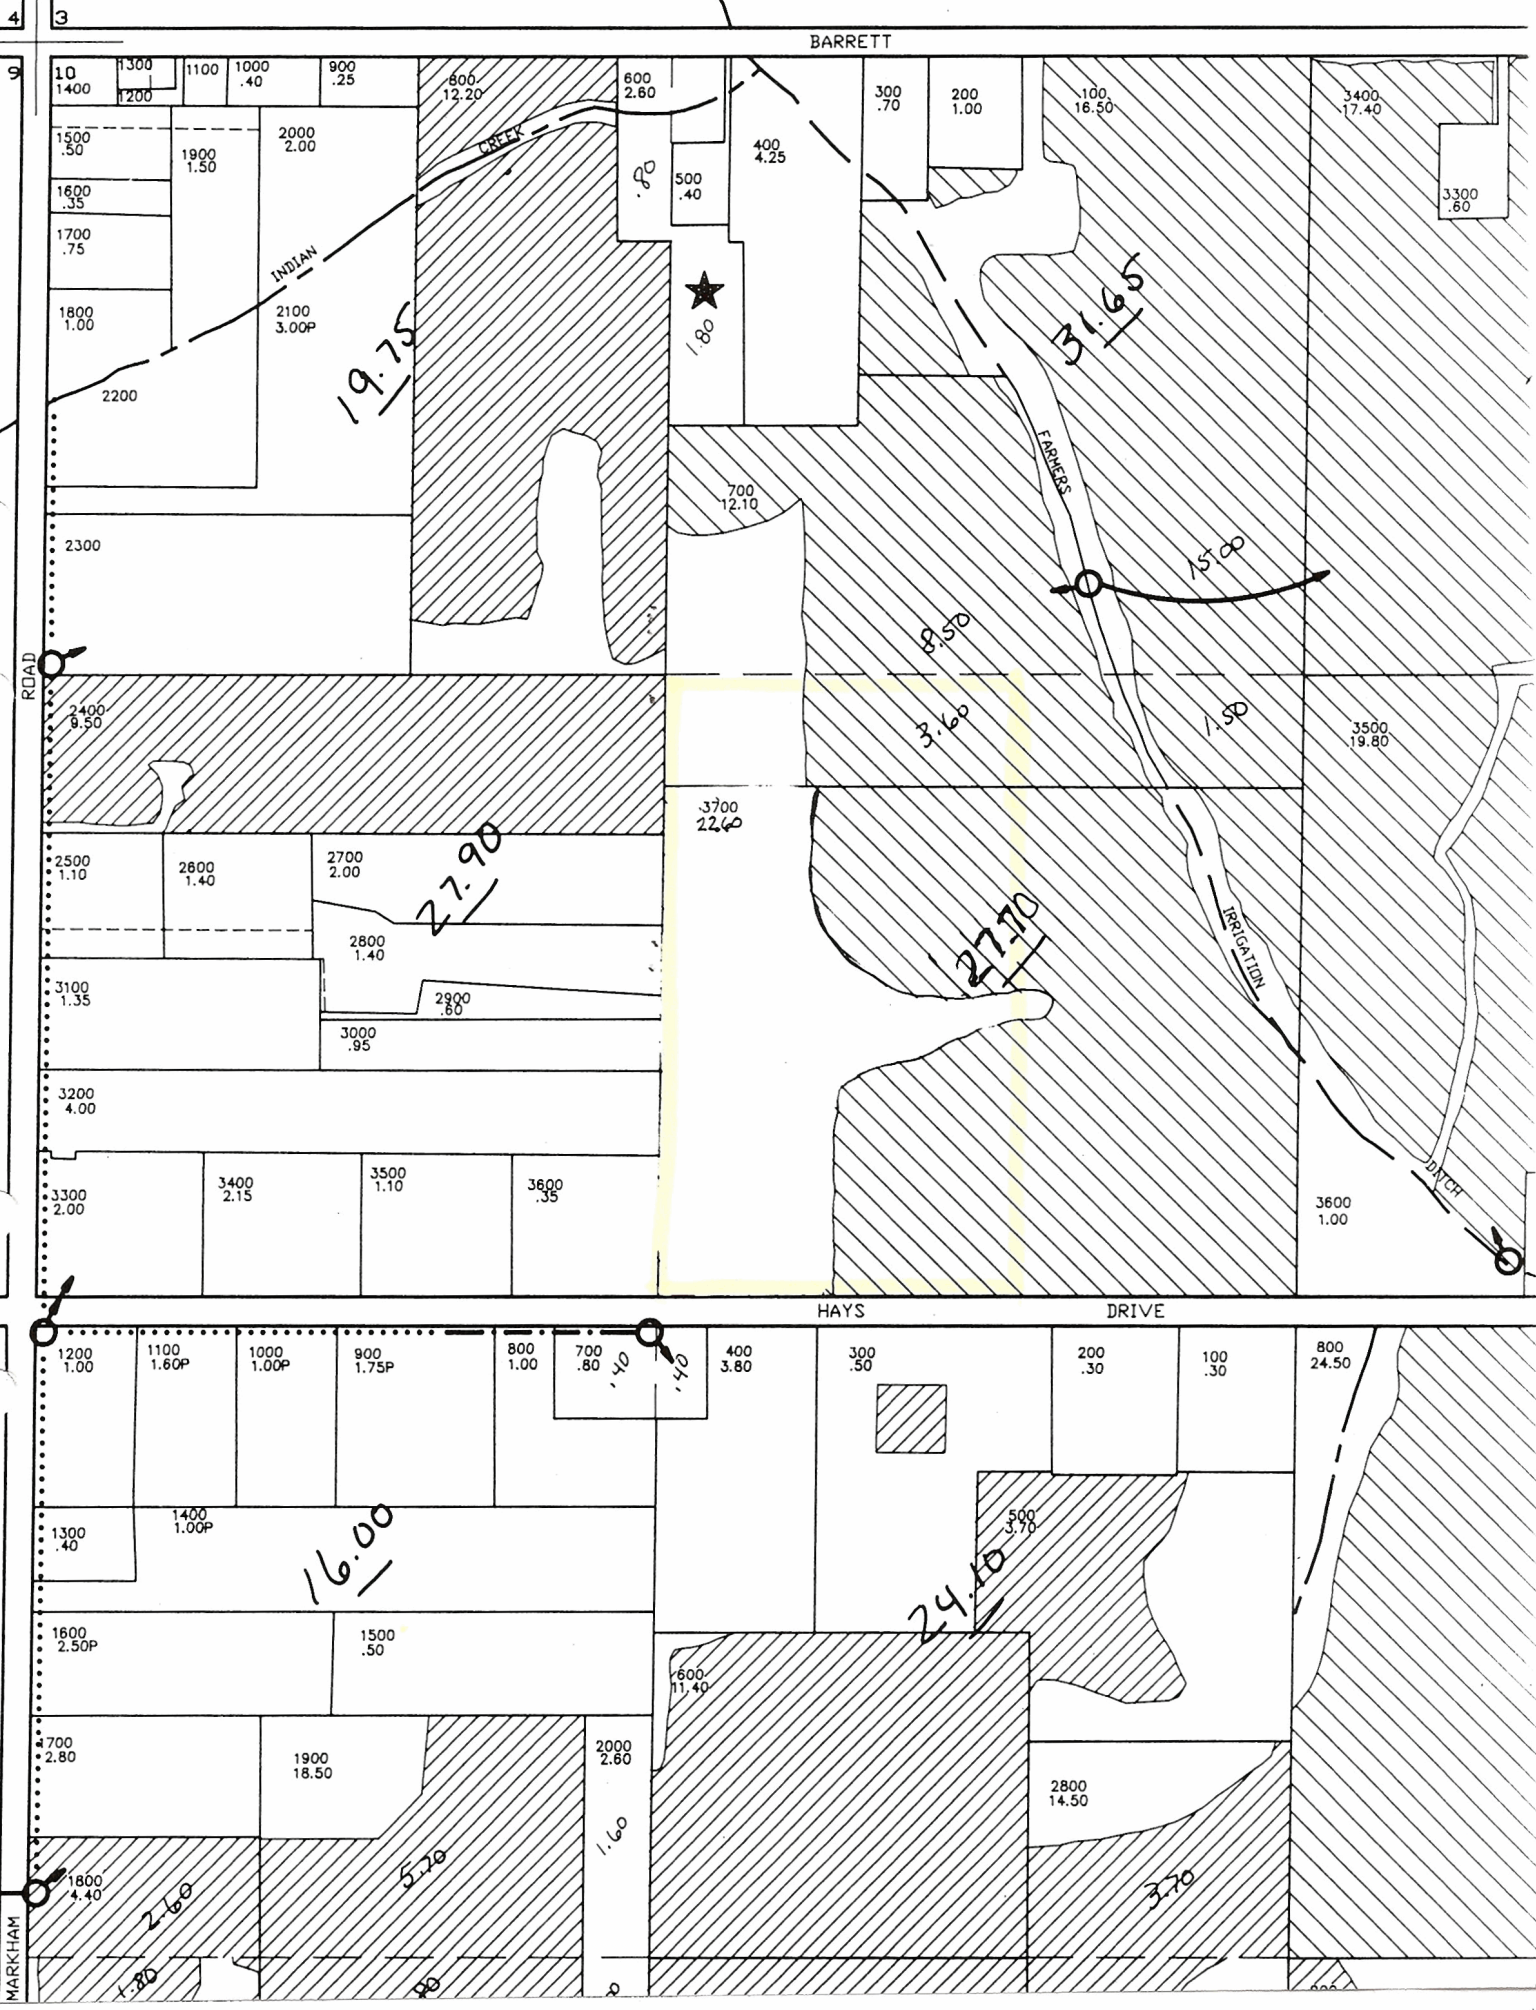

19.75

31.65

27.90

27.70

16.00

24.10

2.60

5.70

1.60

3.70

ROAD

INDIAN

CREEK

FABERS

IRIGAITON

DITCH

MARKHAM