Permit. 4436

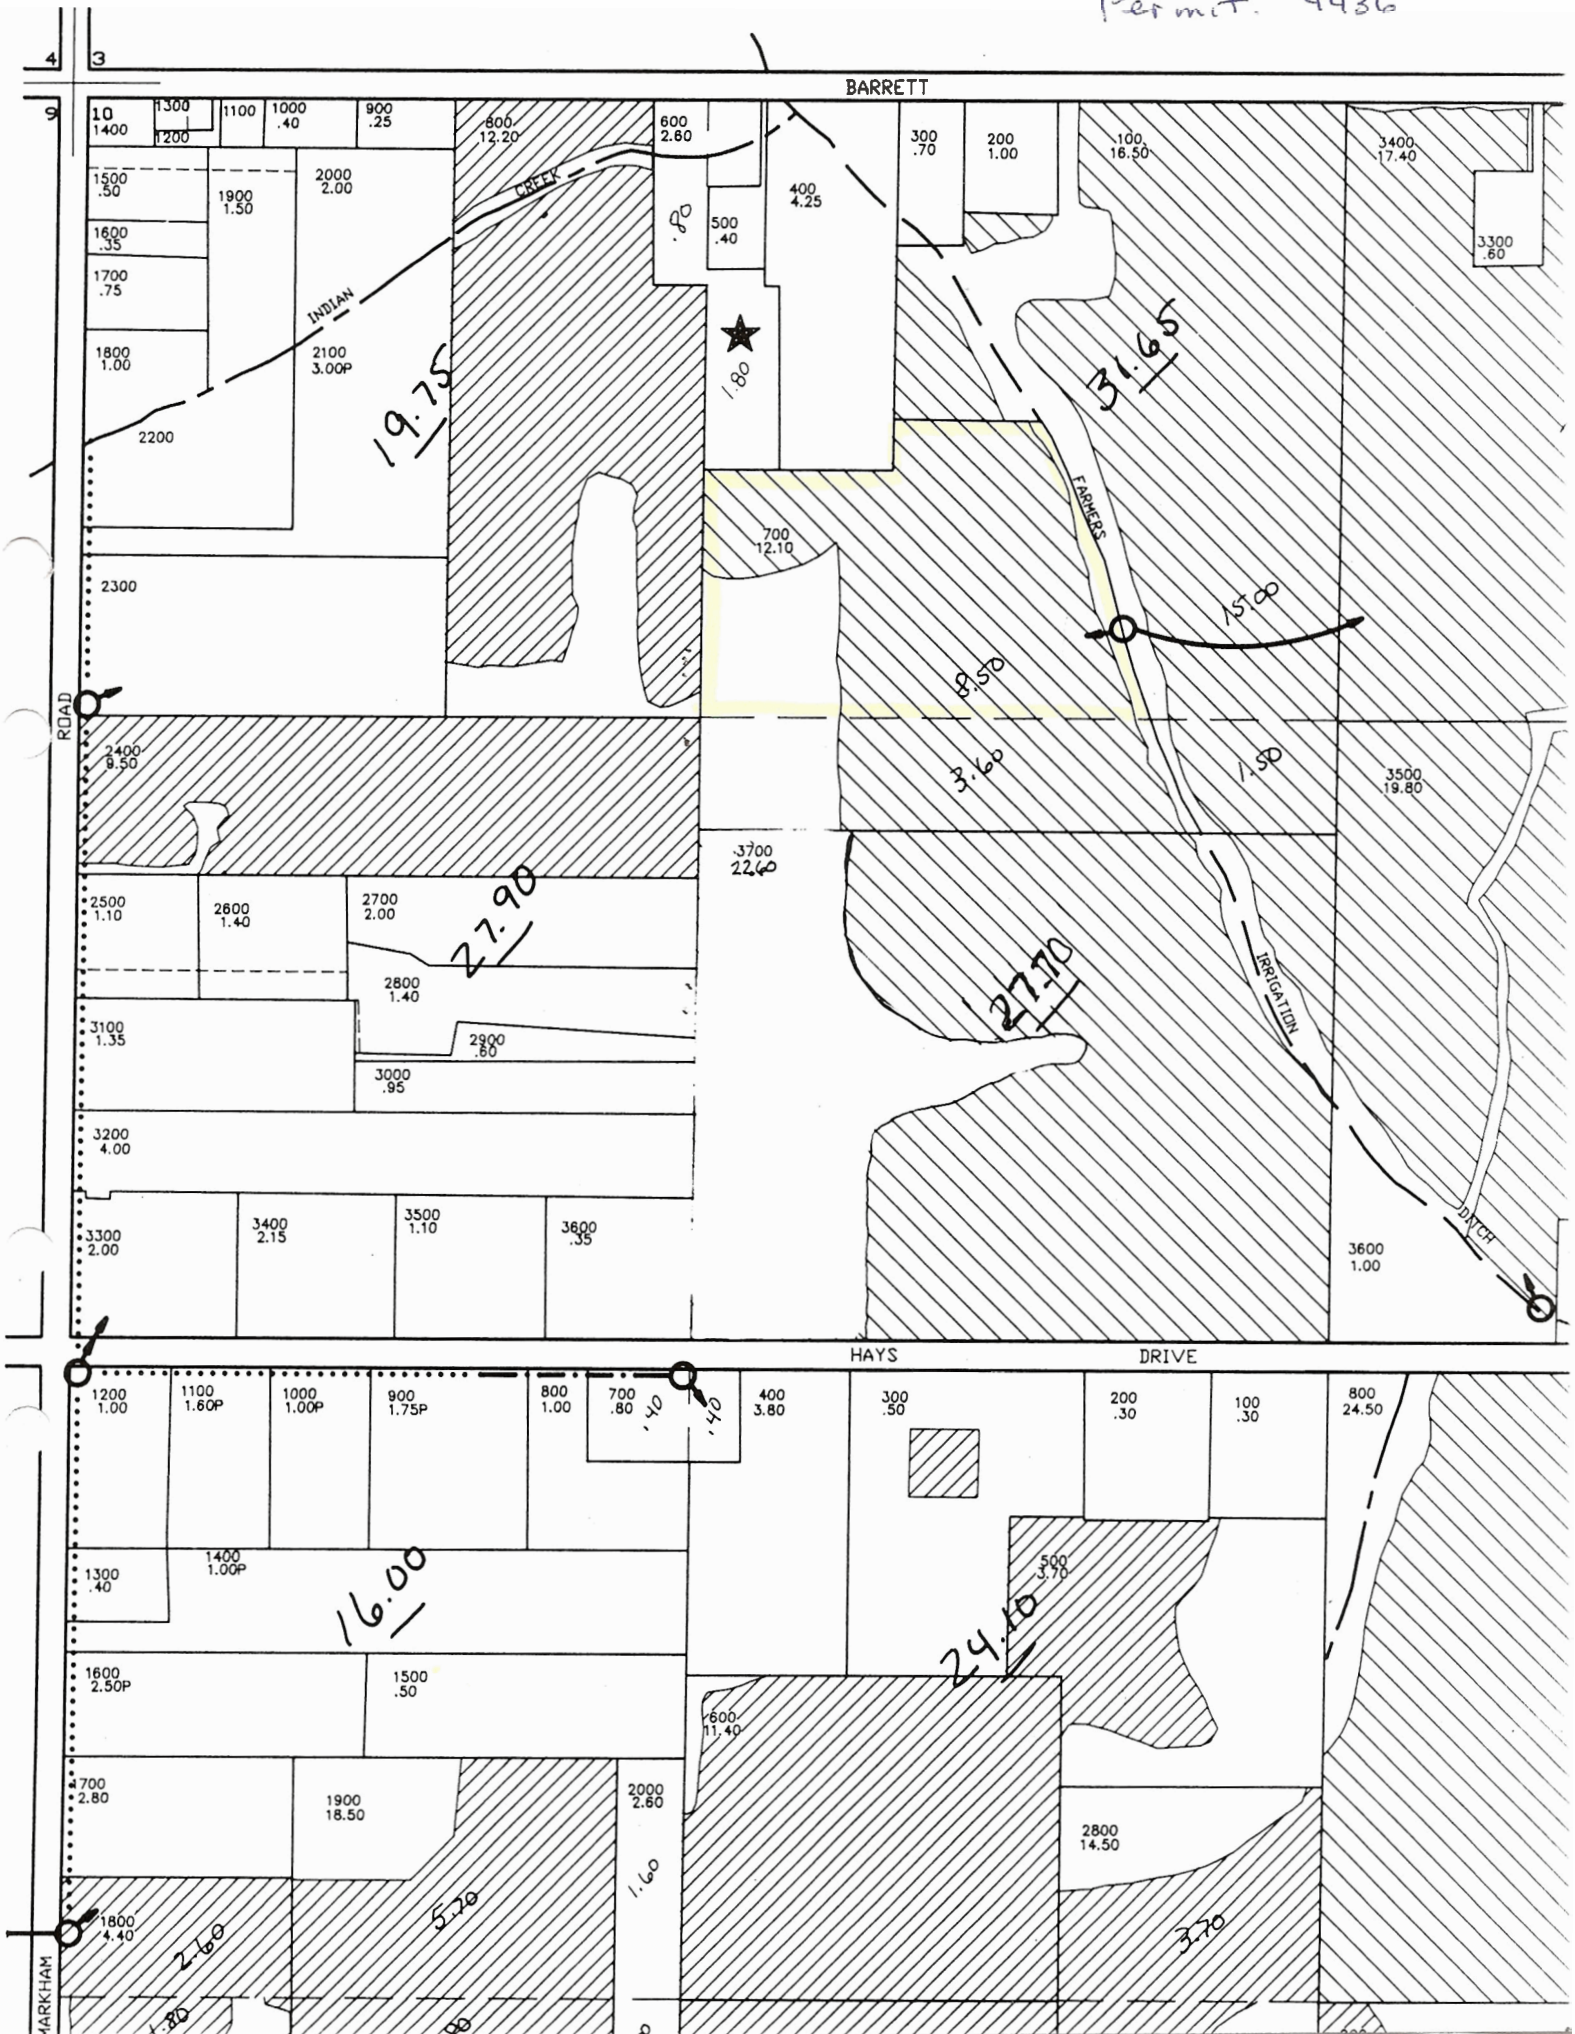
4
3
BARRETT
9
10
1400
1300
1200
1100
1000
.40
900
.25
800
12.20
600
2.60
300
.70
200
1.00
100
16.50
3400
17.40
1500
.50
1900
1.50
2000
2.00
CREEK
.80
500
.40
400
4.25
3300
.60
1600
.35
1700
.75
INDIAN
1800
1.00
2100
3.00P
2200
19.75
1.80
31.65
FARMERS
700
12.10
2300
ROAD
2400
9.50
8.50
3.60
1.50
3500
19.80
3700
22.60
2500
1.10
2600
1.40
2700
2.00
27.90
2800
1.40
3100
1.35
2900
.80
3000
.95
3200
4.00
3300
2.00
3400
2.15
3500
1.10
3600
.35
IRRIGATION
DITCH
3600
1.00
HAYS
DRIVE
1200
1.00
1100
1.60P
1000
1.00P
900
1.75P
800
1.00
700
.80
.40
.40
400
3.80
300
.50
200
.30
100
.30
800
24.50
1300
.40
1400
1.00P
16.00
500
3.70
24.40
1600
2.50P
1500
.50
600
11.40
1700
2.80
1900
18.50
2000
2.60
2800
14.50
1.60
1800
4.40
2.60
5.70
3.70
MARKHAM