


Permit 3720

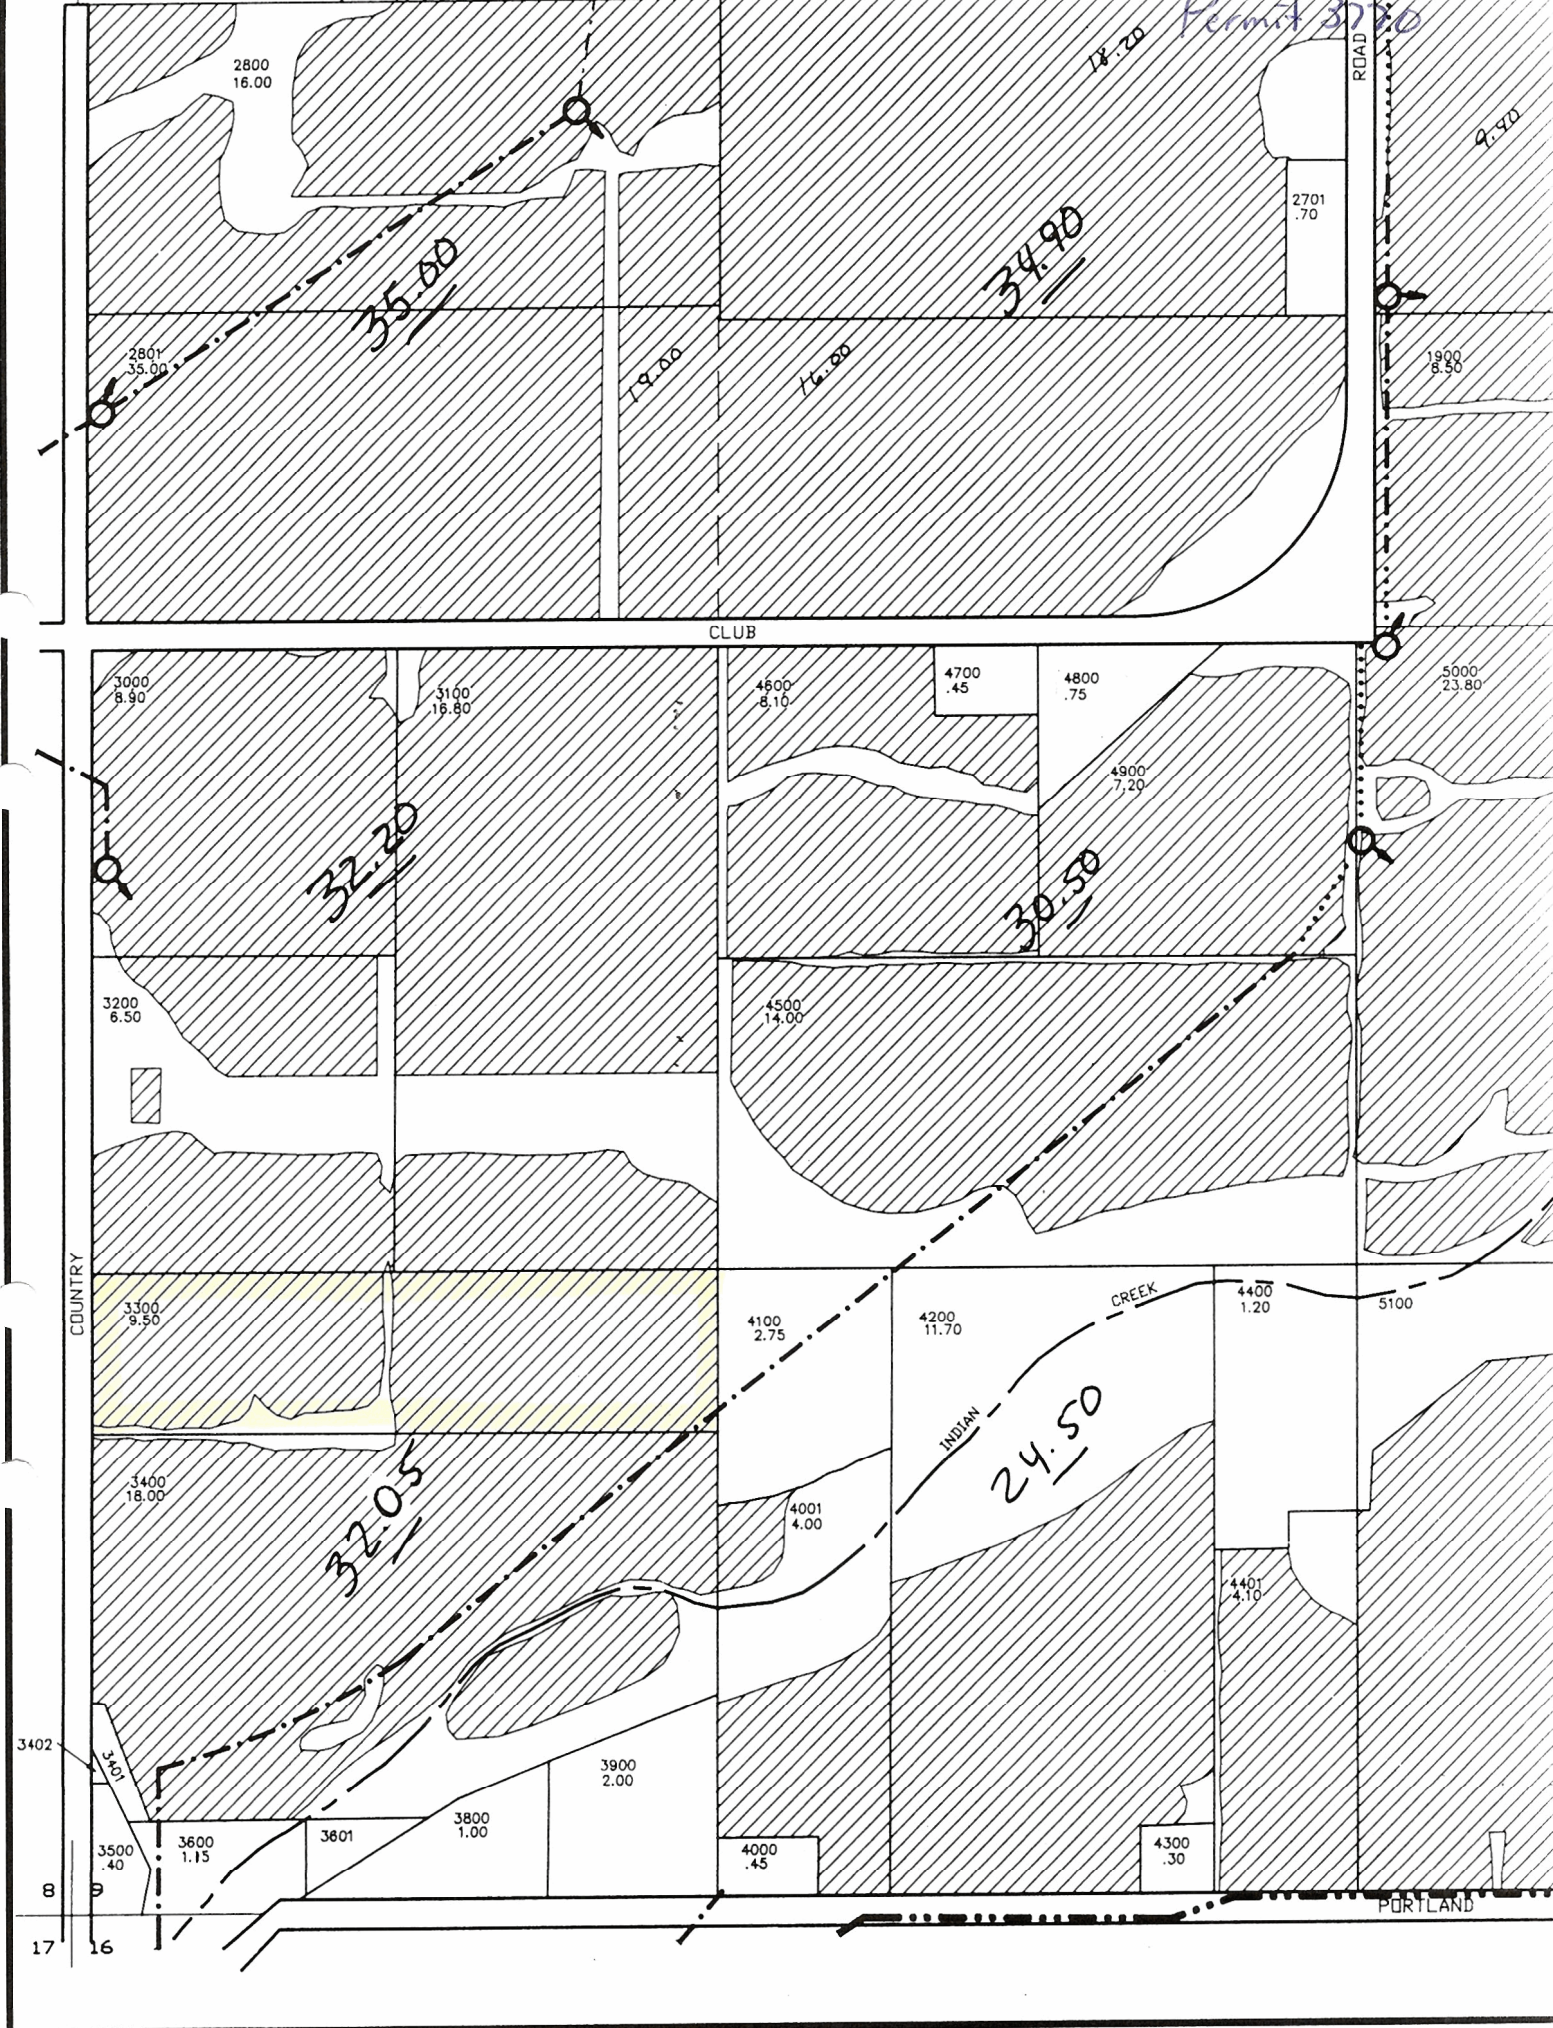

CLUB

COUNTRY

PORTLAND

3402

8

17

16

9

32.05

24.50

32.20

30.50

35.00

34.90

18.20

9.90

1900
8.50

5000
23.80

5100

4401
4.10

4400
1.20

4200
11.70

4000
.45

4001
4.00

4500
14.00

4600
8.10

4700
.45

4800
.75

4900
7.20

3800
1.00

3900
2.00

3601

3500
.40

3600
1.15

3400
18.00

3300

3200
6.50

3000
8.90

3100
16.80

2800
16.00

2801
35.00

2701
70