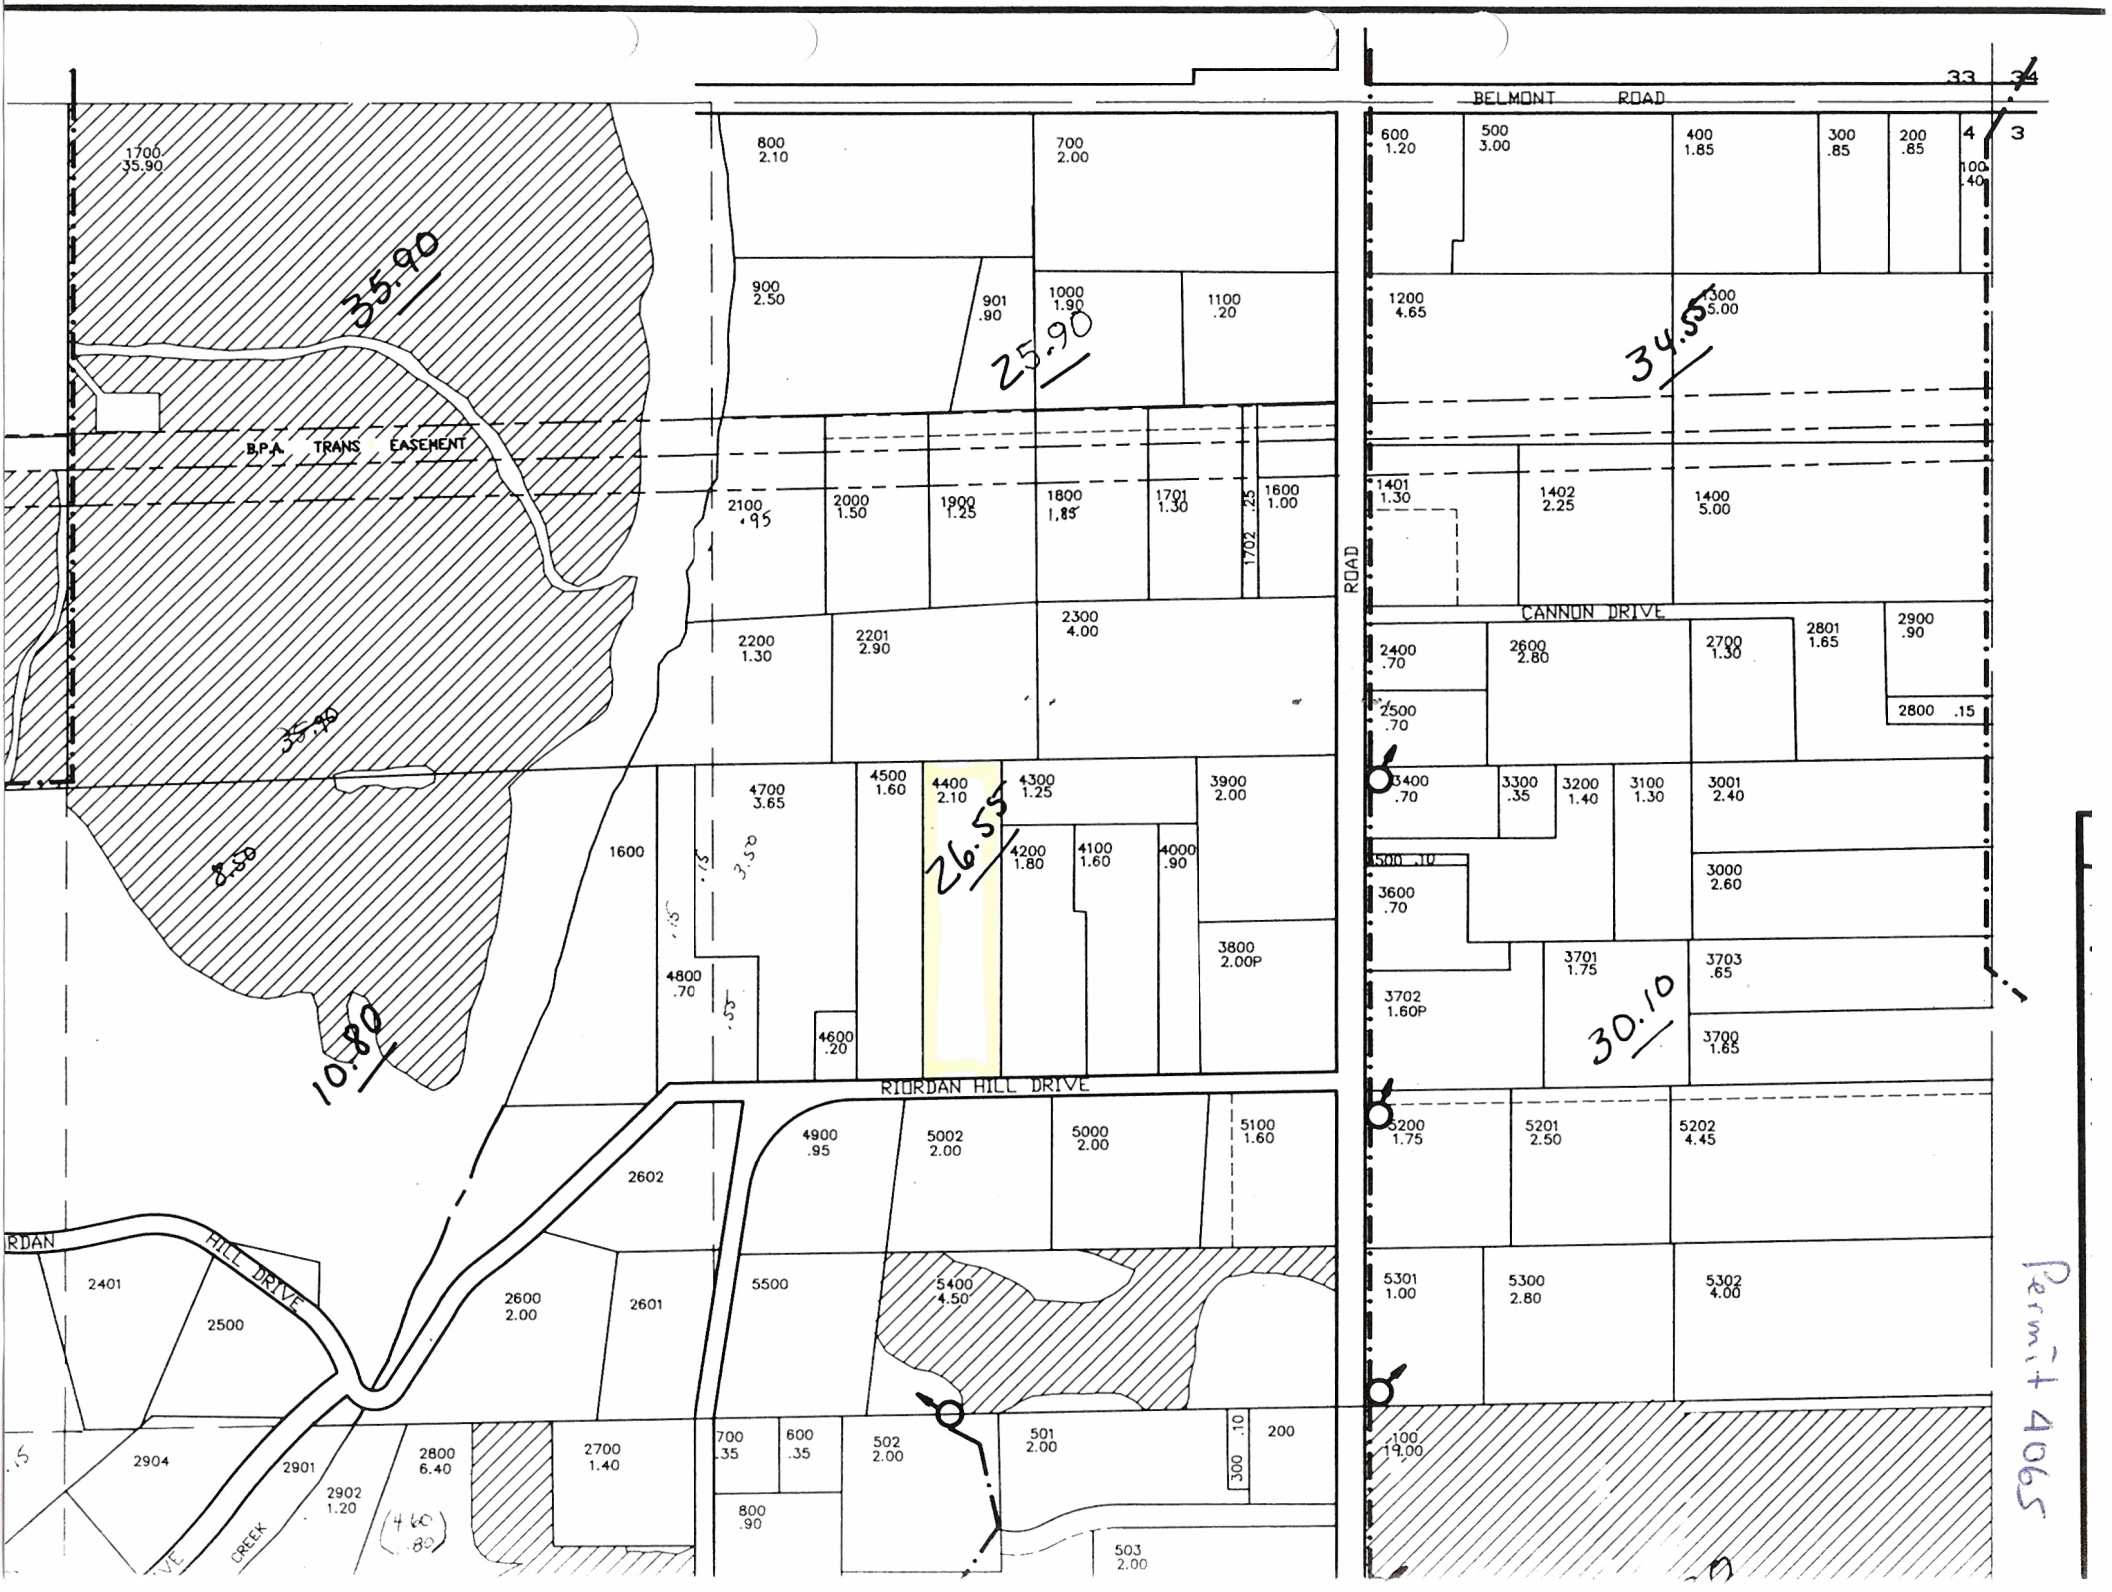
BELMONT ROAD
33
34
4
3
B.P.A. TRANS EASEMENT
35.90
35.90
8.50
10.80
25.90
26.55
34.55
30.10
RIORDAN HILL DRIVE
CANNON DRIVE
ROAD
CREEK
1700 35.90
800 2.10
700 2.00
900 2.50
901 .90
1000 1.90
1100 .20
2100 .95
2000 1.50
1900 1.25
1800 1.85
1701 1.30
1702 .25
1600 1.00
2200 1.30
2201 2.90
2300 4.00
4700 3.65
4500 1.60
4400 2.10
4300 1.25
3900 2.00
1600
4200 1.80
4100 1.60
4000 .90
3800 2.00P
4800 .70
4600 .20
3.50
.5
.5
.5
600 1.20
500 3.00
400 1.85
300 .85
200 .85
100 .40
1200 4.65
1300 5.00
1401 1.30
1402 2.25
1400 5.00
2400 .70
2600 2.80
2700 1.30
2801 1.65
2900 .90
2500 .70
2800 .15
3400 .70
3300 .35
3200 1.40
3100 1.30
3001 2.40
3000 2.60
3600 .70
3701 1.75
3703 .65
3702 1.60P
3700 1.65
5200 1.75
5201 2.50
5202 4.45
5301 1.00
5300 2.80
5302 4.00
100 19.00
4900 .95
5002 2.00
5000 2.00
5100 1.60
2602
2401
2500
2600 2.00
2601
5500
5400 4.50
2904
2901
2902 1.20
2800 6.40
2700 1.40
700 .35
600 .35
800 .90
502 2.00
501 2.00
300 .10
200
503 2.00
(460 .80)

Permit 4065