


SECTION 19 T.3S. R.1E. W.M.  
CLACKAMAS COUNTY

3 1E 19  
& INDEX

This map was prepared for  
assessment purpose only.

RIVER PROJECTION  
STATE HWY. DEPT.  
GREENWAY PHOTOS  
APRIL, 1967

SEE MAP 3 1E-18

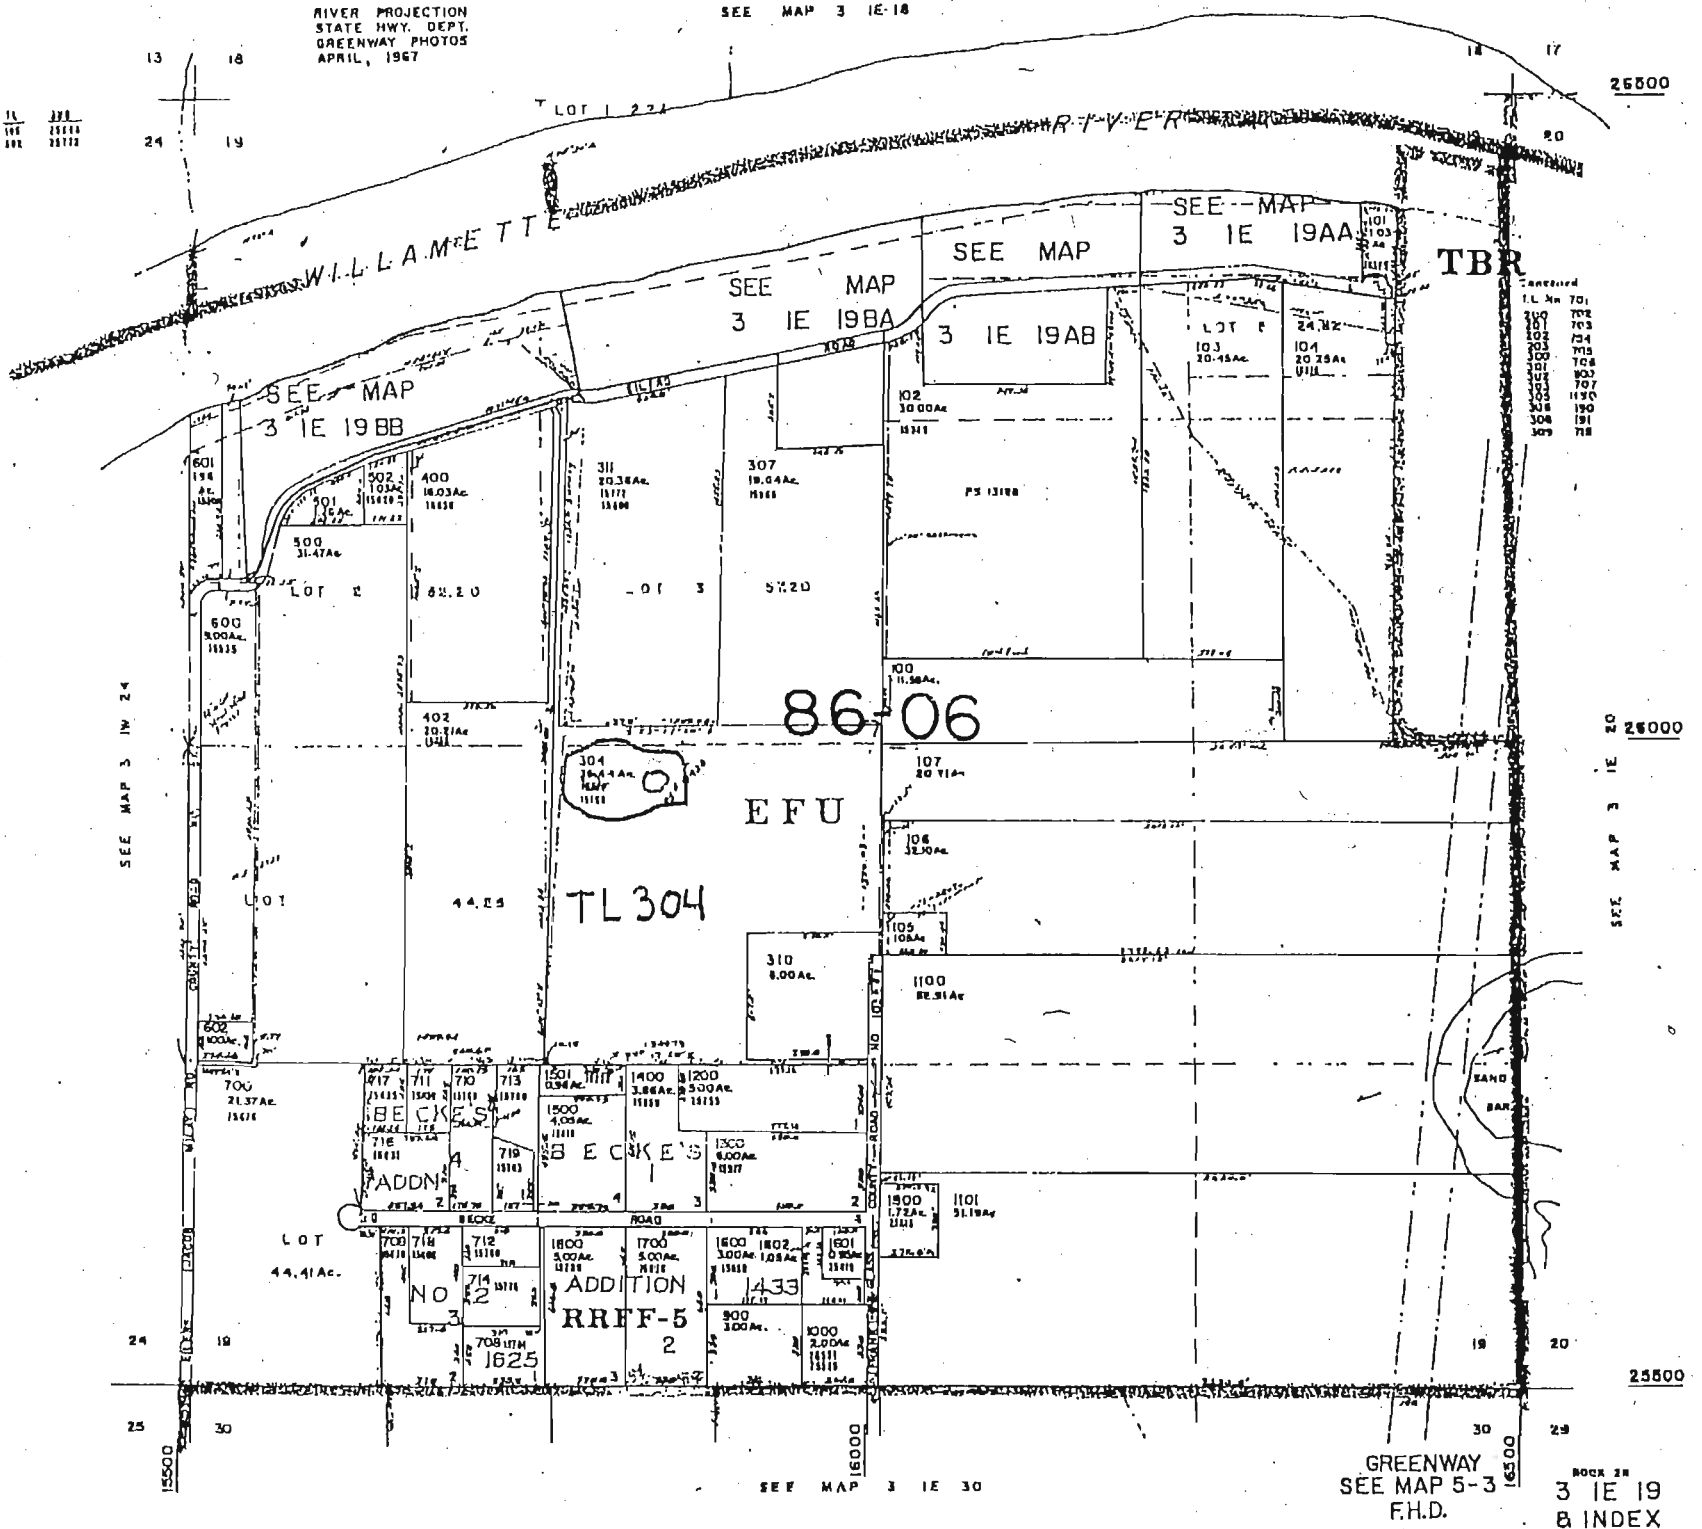

Location:

3 S., 1 E., Section 19 Tax Lot 304

POD is 238' South and 792' West from  
Center of Section 19 in the NE 1/4, of the SW 1/4

Scale: 1 inch = 1320 feet

*WORK COPY*

**RECEIVED**

**N**

MAR 23 2011

WATER RESOURCES DI  
SALEM, OREGON.

*R-87708*